

10/26/18. Approved online permit. H.O.

Menu Save Reset Cancel Help

Record Detail \* (This section is required.)

Permit Type	Permit Number	Opened Date
Building/Residential/Misc/Deck	B18002186	06/25/2018
Description of Work		
SFD/ CONSTRUCT 13' X 16' IRREGULAR SHAPED OPEN DECK WITH STEPS		

check spelling

Address \* (This section is required.)

Search Reset Clear Get Parcel & Owner

Street #	Street Name	Street Type	
5111	HONEY LOCUST	CT	
Unit Type	Unit #	X Coordinate	Y Coordinate
--Select--		-76.94846	39.23883
City	State	Zip Code	Primary
FELICOTT CITY	MD	21042	Yes

Parcel \* (This section is required.)

Search Reset Clear Get Address & Owner

GIS ID *	Parcel	Parcel Area	Land Value	Improved Value	Exemption Value	Plan Area
1101217	49	38239	338800	1136700	797900	RURAL
Legal Description						
IMPSLOT 44 38,239 SQ[ 5111 HONEY LOCUST CT[ WALNUT CREEK PHASE 2						

check spelling

Block	Lot	Census Tract	Council Dist	Supervisor Dist	Map #	DAP Zone	Primary
	44	605101	5				Yes
Plan Area	State Tax Id	Subdivision Name					
	1405595185	Walnut Creek					
Section	Area	Tax Map					
		28					
Grid	Zoning District	ADC Map					
28-11	RC-DFQ	4933-12					
SDP No.	Final Plan No.	WP File No.					
	F-07-076						
Record Plat No.	WS Contract No.	FDP No.					
22227-2224							
Owner Occupied	Year Built	Historic District					
<input type="radio"/> Yes <input type="radio"/> No	2014	<input type="radio"/> Yes <input checked="" type="radio"/> No					
Historic District Registry No.	Stat Area	Flood Plain					
	5-02A	<input type="radio"/> Yes <input checked="" type="radio"/> No					
Building No							

Owner \* (This section is required.)

Search Reset Clear

Name *		
SIMO DAGOBERT		
Address Line 1		
5111 HONEY LOCUST CT		
Address Line 2		
Address Line 3		
Mail City	Mail State	Mail Zip Code

ELLICOTT CITY	MD	21042
Phone	Primary	
301-385-6303	Yes	
E-mail		
Cell Number	Fax Number	

Professionals (This section is not required.)

Search Reset Clear

License # *	Business Name		
08010020247	PRO BUILT CONSTRUCTION		
License Type *	First Name	Middle Name	Last Name
MHIC Ind	EDWARD		PACYLOWSKI
Primary	Address Line 1		
Yes	13330 CLARKSVILLE PIKE		
	Address Line 2		
	City	State	ZIP Code
	HIGHLAND	MD	20777-9701
	Phone 1	Phone 2	Fax
	3018540821		3018549632
	E-mail		
	EDWARD@PROBUILTCONSTRUCTION.COM		

Applicant (This section is not required.)

Search As Owner As Lic. Prof As Contact

Type *	First Name	Mi	Last Name
Applicant	EDWARD		PACYLOWSKI
Relationship	Full Name		
Applicant	EDWARD PACYLOWSKI		
Primary	Organization Name		
Yes	PRO BUILT CONSTRUCTION		
	Street Address		
	13330 CLARKSVILLE PIKE		
	Address Line 2		
	City	State	Zip Code
	HIGHLAND	MD	20777-9701
	Phone	Cell	Fax
	3018540821		3018549632
	E-mail *		
	EDWARD@PROBUILTCONSTRUCTION.COM		

Addl Info

Est Construction Cost	Housing Units *	Number of Buildings	Public Owned
8000	0	0	No
Construction Type			
434 - Additions, Alterations, and Conversions - Residential			

MISC PERMIT INFO

MISCELLANEOUS PERMIT INFORMATION

Capital Project-No Fee *	Capital Project Number	Fee Exempt *	Roadside Tree Project Permit *	Roadside Tree Project Permit #
<input type="radio"/> Yes <input checked="" type="radio"/> No		<input type="radio"/> Yes <input checked="" type="radio"/> No	<input type="radio"/> Yes <input checked="" type="radio"/> No	
Existing Use *	Water	Sewage	Expiration Date	
SFD	Privat	Privat	12/23/2018	


PAYMENT INFORMATION

Check 1	Payee 1	Check 2	Payee 2	SAP Doc No	SAP Entered
N/A	ONLINE PAYMENT				

Submit Cancel



LOCATION DRAWING  
 5111 HONEY LOCUST COURT  
 LOT 44  
 WALNUT CREEK  
 CLARKSVILLE (5th) ELECTION DISTRICT  
 HOWARD COUNTY, MARYLAND

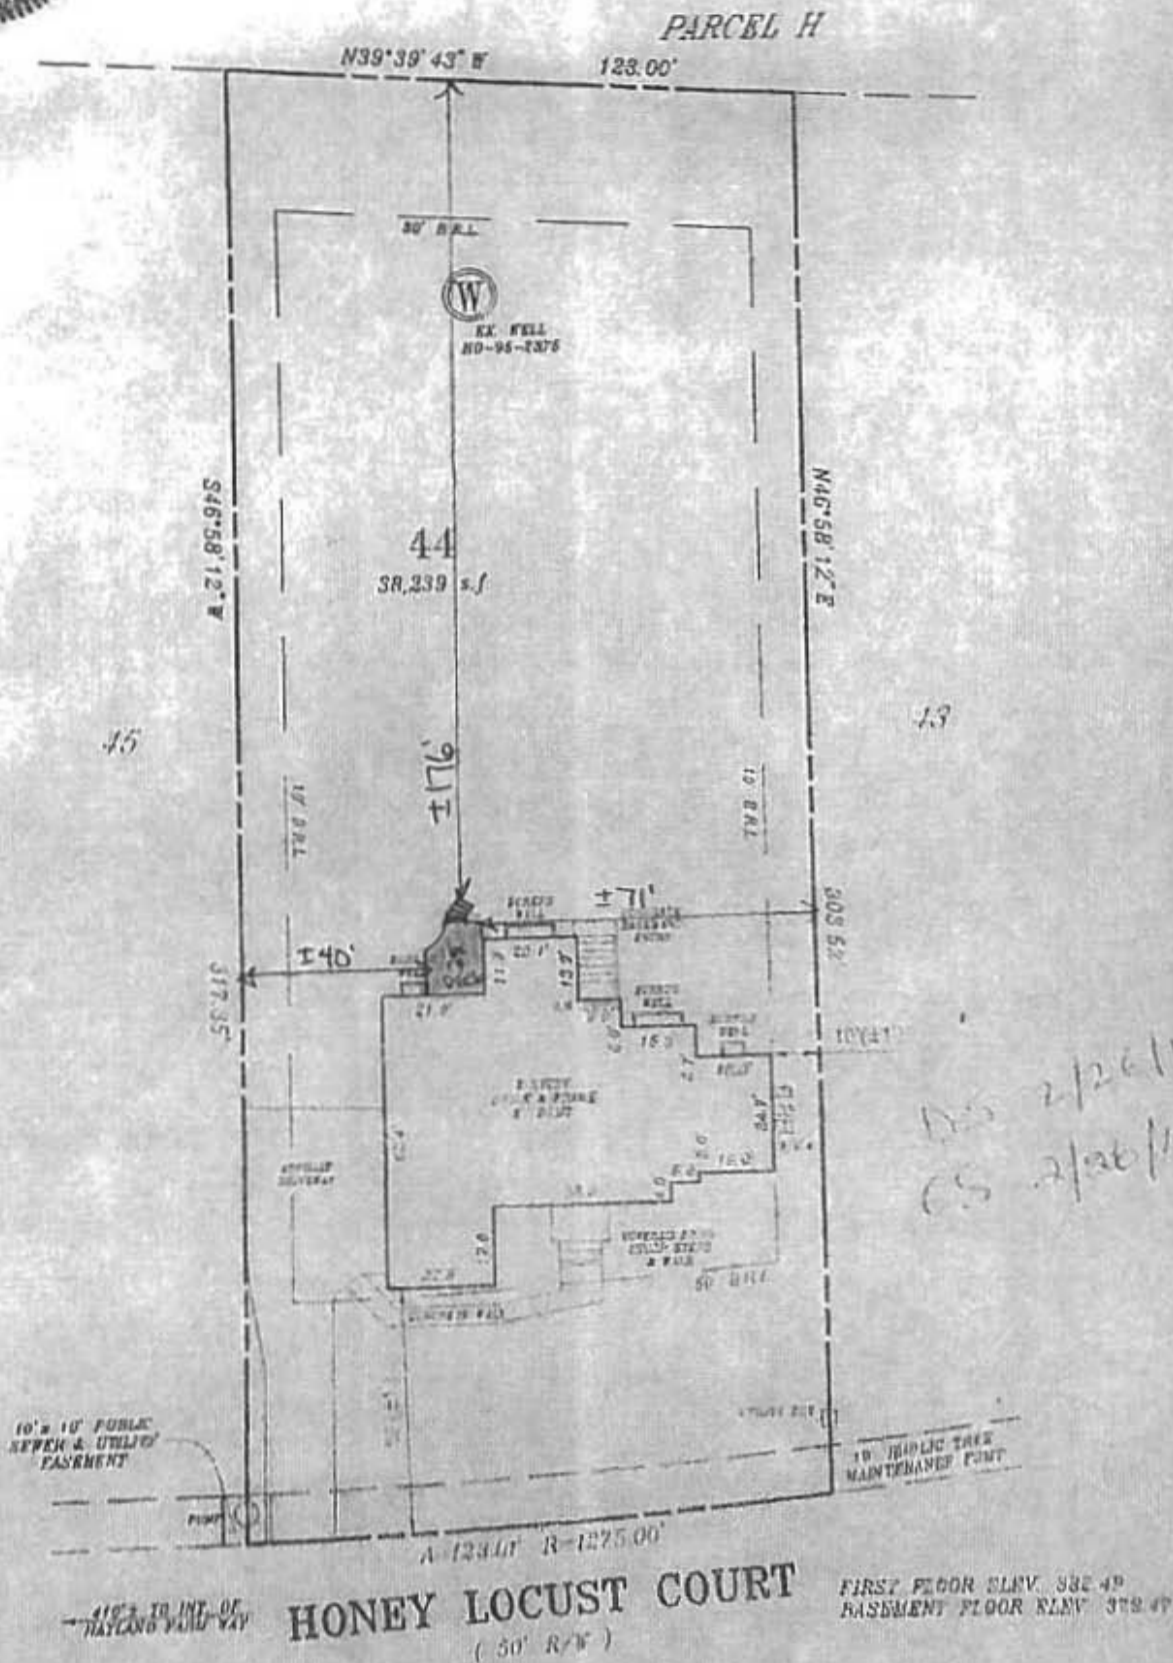

FINAL SURVEY: 11/10/2014  
 FOUNDATION SURVEY: 07/22/2014

ZONE: RR-DEO & RC-DEO

PERMIT NUMBER: B-14001498

SURVEYORS CERTIFICATE

I hereby certify that the position of the existing improvements shown herein have been carefully established under my responsible charge using accepted land surveying practices. The plan is of benefit to a consumer only insofar as it is required by a lender or a title insurance company or its agent in connection with contemplated transfer, financing or refinancing. The plan is not to be relied upon for the establishment or location of fences, garages, buildings, easements, or other existing or future improvements. The plan does not provide for the accurate identification of property boundary lines, but such identification may not be required for the transfer of title or securing financing or refinancing. This drawing was prepared w/o the benefit of a title report. This drawing and the survey on which it is based are in compliance with COMAP Reg. 9.13.06.06 and 9.13.06.12.

11-17-14

RAYMOND D. BURKE  
 REG. MICHIGAN STATE SURVEYOR  
 MD. NO. 476 EXP. 1/30/2015

**CPJ** Charles P. Johnson & Associates, Inc.  
 Civil and Environmental Engineers • Planners • Landscape Architects • Surveyors  
 1751 Blinn Rd., Ste. 300 Silver Spring, MD 20903 301-434-7000 Fax: 301-434-9394  
 www.cpj.com • Silver Spring, MD • Gaithersburg, MD • College Park, MD • Frederick, MD • Falls Church, VA

REFERENCE	Drawn by	JID	Checked by	
	WLP		RDB	RDB
	Date	08/06/2014	Revised No.	
	Scale	1" = 40'	43-354-88.44	
Plot No.	22233			

Dwg: N:\43354\DWG\880-44 Xref: