

Online Permit

Menu Save Reset Cancel Help

Record Detail (This section is required)

Permit Type	Permit Number	Opened Date
Building/Residential/Misc/Deck	B18002878	08/16/2018
Description of Work		
SFD / CONSTRUCT APPROX 16'X48' DECK WITH STEPS		

check spelling

Address (This section is required)

Search Reset Clear Get Parcel & Owner

Street #	Street Name	Street Type	
5042	CRAPE MYRTLE	CT	
Unit Type	Unit #	X Coordinate	Y Coordinate
--Select--		-76.94728	39.23505
City	State	Zip Code	Primary
ELLCOTT CITY	MD	21042	Yes

Parcel (This section is required)

Search Reset Clear Get Address & Owner

GIS ID	Parcel	Parcel Area	Land Value	Improved Value	Exemption Value	Plan Area
1105352	49	0	0	0	0	RURAL
Legal Description						

check spelling

Block	Lot	Census Tract	Council Dist	Supervisor Dist	Map #	DAP Zone	Primary
	151	605101	5				Yes
Plan Area	State Tax Id	Subdivision Name					
		Walnut Creek					
Section	Area	Tax Map					
		28					
Grid	Zoning District	ADC Map					
28-11	RC-DEO	4933-J3					
SDP No.	Final Plan No.	WP File No.					
	F-07-076						
Record Plat No.	WS Contract No.	FDP No.					
23611-2362							
Owner Occupied	Year Built	Historic District					
<input type="radio"/> Yes <input type="radio"/> No		<input type="radio"/> Yes <input checked="" type="radio"/> No					
Historic District Registry No.	Stat Area	Flood Plain					
	5-02A	<input type="radio"/> Yes <input checked="" type="radio"/> No					
Building No							

REC'D BY COMM HYGIENE 18 AUG 17 PM 2:25

Owner (This section is required)

Search Reset Clear

Name *
 MAHESH KUKATA

Address Line 1
 5042 CRAPE MYRTLE COURT

Address Line 2

Address Line 3

Mail City **Mail State** **Mail Zip Code**
 ELLICOTT CITY MD 21043

Phone **Primary**
 410-300-8378 Yes

E-mail

Cell Number **Fax Number**

Professionals *(This section is not required.)*

Search Reset Clear

License # * **Business Name**
 08010020247 PRO BUILT CONSTRUCTION

License Type * **First Name** **Middle Name** **Last Name**
 MHIC Ind EDWARD PACYLOWSKI

Primary **Address Line 1**
 No 13330 CLARKSVILLE PIKE

Address Line 2

City **State** **ZIP Code**
 HIGHLAND MD 20777-9701

Phone 1 **Phone 2** **Fax**
 3018540821 3018549832

E-mail
 EDWARD@PROBUILTCONSTRUCTION.COM

Applicant *(This section is not required.)*

Search As Owner As Lic. Prof As Contact

Type * **First Name** **MI** **Last Name**
 Applicant EDWARD PACYLOWSKI

Relationship **Full Name**
 Applicant EDWARD PACYLOWSKI

Primary **Organization Name**
 Yes PRO BUILT CONSTRUCTION

Street Address
 13330 CLARKSVILLE PIKE

Address Line 2

City **State** **Zip Code**
 HIGHLAND MD 20777-9701


Phone **Cell** **Fax**
 3018540821 3018549832

E-mail *
 EDWARD@PROBUILTCONSTRUCTION.COM

Addtl Info

Est Construction Cost * **Housing Units *** **Number of Buildings *** **Public Owned**
 30000 0 0 No

Construction Type

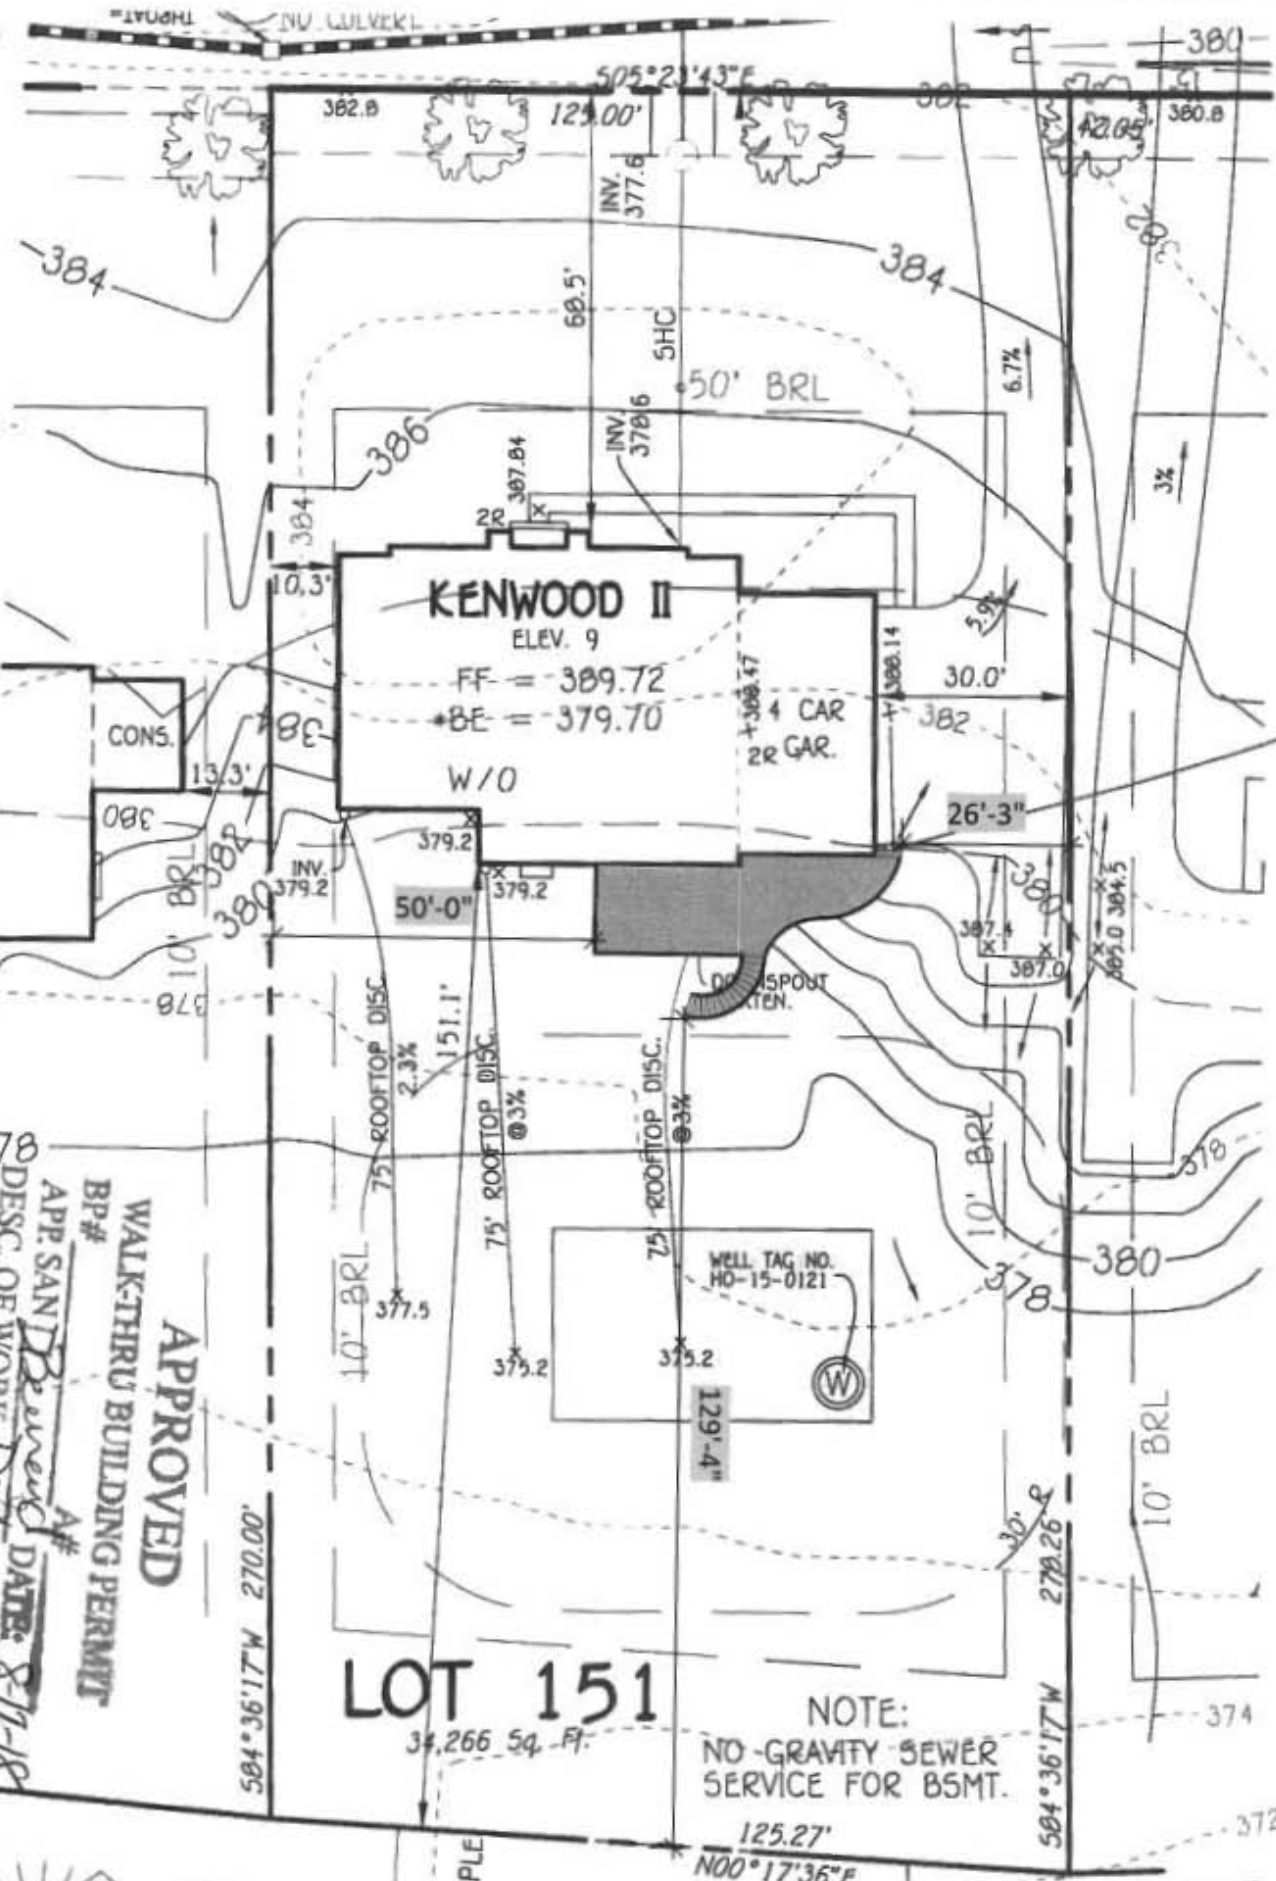

REAR GAR
DOWNSPC
DRAINAGE
TO BE DIR
TOWARDS E

APPROVED
WALK-THRU BUILDING PERMIT
BP#
APP. SANIT. REVIEW DATE: 8-17-18

378
DESC. OF WORK: Deck
Approved On Sheet

LOT 151
34,266 Sq. Ft.

NOTE:
NO-GRAVITY SEWER
SERVICE FOR BSMT.

350
S.F.
497
S.F.
494
S.F.