

---

**Maura J. Rossman, M.D., Health Officer**

## **MEMORANDUM**

**TO:** Kelly Brown  
*Sent via email to [Joedox333@netscape.net](mailto:Joedox333@netscape.net) on 10/2/18*

**FROM:** Sarah Collins, L.E.H.S. SEC  
Howard County Health Department  
Well and Septic Program

**DATE:** October 2, 2018

**RE:** **7631 Old Columbia Road**  
Laurel, MD 20723  
Map 41, Grid 17, Parcel 9  
Demolition of old house on property

---

**This is to advise that the Howard County Health Department recommends issuance of the demolition permit for the above referenced property.**


The old house was served by a drilled well. Robert Copsey (MSD 161) sealed the well on 9/10/18 and documentation was provided to the Health Department.

The old house had a septic tank and drywell in the front yard. Hatfield's Equipment pumped and crushed the tank and drywell on 9/12/18 and documentation was submitted to the Health Department.

The new house on the property is connected to public water and a new septic system was installed in February of 2018. Current utility records show this parcel has no access to public sewer; future development may require percolation testing and the development of a Percolation Certification Plan per *Howard County Code section 3.805*.

*IF ANY ADDITIONAL WELL OR SEPTIC COMPONENTS ARE FOUND DURING SITE WORK, PLEASE NOTIFY THE HOWARD COUNTY HEALTH DEPARTMENT IMMEDIATELY.*

*Cc: Howard County Department of Inspections, Licenses, and Permits  
File*

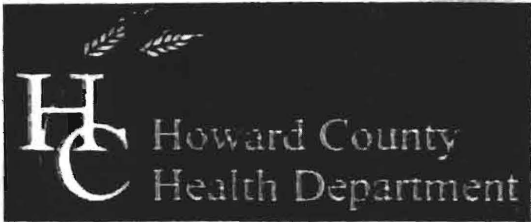

**Bureau of Environmental Health**  
 7178 Columbia Gateway Drive, Columbia, MD 21046-2147  
 Main: 410-313-2640 | Fax: 410-313-2648  
 TDD 410-313-2323 | Toll Free 1-866-313-6300  
 www.hchealth.org  
 Facebook: www.facebook.com/hocohealth  
 Twitter: @HowardCoHealthDep

**Maura J. Rossman, M.D., Health Officer**

**DEMOLITION REQUEST FORM**

Please fill in all blanks)

**Information of Property to be Demolished:**

Wendell & Kelly Brown 7031 Old Columbia Rd Laurel MD 20723  
 Current Owner's Name Property Address

Subdivision (if applicable) Lot #

All Prior Owners' Names (if requested or known) Tax Map Parcel # Tax ID #

New home has been built, old house has to come down  
 Purpose/Reason for Demolition

Create driveway and yard  
 Future plans of property after demo (i.e. subdivision, parking lot, re-build new house, etc....)

If a subdivision, SDP# \_\_\_\_\_ Has the structure(s) been deemed unsafe by DILP YES NO

**UTILITY RECORDS:**

Property currently connected to public water YES X NO

Property currently connected to public sewer YES X NO

Does the property currently have any wells and/or septic systems YES X NO

→ Explain: Hatfield has Crashed & abandoned well & septic

\*Note: Any wells and/or septic systems that are to remain may require an approved percolation certification plan under Howard County Code Sec. 3.805

\*Note: Any septic systems that are to be abandoned must be done by a septic contractor with documentation of the process.

\*Note: All abandoned wells are to be sealed by a well driller licensed by the Maryland State Board of Well Drillers COMAR Sec 26.04.04.11 Abandonment Standards D (3)

**COMMENTS:**

Kelly Brown  
 Applicant's Name (please print)

301-785-2502  
 Applicant's Phone #

joedox333@netscape.net  
 Applicant's Email

N/A  
 Applicant's Fax #

[Signature]  
 Applicant's Signature

10/1/18  
 Date

\*\*\*\*\*  
WATER WELL ABANDONMENT-SEALING REPORT FORM  
\*\*\*\*\*

SUBMIT COPIES OF COMPLETED FORM TO:

- \* COUNTY ENVIRONMENTAL AGENCY (contact MDE, WMA if address needed)
- \* WELL OWNER
- \* MDE, WATER MANAGEMENT ADMINISTRATION, WELL PROGRAM

OK  
10/2/18 SC

DATE WELL ABANDONED: 9/10/18 (month/day/year)

\* PERMIT NUMBER OF ABANDONED WELL (if any) \_\_\_\_\_

\* PERMIT NUMBER OF REPLACEMENT WELL: \_\_\_\_\_


\* PERSON ABANDONING WELL: ROBERT COPPEY WELL DRILLER'S LICENSE NUMBER: 161

CIRCLE: MWD / MSD / MGD

\* OWNER'S NAME: WENDELL BROWN

SITE LOCATION MAP

\* WELL LOCATION:  
COUNTY: HOWARD CO.  
NEAREST TOWN: LAUREL  
TAX MAP 0041 BLOCK \_\_\_\_\_ PARCEL 0000  
SUBDIVISION: \_\_\_\_\_  
SECTION: \_\_\_\_\_ LOT: \_\_\_\_\_  
STREET ADDRESS: 7631 OLD COLUMBIA RD  
LAUREL MD. 20723

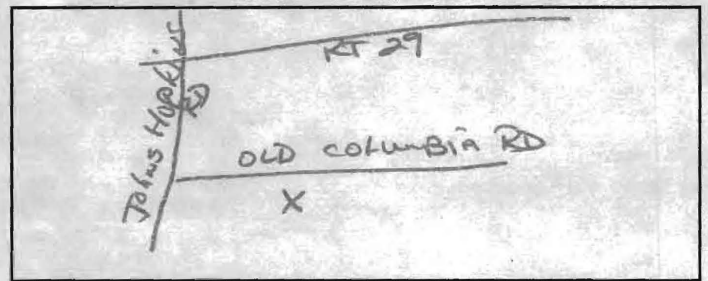

LATITUDE 3 9.161179

LONGITUDE 7 6.886099

LOG OF SEALING MATERIAL

MATERIAL	FEET	
	FROM	TO
<u>Bentonite clay</u>	<u>60</u>	<u>5</u>
<u>clean fill</u>	<u>5</u>	<u>0</u>
VOLUME OF MATERIAL USED		
<u>755 lbs bentonite clay</u>		

\* TYPE OF WELL BEING ABANDONED:  
 DRILLED  JETTED  
 BORED  HAND DUG  
 OTHER (specify) \_\_\_\_\_

\* USE CODE:  
 DOMESTIC  MUNICIPAL/PUBLIC  
 IRRIGATION  INDUSTRIAL  
 TEST/OBSERVATION  GEOTHERMAL

\* TYPE OF CASING:  
 STEEL  PLASTIC  
 CONCRETE  OTHER (specify) \_\_\_\_\_

SIZE OF CASING: 6" INCHES IN DIAMETER

DEPTH OF WELL: 60' FEET DEEP

WAS ANY CASING REMOVED?  YES  NO  
If yes, length removed, in feet: 5

WAS CASING RIPPED OR PERFORATED?  YES  NO

SIGNATURE-MASTER WELL DRILLER OR SUPERVISING SANITARIAN LICENSE#  
Robert Coppey 161

MWD / MSD / MGS

CIRCLE ONE

9/10/18  
DATE

COUNTY

Pursuant to § 10-624 of the State Govt. Article of the Maryland Code, personal info requested on this form is used in processing this form pursuant to COMAR 26.04.04. Failure to provide the info may result in this form not being processed. You have the right to inspect, amend, or correct this form. The Maryland Department of the Environment is subject to the Maryland Public Information Act. This form may be made available on the Internet via MDE's website and is subject to inspection or copying, in whole or in part, by the public and other governmental agencies, if not protected by federal or State Law.

# *Hatfield's Equipment and Dedication Services, Inc.*

---

P.O. Box 519 • Annapolis Junction, MD 20701-0519  
Office: 301-490-4289 / 888-490-4289 • Fax: 301-490-5794

Howard County Health Department  
8930 Stanford Boulevard  
Columbia, MD 21045

September 12, 2018

Re: Septic demo  
Owner: Wendell Brown  
7631 Old Columbia Road  
Laurel, MD 20723

Hatfield's Equipment located septic tank and one drywell in front of the house to be demolished.  
Hatfield's pumped, crushed and filled 1,000 gallon septic and a 15' x15' x 10.5' deep drywell.



Ken Hatfield