

WR 9/71

C 1 02597-7
SEQUENCE NO. (OWNER USE ONLY)

STATE OF MARYLAND
DEPARTMENT OF WATER RESOURCES
STATE OFFICE BLDG., ANNAPOLIS, MARYLAND 21401
WELL COMPLETION REPORT

THIS REPORT MUST BE SUBMITTED WITHIN 30 DAYS AFTER WELL COMPLETION
FILL IN THIS FORM COMPLETELY

DATE RECEIVED (OWNER USE ONLY)
DATE WELL COMPLETED

Aug 7 1972

DEPTH OF WELL 165
(TO NEAREST FOOT)

PERMIT NO. FROM "PERMIT TO DRILL WELL"
40-12-2-177

OWNER Pastine, John D.
LAST NAME FIRST NAME
STREET OR RFD Brooks RD

POST OFFICE Highland MD 20777

WELL LOG

STATE THE KIND OF FORMATIONS PENETRATED, THEIR COLOR, DEPTH, THICKNESS AND IF WATER BEARING

DESCRIPTION (USE ADDITIONAL SHEETS IF NECESSARY)	FEET FROM	TO	CHECK IF WATER BEARING
Yellow Shale	0	30	
Yellow Rock	30	45	
Blue Mica Shist	45	165	

GROUTING RECORD

WELL HAS BEEN GROUTED (CIRCLE APPROPRIATE BOX) YES (Y) NO (N)

TYPE OF GROUTING MATERIAL (CIRCLE BOX)
CEMENT (C) M SEXTONITE CLAY (B) C
NO. OF BAGS 50 NO. OF POUNDS 50
DEPTH OF GROUT SEAL (TO NEAREST FOOT)
FROM 0 FT. TO 54 FT.

CASING RECORD
INSERT APPROPRIATE CODE BELOW
S T STEEL
C O CONCRETE
P L PLASTIC
O T OTHER

MAIN CASING TYPE S T
NOMINAL DIAMETER TOP (MAIN) CASING OF MAIN CASING (NEAREST INCH) 6
TOTAL DEPTH (NEAREST FOOT) 35 1/2

OTHER CASING (IF USED) DIAMETER (INCH) FROM TO

SCREEN RECORD
SCREEN TYPE OR OPEN HOLE
INSERT APPROPRIATE CODE BELOW
S T STEEL
B R BRASS OR BRONZE
H D OPEN HOLE
P L PLASTIC
O T OTHER

DEPTH (NEAREST WHOLE FOOT)
FROM 0 TO 165

CIRCLE APPROPRIATE BOXES
A WELL WAS ABANDONED AND SEALED WHEN THIS WELL WAS COMPLETED
E ELECTRIC LOG OBTAINED
P TEST WELL CONVERTED TO PRODUCTION WELL

I HEREBY CERTIFY THAT I HAVE COMPLIED WITH ALL CONDITIONS STATED ON THE ABOVE-CAPTIONED "PERMIT TO DRILL WELL", AND THAT INFORMATION CONTAINED IN THIS REPORT IS TRUE, ACCURATE, AND COMPLETE TO THE BEST OF MY KNOWLEDGE, INFORMATION AND BELIEF.

DRILLER'S NAME
PLEASE PRINT: Harry Green
SIGNATURE: Harry Green

DIAMETER OF SCREEN (NEAREST INCH) FROM TO

GRAVEL PACK

IF WELL DRILLED WAS A FLOWING WELL CIRCLE BOX

OWNER USE ONLY (NOT TO BE FILLED IN BY DRILLER)

TELESCOPE CASING LOG INDICATOR OTHER DATA AVAILABLE

PUMPING TEST


HOURS PUMPED (TO NEAREST HOUR) 3
PUMPING RATE (GALLONS PER MINUTE TO NEAREST GALLON) 10
METHOD USED TO MEASURE PUMPING RATE Baller
WATER LEVEL (DISTANCE FROM LAND SURFACE) BEFORE PUMPING 30
WHEN PUMPING 155
TYPE OF PUMPED USED (CIRCLE APPROPRIATE BOX) (FOR PUMPING TEST)
A AIR
R PISTON
C CENTRIFUGAL
J JET
T TURBINE
R ROTARY
S SUBMERGIBLE

PUMP INSTALLED
TYPE OF PUMP (WRITE APPROPRIATE LETTER IN BOX - SEE ABOVE) A, C, J, P, R, S, T, O

DRILLER WILL INSTALL PUMP (CIRCLE APPROPRIATE BOX) YES (Y) NO (N)
CAPACITY: GALLONS PER MINUTE (TO NEAREST GALLON) 31
PUMP HORSE POWER 37
PUMP COLUMN LENGTH (NEAREST FOOT) 43

CASING HEIGHT (CIRCLE APPROPRIATE BOX AND ENTER CASING HEIGHT)
LAND SURFACE (NEAREST FOOT) 2

LOCATION OF WELL ON LOT
SHOW PERMANENT STRUCTURE SUCH AS BUILDINGS, COTTAGE TANKS; AND/OR OTHER LAND MARKS AND INDICATE NOT LESS THAN TWO DISTANCES (MEASUREMENTS TO WELL).

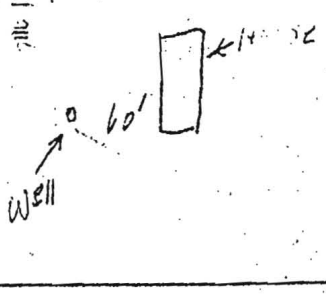

HEALTH



Interactive Map

Map Layers Map Legend Search

All Layers

- Base Maps & Aerial Photos
- Annotation Layers
- HoCo Base Map Layers
 - Contours 2004
 - County Boundary
 - Stream Centerline Buffer 75ft
 - Building Permits (New)
 - Scanned PDF Drawings Intern.
 - Address Points
 - Street Centerline
 - Metro Property
 - Property Boundaries
- Additional Layers
- Sewer Infrastructure
- Water Infrastructure
- Study Areas
- Layer Overlays
 - Floodplain - Draft - Small Tnb
 - Floodplain
 - Floodplain - Historic
 - Historic Districts
 - Zoning
 - Land Use
 - Water/Sewer Labels
 - Sewer Infrastructure

