

PRELIMINARY

APPLICATION

A 19605

P _____

SEWAGE DISPOSAL TESTING

STATE OF MARYLAND - DEPARTMENT OF HEALTH AND MENTAL HYGIENE

HOWARD COUNTY HEALTH DEPARTMENT
ENVIRONMENTAL HEALTH SERVICES
P. O. BOX 476, ELLICOTT CITY, MARYLAND 21043
TELEPHONE: 465-5000, EXT. 356

DISTRICT 3rd

DATE 3/4/74

TO: THE COUNTY HEALTH OFFICER
ELLICOTT CITY, MARYLAND

I, HEREBY, APPLY FOR THE NECESSARY TEST IN ORDER TO CONSTRUCT (OR RECONSTRUCT) A SEWAGE DISPOSAL SYSTEM.

PROPERTY OWNER Edward J. and Nancy J. Kasemeyer

ADDRESS West Friendship, Maryland 21794

Any questions call Mr. Bill Swann, 286-2608
PHONE _____

PROPERTY LOCATION:

SUBDIVISION _____ LOT NO. Parcel 3

ROAD AND DESCRIPTION 2590 Pfefferkorn Road, West Friendship, Md.

Approximately 2 miles Northwest of Route 32 on Pfefferkorn Road

SIZE OF LOT 5.621 acres TYPE BLDG. 3 or 4 bedrooms

NUMBER OF BEDROOMS

IF NOT SINGLE RESIDENCE DESCRIBE _____

THE SYSTEM INSTALLED UNDER THIS APPLICATION IS ACCEPTABLE ONLY UNTIL PUBLIC FACILITIES BECOME AVAILABLE.

SIGNATURE OF APPLICANT /s/ William Swann


APPROVED BY _____ FOR _____ DATE _____
(KIND OF SYSTEM)

REJECTED BY _____ FOR _____ DATE _____
(KIND OF SYSTEM)

HOLD PENDING FURTHER TESTS _____ DATE _____

REASONS FOR REJECTION OR HOLDING _____

THIS IS NOT A PERMIT

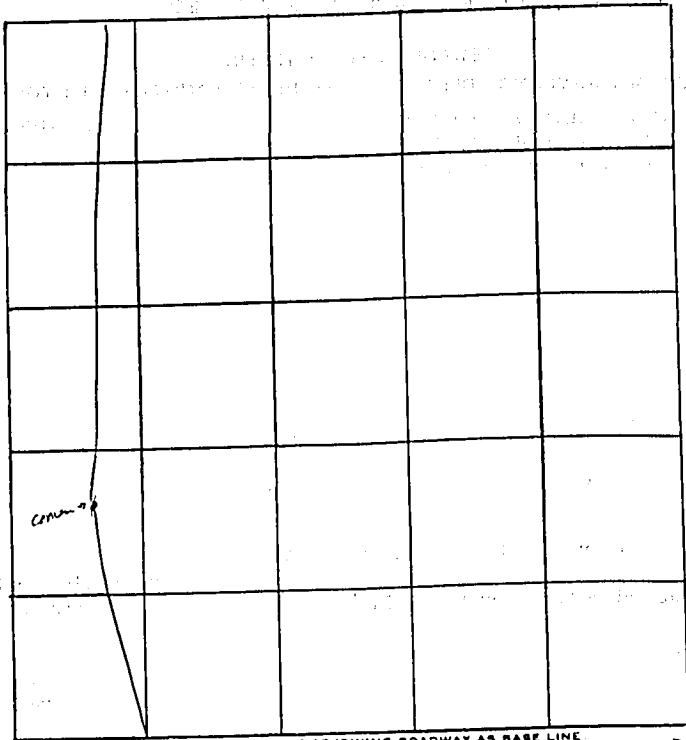

INDICATE NORTH - NAME ADJOINING ROADWAY, AS BASE LINE.

← Pfeffer Korn →

→ N

DATE	TEST NO.	DEPTH	PRE-WET		TEST 1" DROP		TIME
			START	STOP	START	STOP	
	1	11 1/2	9 ⁵²	9 ⁵³	9 ⁵³	9 ⁵⁸	
	1A	5	9 ⁵⁵	9 ⁵⁸	9 ⁵⁸	10 ⁰³	
	2	11	vis	OK			
	3	11	10 ⁰²	10 ⁰³	10 ⁰³	10 ⁰⁸	5
	3A	4	10 ⁰³	10 ⁰⁵	10 ⁰⁵	10 ⁰⁵	4
	4	10	vis	OK			

} Loam

} sandy loam

REMARKS _____

TYPE OF SOIL sandy loam

TESTED BY R M ALSO PRESENT: _____

11/1 HADLOU L. DANBURG
10/1/612

N118°46'00"E
254.67'

H.O. FILE
A19607

N154°18'00"W
418.27'

#12

#1

#3 3
5.621 AS*

720.00'

2

5

N176°36'00"W
1026.10'

286.71'
51/2°40'37"E

S64°37'00"E

10'w. in fee DW

N163°15'00"E
698.56'

DEFFERKORN ROAD

Note: the lot shown hereon
complies with the minimum
ownership and lot area as
required by the Maryland
State Health Department.

Approved: private w/e, private cover
[Signature] 5/15/74
Md. Health Officer Date



Plan of Property

situate in

32nd ELEC. DIST. - HOWARD CO., MD.

surveyed for
EDWARD & NANCY KASEMYER

scale: 1"=100'

Dr. 211 W. 4th N.B. No.:

Survey No.:

Date: 1/13/74

Free State Surveying and Land Planning Inc.
Elkridge, Maryland

2610 Pfefferkorn Road