





Proposed Remodel of Existing Sunroom 12' x 24'

Proposed 2 Car Garage 24' x 24'

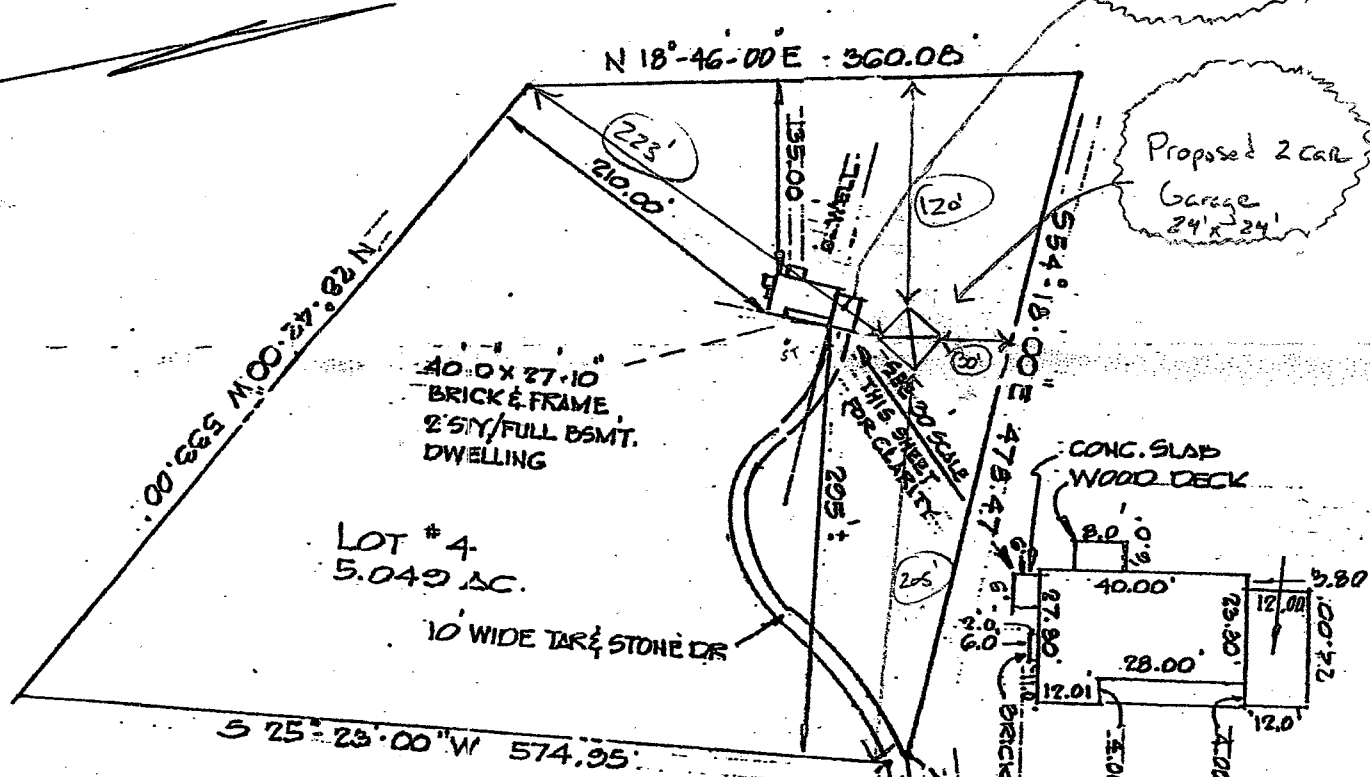

40.0 x 27.10  
BRICK & FRAME  
2'5 1/2" FULL BSMT.  
DWELLING

LOT # 4  
5.049 AC.  
10' WIDE TAR & STONE DR

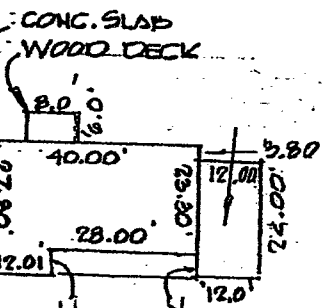

PLAN  
SCALE: 1" = 100'

PLAN #  
SCALE: 1" = 30'  
NOTE: THE PLAN SHOWN ABOVE IS THE DWELLING ON LOT # 4 AT A LARGER SCALE FOR CLARITY.

APPROVED

WALK-THRU BUILDING PERMIT

BP# \_\_\_\_\_ A# 23075  
APP. SAN KS DATE: 4-19-10

DESC. OF WORK:  
24' x 24' garage

PEFFERKORN RD

SCALE: 1" = 100'	APPROVED BY:
DATE: 12-23-76	
3RD DISTRICT HO. CO. MC	

I HEREBY CERTIFY THAT AND STRUCTURES SHOWN ARE CORRECT:  
JOHN GARY  
1156

