

APPLICATION

Sampson

A 19659

SEWAGE DISPOSAL TESTING

P _____

STATE OF MARYLAND - DEPARTMENT OF HEALTH AND MENTAL HYGIENE

HOWARD COUNTY HEALTH DEPARTMENT
ENVIRONMENTAL HEALTH SERVICES

Septic Tank - 1250 gal.

DISTRICT 3

P. O. BOX 476, ELLICOTT CITY, MARYLAND 21043
TELEPHONE: 465-5000, EXT. 356

One Well - 500 sq. ft.

DATE 3/14/74

abundant soil area to dig below the first 4 1/2 ft. of any porous soil. Maximum depth permitted for dry well is 12 1/2 ft. Locate dry well 200 ft. from rear property line and 94 ft. from right angle line as seen from Pfefferkorn Road. System to be installed before any other permits received. Well is to be installed 90 ft. from rear right angle line on right side of lot. (Any questions contact R. Tume)

TO: THE COUNTY HEALTH OFFICER
ELLICOTT CITY, MARYLAND

I, HEREBY, APPLY FOR THE NECESSARY TEST IN ORDER TO CONSTRUCT (OR RECONSTRUCT) A SEWAGE DISPOSAL SYSTEM.

PROPERTY OWNER Edward J. and Nancy J. Kasemeyer

Any questions call:

ADDRESS West Friendship, Maryland 21794

PHONE Bill Swann
226-2608

PROPERTY LOCATION:

SUBDIVISION _____ LOT NO. 4

PFEFFERKORN ROAD -

ROAD AND DESCRIPTION Approximately 2 mile Northwest of Route 32 on Pfefferkorn Road

SIZE OF LOT 5.049 acres TYPE BLDG. 3 or 4

NUMBER OF BEDROOMS

IF NOT SINGLE RESIDENCE DESCRIBE _____

THE SYSTEM INSTALLED UNDER THIS APPLICATION IS ACCEPTABLE ONLY UNTIL PUBLIC FACILITIES BECOME AVAILABLE.

SIGNATURE OF APPLICANT /s/ William Swann

ONLY WITH ABOVE RESTRICTIONS

APPROVED BY Robert V. Tume FOR One Well DATE 6/4/74

(KIND OF SYSTEM)

REJECTED BY _____ FOR _____ DATE _____

(KIND OF SYSTEM)

HOLD PENDING FURTHER TESTS _____ DATE _____

REASONS FOR REJECTION OR HOLDING William J. Sampson

1920 Linnwood Ave.

Catoxville, Md. 21228

(Bldg. permit returned.)

744-9105

THIS IS NOT A PERMIT

4-12' holes
at 10,000 ft.

Preliminary

APPLICATION

A 19659

SEWAGE DISPOSAL TESTING

P _____

STATE OF MARYLAND - DEPARTMENT OF HEALTH AND MENTAL HYGIENE

HOWARD COUNTY HEALTH DEPARTMENT
ENVIRONMENTAL HEALTH SERVICES
P. O. BOX 476, ELLICOTT CITY, MARYLAND 21043
TELEPHONE: 465-5000, EXT. 3501

Septic tank
3 bedrooms - 1000 gallons
4 bedrooms - 1250 gallons

DISTRICT 3

DATE 3/14/74

3/15/74
9:30

prop well to have 130 gallons

See other sheet for specs.

TO: THE COUNTY HEALTH OFFICER
ELLICOTT CITY, MARYLAND

I, HEREBY, APPLY FOR THE NECESSARY TEST IN ORDER TO CONSTRUCT (OR RECONSTRUCT) A SEWAGE DISPOSAL SYSTEM.

PROPERTY OWNER Edward J. and Nancy J. Kasemeyer

ADDRESS West Friendship, Maryland 21794 PHONE Bill Swann
286-2608

Any questions call:

PROPERTY LOCATION:

SUBDIVISION _____ LOT NO. 4

ROAD AND DESCRIPTION PFEFFERKORN ROAD -
Approximately 2 mile Northwest of Route 32 on Pfefferkorn Road

SIZE OF LOT 5.049 acres TYPE BLDG. 3 or 4
NUMBER OF BEDROOMS _____

IF NOT SINGLE RESIDENCE DESCRIBE _____

THE SYSTEM INSTALLED UNDER THIS APPLICATION IS ACCEPTABLE ONLY UNTIL PUBLIC FACILITIES BECOME AVAILABLE.

SIGNATURE OF APPLICANT /s/ William Swann

APPROVED BY Robert V. Ture FOR Prop well DATE 6/4/74
Only with restrictions *See other sheet.*

REJECTED BY H. O. G. R. Ture FOR Drumwell DATE 5-17-74

HOLD PENDING FURTHER TESTS _____ DATE _____


REASONS FOR REJECTION OR HOLDING Not enough room to build house, and
have a sewage (Hold-for certified holes) disposal system and
well on the high side of the lot 51774
6/3/74 - Discussed with FF - possibilities and (long) recommendations.
P.T.

THIS IS NOT A PERMIT

MOISTURE LOG

62201

ANNEX

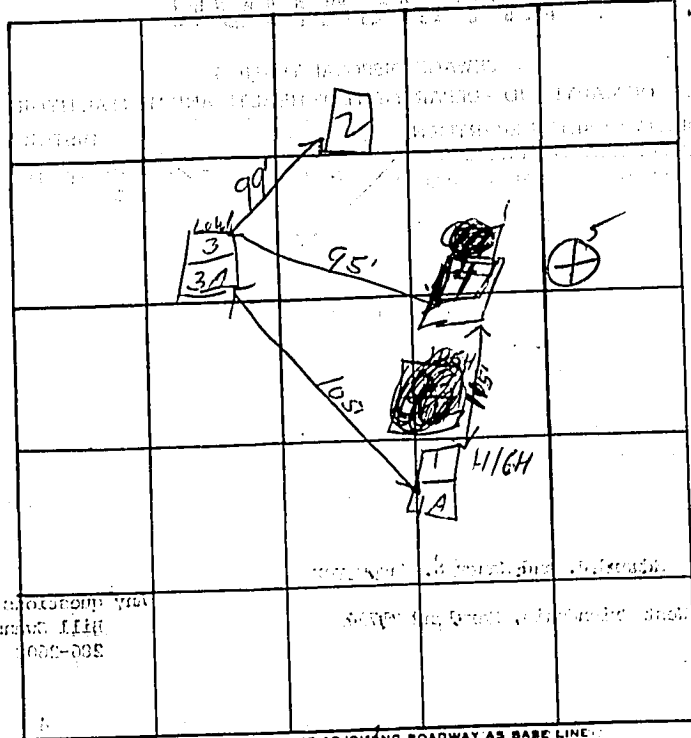

Lot #4

all measurements
checked

INDICATE NORTH - NAME ADJOINING ROADWAY AS BASE LINE

INDICATE NORTH - NAME ADJOINING ROADWAY AS BASE LINE

Project location: *pk. Kallakum Rd*

HIGH 3-15-74

DATE	TEST NO.	DEPTH	PRE-WET		TEST - 1" DROP		TIME
			START	STOP	START	STOP	
↑	1	13'	1025				
	1A	6'	1030				
	2	10'	1015	1016	1015	1025	10
	3	11'	1010	1015	1015	1025	10
	3A	5'	1010	1016	1016	1019	3 min
	4	10'	SOIL	OK			
	5	13'	deep, dry, loam				2 1/2
3-15-77							

REMARKS Check all holes - question of soil cones & changes

TYPE OF SOIL _____

TESTED BY _____ ALSO PRESENT: _____

H.Q. FILE-19659

W.P. T. McCORMICK
224/113

W.P. HAROLD L. DAVISBURG
102/612

N 28° 42' 00" W - 533.00'

N 18° 16' 00" E - 360.08'

4
5.049 AC±

S 25° 23' 00" W - 574.05'

5

Note: the lot shown hereon
complies with the minimum
ownership and lot area as
required by the Maryland
State Health Department.

Approved: private utility private sewer
[Signature] 1/24/74
Co. Health Officer Date

10' W.
in fee 12/11

PEFFERKORN



Plan of Property

situate in
3RD ELECT. DIST. - HOWARD CO., MD.

surveyed for
EDWARD E. NANCY KASEM, ET AL

Scale: 1" = 100' Date: 1/11/74

Free State Surveying and Land Planning, Inc.
Ellicottsburg, Maryland

2620 Pfefferkorn Road

F
from
is
ot.

No. 19659