



Building Permit Application

Howard County Maryland
 Department of Inspections, Licenses and Permits
 3430 Court House Drive
 Permits: 410-313-2455
 www.howardcountymd.gov

Date Received: _____

Permit No.: _____

Building Address: 17327 PINK DOGWOOD COURT
 City: MT AIRY State: MD Zip Code: 21771
 Suite/Apt. #: _____ SDP/WP/BA #: _____
 Subdivision: WHITE WOOD ESTATES
 Lot: 21 Tax Map: _____ Parcel: 0001

Existing Use: _____
 Proposed Use: _____

Estimated Construction Cost: \$ 28,000.-

Description of Work: BUILD SCREEN POOL ON EXISTING
POOL DECK

Occupant/Tenant Name: _____

Was tenant space previously occupied? Yes No

Contact Name: _____
 Address: _____
 City: _____ State: _____ Zip Code: _____
 Phone: _____ Fax: _____
 Email: _____

Property Owner's Name: ADAM CASCIOLI
 Address: 17327 PINK DOGWOOD COURT
 City: MT AIRY State: MD Zip Code: 21771
 Phone: 301 655 2085 Fax: _____
 Email: ADAM.CASCIOLI@GMAIL.COM

Applicant's Name & Mailing Address, (If other than stated herein)
 Applicant's Name: JEFF FRASURE
 Address: 11612 BAEDERWOOD LANE
 City: DEERWOOD State: MD Zip Code: 20855
 Phone: 301 674 3880 Fax: _____
 Email: CNF DECK CO @ VERIZON.NET

Contractor Company: CNF CONSTRUCTION INC
 Contact Person: JEFF FRASURE
 Address: 11612 BAEDERWOOD LANE
 City: DEERWOOD State: MD Zip Code: 20855
 License No.: 37070
 Phone: 301 674 3880 Fax: OFFICE 301 869 1300
 Email: CNF DECK CO @ VERIZON.NET

Engineer/Architect Company: _____
 Responsible Design Prof.: _____
 Address: _____
 City: _____ State: _____ Zip Code: _____
 Phone: _____ Fax: _____
 Email: _____

Commercial Building Characteristics	Residential Building Characteristics	
Height:	<input checked="" type="checkbox"/> SF Dwelling <input type="checkbox"/> SF Townhouse	
No. of stories:	Depth	Width
Gross area, sq. ft./floor:	1 st floor:	
	2 nd floor:	
Area of construction (sq. ft.):	Basement:	
	<input type="checkbox"/> Finished Basement	
Use group:	<input type="checkbox"/> Unfinished Basement	
	<input type="checkbox"/> Crawl Space	
Construction type:	<input type="checkbox"/> Slab on Grade	
<input type="checkbox"/> Reinforced Concrete	No. of Bedrooms:	
<input type="checkbox"/> Structural Steel	Multi-family Dwelling	
<input type="checkbox"/> Masonry	No. of efficiency units:	
<input type="checkbox"/> Wood Frame	No. of 1 BR units:	
<input type="checkbox"/> State Certified Modular	No. of 2 BR units:	
	No. of 3 BR units:	
	Other Structure:	
	Dimensions:	
<input checked="" type="checkbox"/> Roadside Tree Project Permit	Footings:	
<input type="checkbox"/> Yes <input checked="" type="checkbox"/> No	Roof:	
Roadside Tree Project Permit #	<input type="checkbox"/> State Certified Modular	
	<input type="checkbox"/> Manufactured Home	

Utilities	
Electric:	<input type="checkbox"/> Yes <input type="checkbox"/> No
Gas:	<input type="checkbox"/> Yes <input type="checkbox"/> No
Water Supply	
<input type="checkbox"/> Public	
<input checked="" type="checkbox"/> Private	
Sewage Disposal	
<input type="checkbox"/> Public	
<input checked="" type="checkbox"/> Private	
Heating System	
<input type="checkbox"/> Electric <input type="checkbox"/> Oil	
<input type="checkbox"/> Natural Gas <input type="checkbox"/> Propane Gas	
<input type="checkbox"/> Other:	
Sprinkler System:	
<input type="checkbox"/> Yes <input type="checkbox"/> No	
Grading Permit Number:	
Building Shell Permit Number:	

THE UNDERSIGNED HEREBY CERTIFIES AND AGREES AS FOLLOWS: (1) THAT HE/SHE IS AUTHORIZED TO MAKE THIS APPLICATION; (2) THAT THE INFORMATION IS CORRECT; (3) THAT HE/SHE WILL COMPLY WITH ALL REGULATIONS OF HOWARD COUNTY WHICH ARE APPLICABLE THERETO; (4) THAT HE/SHE WILL PERFORM NO WORK ON THE ABOVE REFERENCED PROPERTY NOT SPECIFICALLY DESCRIBED IN THIS APPLICATION; (5) THAT HE/SHE GRANTS COUNTY OFFICIALS THE RIGHT TO ENTER ONTO THIS PROPERTY FOR THE PURPOSE OF INSPECTING THE WORK PERMITTED AND POSTING NOTICES.

Applicant's Signature: _____
 Email Address: CNF DECK CO @ VERIZON.NET
 Title/Company: OWNER CNF CONSTRUCTION

Print Name: JEFF FRASURE
 Date: 9/12/18

Checks Payable to: DIRECTOR OF FINANCE OF HOWARD COUNTY
 PLEASE WRITE NEATLY & LEGIBLY
 -FOR OFFICE USE ONLY-

AGENCY	DATE	SIGNATURE OF APPROVAL
State Highways		
Building Officials		
PSZA (Zoning)		
PSZA (Engineering)		
Health	<u>9/12/2018</u>	<u>[Signature]</u>

is Sediment Control approval required for issuance? Yes No
 CONTINGENCY CONSTRUCTION START

DPZ SETBACK INFORMATION
Front:
Rear:
Side:
Side St.:
All minimum setbacks met? <input type="checkbox"/> Yes <input type="checkbox"/> No
Is Entrance Permit Required? <input type="checkbox"/> Yes <input type="checkbox"/> No
Historic District? <input type="checkbox"/> Yes <input type="checkbox"/> No
Lot Coverage for New Town Zone:
SDP/Red-line approval date:

Filing Fee	\$
Permit Fee	\$
Tech Fee	\$
Excise Tax	\$
PSFS	\$
Guaranty Fund	\$
Add'l per Fee	\$
Total Fees	\$
Sub- Total Paid	\$
Balance Due	\$
Check	#

Distribution of Copies: White: Building Officials Green: PSZA,Zoning Yellow: PSZA,Engineering Pink: Health Gold: SHA

PROPERTY ADDRESS: 1732 PINK DOGWOOD COURT MOUNT AIRY, MARYLAND 21771-3654


SURVEY NUMBER: MD1606.0865

FIELD WORK DATE: 6/15/2016

REVISION HISTORY: REV 0 6/15/2016

MD1606.0865
LOCATION DRAWING
LOT 21
WHITE WOOD ESTATES
HOWARD COUNTY, MARYLAND
06-15-2016 SCALE 1"=150'

PLEASE NOTE
This House Location Drawing is for informational purposes only. Per Maryland State Code it may not be relied upon to delineate property boundaries and may not be used for building permits or construction.

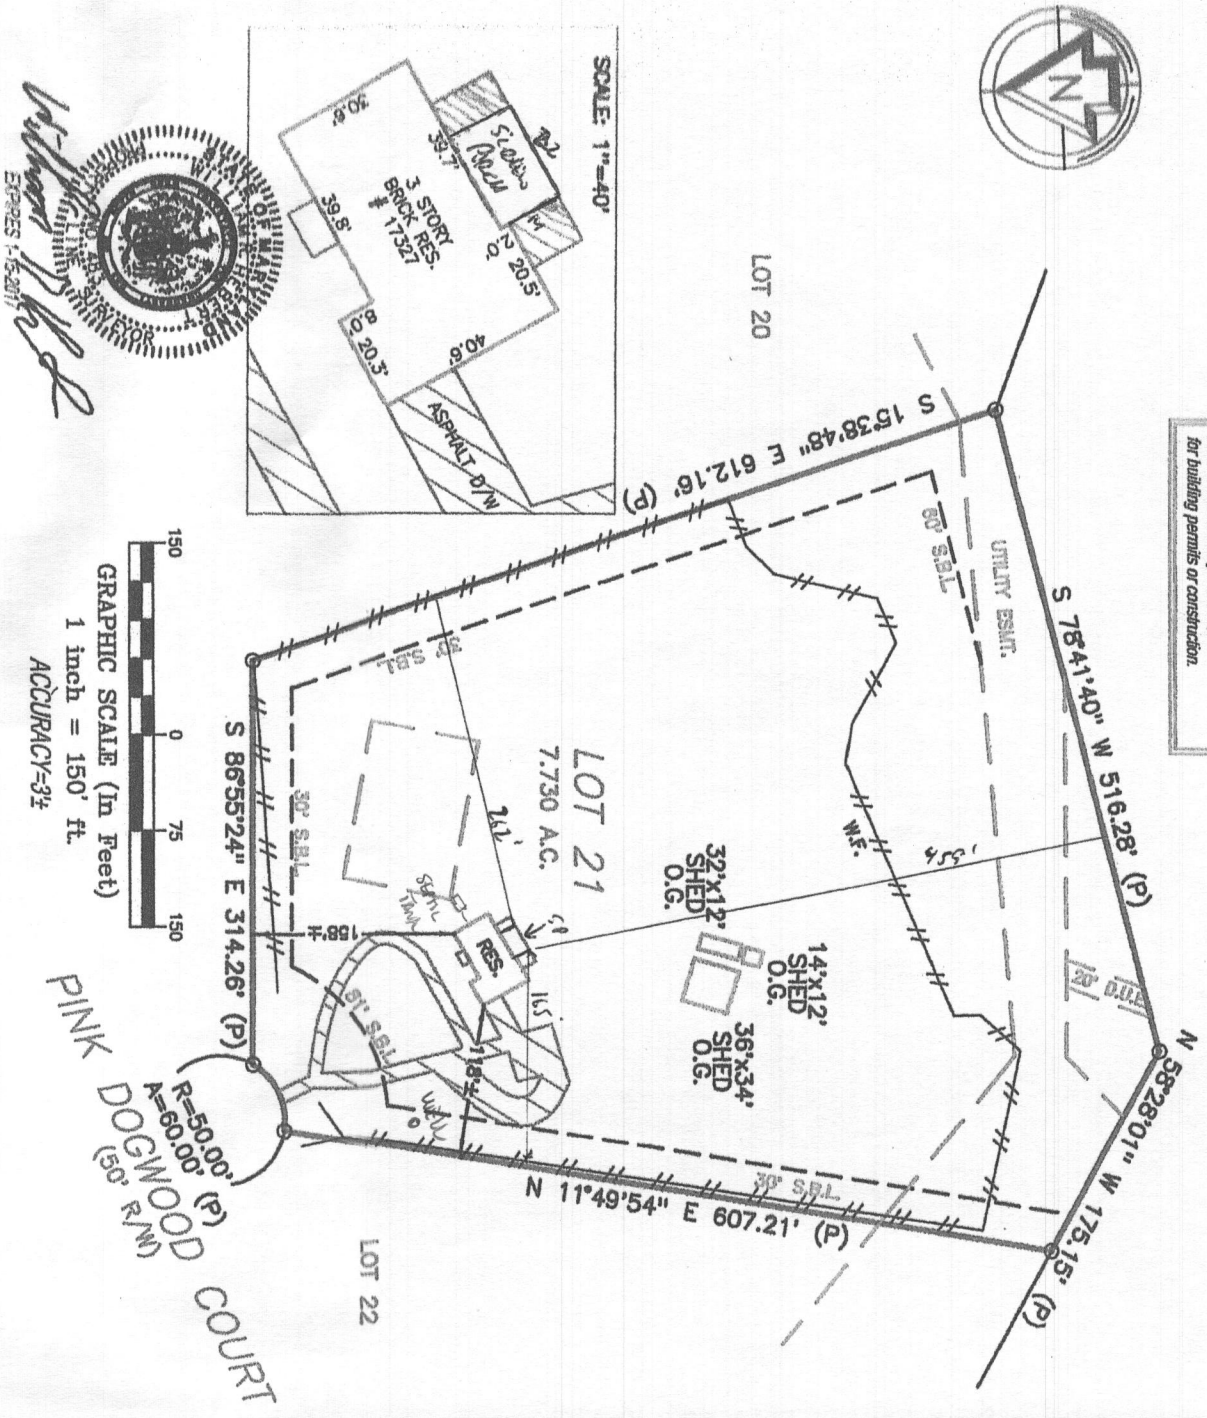

POINTS OF INTEREST:
NONE VISIBLE

CLIENT NUMBER: 177089555

DATE: 6/15/2016

BUYER: Adam R. Cascioli and Brittany L. Harper.

SELLER: RONALD L. MESSENHIMER AND KATHE J. MESSENHIMER.

ORDERED TO:
ADAM R. CASCIOLI AND BRITTANY L. HARPER, SAGE TITLE GROUP, LLC,
FIRST AMERICAN TITLE INSURANCE COMPANY, WELLS FARGO BANK, N.A.

Lynn Harper

301.221.9795
301.384.8700 ex 235
lynn.harper@longandfoster.com

LB# 21535

APPROVED

WALKTHRU BUILDING PERMIT


BP# _____ A# _____

APP. SAN Robert Freeman DATE: 5/12/2018
DESC. OF WORK: Build screen

perch on existing 14'x22' Retc

Sheet Number:

1

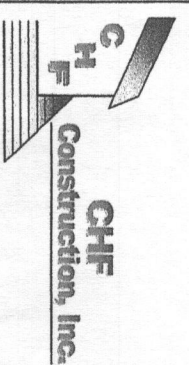

Jeffrey S. Frashure
chfdeckco@verizon.net

16912 Baedenwood Ln
Rockville, MD 20855
301-869-1800

Adam Cascioli & Brittany Harper
17327 Pink Dogwood Ct
Mount Airy, MD 21771

Date:
7/30/18