

4-12' Holed
on 10, 000 ft
Preliminary

APPLICATION

A 19170

SEWAGE DISPOSAL TESTING

P _____

STATE OF MARYLAND - DEPARTMENT OF HEALTH AND MENTAL HYGIENE

HOWARD COUNTY HEALTH DEPARTMENT
ENVIRONMENTAL HEALTH SERVICES

DISTRICT 3

P. O. BOX 476, ELLICOTT CITY, MARYLAND 21043
TELEPHONE: 465-8000, EXT. 356

DATE 10/31/73

3/20/74
~~4/24/74~~
9:30
No pers not
sure what father
wants
CBS.

TO: THE COUNTY HEALTH OFFICER
ELLICOTT CITY, MARYLAND

I, HEREBY, APPLY FOR THE NECESSARY TEST IN ORDER TO CONSTRUCT (OR RECONSTRUCT) A SEWAGE DISPOSAL SYSTEM.

PROPERTY OWNER Peter Carey - Contract Purchaser

Any questions call:

ADDRESS Old Frederick Road, Ellicott City, Md. PHONE 465-8500

Mrs. Swec

PROPERTY LOCATION:

SUBDIVISION _____ LOT NO. _____

ROAD AND DESCRIPTION Pfefferkorn Road - 1 1/2 mile from Rt. 32

(Someone will meet you at corner of Pfefferkorn Rd. & Old Rowler Rd.)

SIZE OF LOT 5.00 acres TYPE BLDG. 3 or 4

NUMBER OF BEDROOMS
(Single Fmly. twllg.)

IF NOT SINGLE RESIDENCE DESCRIBE _____

THE SYSTEM INSTALLED UNDER THIS APPLICATION IS ACCEPTABLE ONLY UNTIL PUBLIC FACILITIES BECOME AVAILABLE.

SIGNATURE OF APPLICANT F. Helms Swec


APPROVED BY _____ FOR _____ DATE _____

REJECTED BY R. Moore FOR Any DATE 3/20/74

HOLD PENDING FURTHER TESTS _____ DATE _____

REASONS FOR REJECTION OR HOLDING _____

THIS IS NOT A PERMIT

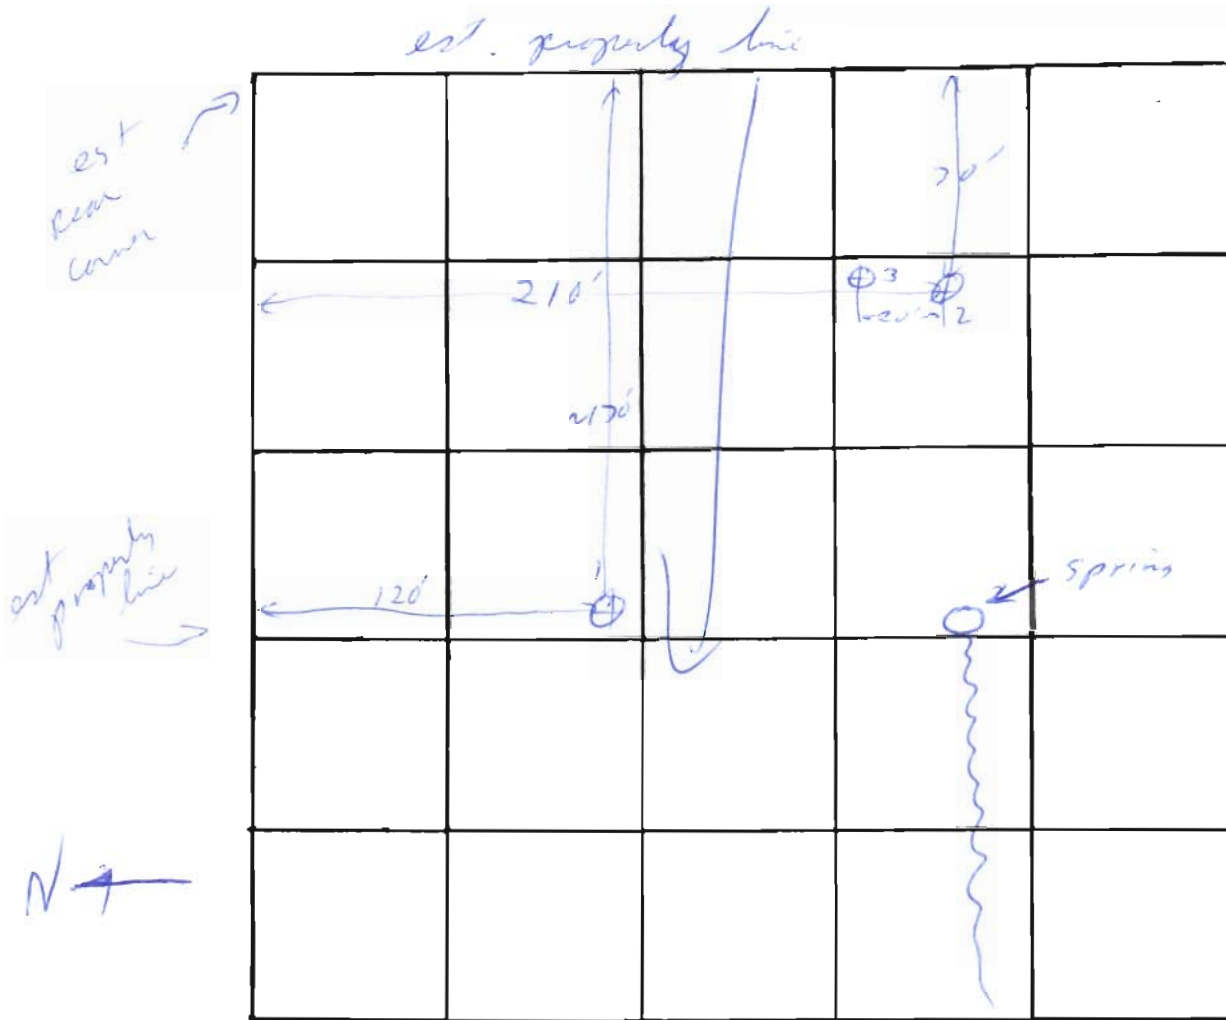

INDICATE NORTH - NAME ADJOINING ROADWAY AS BASE LINE


DATE	TEST NO.	DEPTH	PRE-WET		TEST - 1" DROP		TIME
			START	STOP	START	STOP	
3/20	1	9'	Water	@ 8'	@ 3'	/ all clay	
"	2	10'	"	@ 10'	clay from ~ 3'		
"	3	4'	11:10	>	30 min		

REMARKS

TYPE OF SOIL

clay

2m & F.S.

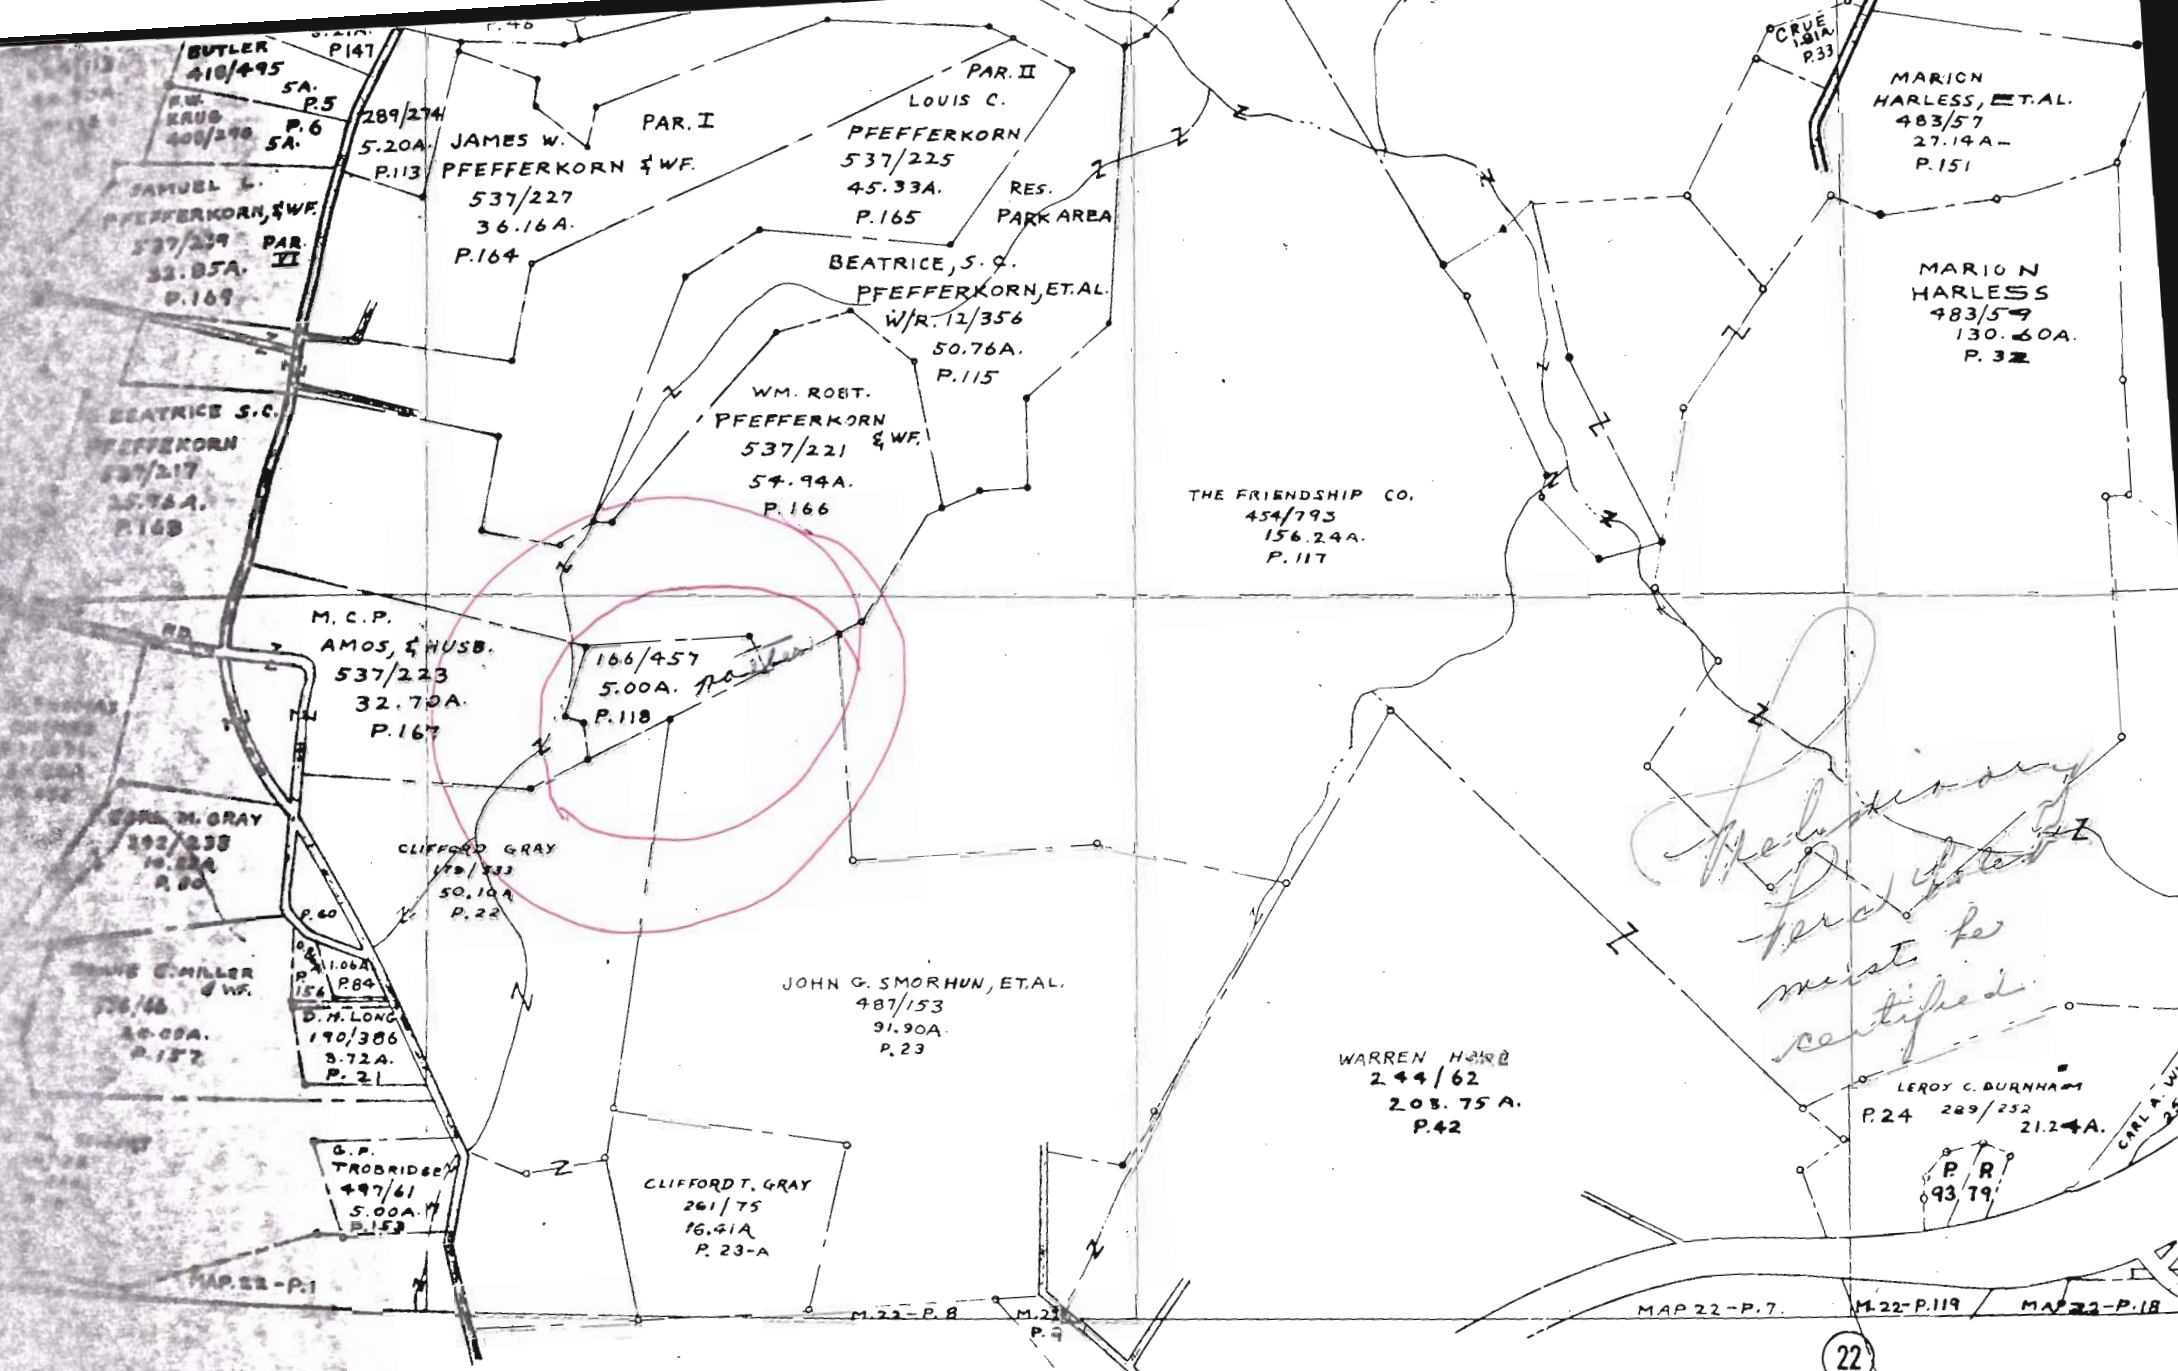

Religious trust to be certified.

Florida - Map