

10/11/18 - Reviewed & Approved H.O.

Menu Save Reset Cancel Help

Record Detail \* (This section is required.)

Permit Type	Permit Number	Opened Date
Building/Residential/Misc/Deck	B18003467	10/10/2018
Description of Work		
SFD/ CONSTRUCT 14' X 28' OPEN DECK WITH STEPS		

check spelling

Address \* (This section is required.)

Search Reset Clear Get Parcel & Owner

Street #	Street Name	Street Type	
1036	FAIRLANE	RD	
Unit Type	Unit #	X Coordinate	Y Coordinate
-Select-		-77.04383	39.34135
City	State	Zip Code	Primary
WOODRIF	MD	21797	Yes

Parcel \* (This section is required.)

Search Reset Clear Get Address & Owner

GIS ID *	Parcel	Parcel Area	Land Value	Improved Value	Exemption Value	Plan Area
11058164	8.17	0	0	0	0	RURAL
Legal Description						

check spelling

Block	Lot	Census Tract	Council Dist	Supervisor Dist	Map #	DAP Zone	Primary
	23	604001	5				Yes
Plan Area	State Tax Id	Subdivision Name					
		Fairlane Farm					
Section	Area	Tax Map					
		8					
Grid	Zoning District	ADC Map					
8-2	RC-DFO	4692-C6					
SDP No.	Final Plan No.	WP File No.					
	ECP-14-003						
Record Plat No.	WS Contract No.	FDP No.					
24367-2437							
Owner Occupied	Year Built	Historic District					
<input type="radio"/> Yes <input type="radio"/> No		<input type="radio"/> Yes <input checked="" type="radio"/> No					
Historic District Registry No.	Stat Area	Flood Plain					
	4-02	<input type="radio"/> Yes <input checked="" type="radio"/> No					
Building No							

Owner \* (This section is required.)

Search Reset Clear

Name *		
IGREGG STOEHR		
Address Line 1		
1036 FAIRLANE RD		
Address Line 2		
Address Line 3		
Mail City	Mail State	Mail Zip Code

WOODBINE MD 21797  
 Phone Primary  
 410-984-4660 Yes  
 E-mail  
 Cell Number Fax Number

Professionals (This section is not required.)

Search Reset Clear

License # \* Business Name  
 08010020247 PRO BUILT CONSTRUCTION  
 License Type \* First Name Middle Name Last Name  
 MHIC Ind EDWARD PACYLOWSKI  
 Primary Address Line 1  
 Yes 13330 CLARKSVILLE PIKE  
 Address Line 2  
 City State ZIP Code  
 HIGHLAND MD 20777-9701  
 Phone 1 Phone 2 Fax  
 3018540821 3018549632  
 E-mail  
 EDWARD@PROBUILTCONSTRUCTION.COM

Applicant (This section is not required.)

Search As Owner As Lic. Prof As Contact

Type \* First Name MI Last Name  
 Applicant EDWARD PACYLOWSKI  
 Relationship Full Name  
 Applicant EDWARD PACYLOWSKI  
 Primary Organization Name  
 Yes PRO BUILT CONSTRUCTION  
 Street Address  
 13330 CLARKSVILLE PIKE  
 Address Line 2  
 City State Zip Code  
 HIGHLAND MD 20777-9701  
 Phone Cell Fax  
 3018540821 3018549632  
 E-mail \*  
 EDWARD@PROBUILTCONSTRUCTION.COM

Addl Info

Est Construction Cost \* Housing Units \* Number of Buildings \* Public Owned  
 12000 0 0 No  
 Construction Type  
 434 - Additions, Alterations, and Conversions - Residential

MISC PERMIT INFO


MISCELLANEOUS PERMIT INFORMATION

Capital Project-No Fee \* Capital Project Number Fee Exempt \* Roadside Tree Project Permit \* Roadside Tree Project Permit #  
 O Yes @ No O Yes @ No O Yes @ No  
 Existing Use \* Water Sewage Expiration Date  
 SFD Privat Privat 4/9/2019

PAYMENT INFORMATION

Check 1 Payee 1 Check 2 Payee 2 SAP Doc No SAP Entered  
 N/A ONLINW PAYMENT

Submit Cancel

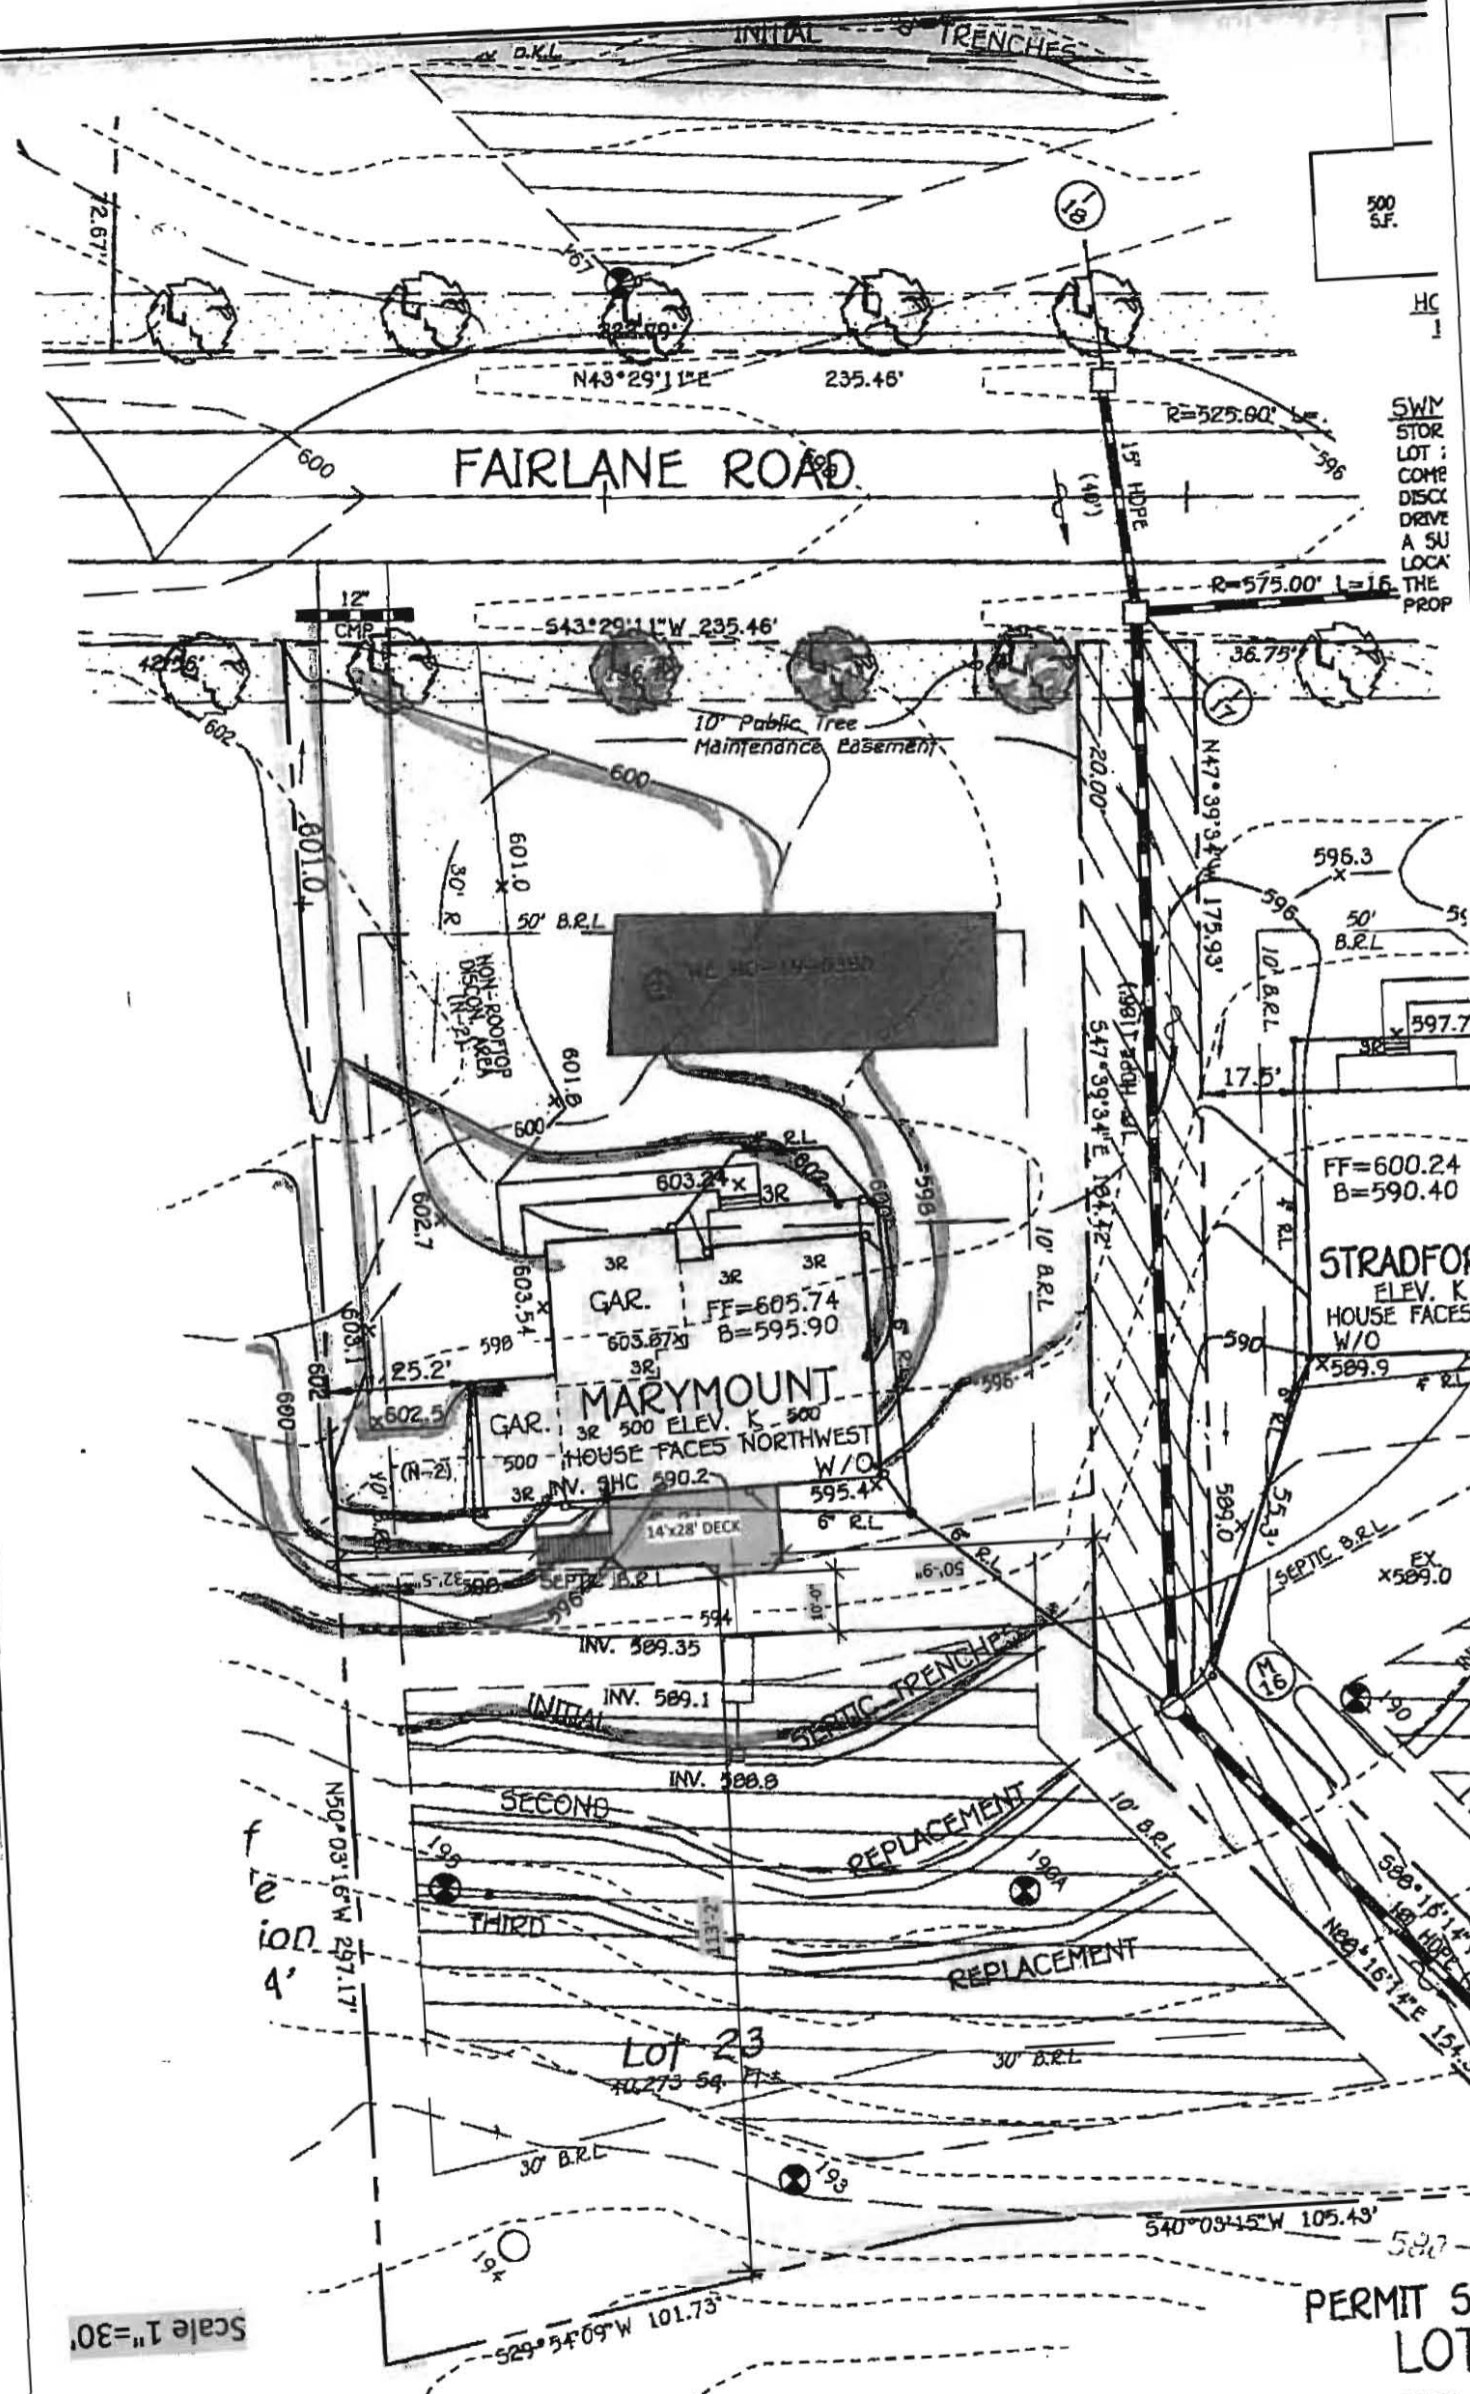

SWY  
STOR  
LOT :  
COME  
DISC  
DRIVE  
A SU  
LOCK  
THE  
PROP

FF=600.24  
B=590.40  
**STRADFOR**  
ELEV. K  
HOUSE FACES  
W/O

**MARYMOUNT**  
GAR. 3R  
FF=605.74  
B=595.90  
500 ELEV. K  
HOUSE FACES NORTHWEST  
W/O  
3R INV. 3HC 590.2  
595.4X

PERMIT SITE  
**LOT 2**  
1036 FAIRLANE  
**FAIRLANE F**

**OWNER/DEVELOPER**  
NV HOMES  
9720 PATUXENT WOODS DRIVE  
COLUMBIA, MD 21046  
410-379-5956

**NOTE:** THE EXISTING WELL SHOWN ON THIS PLAN, HO-15-0360, HAS BEEN FIELD LOCATED BY FISHER, COLLINS & CARTER, INC., PROFESSIONAL LAND SURVEYORS AND IS ACCURATELY SHOWN.

Scale 1"=30'