

8/8/74  
9:30  
8/12/74 \* 57  
11:00  
11:30  
Thompson

File Final

# PERMIT

P 20469

SEWAGE DISPOSAL SYSTEM

A \_\_\_\_\_

MARYLAND STATE DEPARTMENT OF HEALTH

HOWARD COUNTY

ELLICOTT CITY

## INDEXED

DISTRICT 3

DATE 8/7/74

Paul C. Thompson & Sons IS PERMITTED TO INSTALL ALTER X

ADDRESS Brown Bridge Road, Highland, Md. 20777 PHONE 286-2279

A SEWAGE DISPOSAL SYSTEM LOCATED AT \_\_\_\_\_

SUBDIVISION \_\_\_\_\_ ROAD Pfefferkorn LOT \_\_\_\_\_

PROPERTY OWNER Lundy pass Lyons nursery - 1st place on right

ADDRESS \_\_\_\_\_

SPECIFICATIONS

TRENCH DRAIN FIELD 12' DEPTH 9 FEET, BOTTOM AREA 8 SQ. FT. 2 FT WIDE GRAVEL

SEEPAGE PITS \_\_\_\_\_ ABSORBENT SIDE-WALL AREA 810 SQ. FT.

SEPTIC TANK CAPACITY 750 EXISTING GALLONS

FOR GARBAGE GRINDER, INCREASE DISPOSAL AREA 22% & TANK CAPACITY 50%.

OTHER REPAIR - Call for inspection when ground is opened up so Sanitarian can recommend repair system.


look for spec on back of sheet.

PLANS APPROVED BY Palmer F. Wine DATE 8/7/74

FILL SEPTIC TANK AND DISTRIBUTION BOX WITH WATER BEFORE CALLING FOR AN INSPECTION. COVER NO WORK UNTIL INSPECTED AND APPROVED.

NEITHER THE HOWARD COUNTY COMMISSIONERS NOR THE HEALTH DEPARTMENT IS RESPONSIBLE FOR THE SUCCESSFUL OPERATION OF ANY SYSTEM.

P 20469

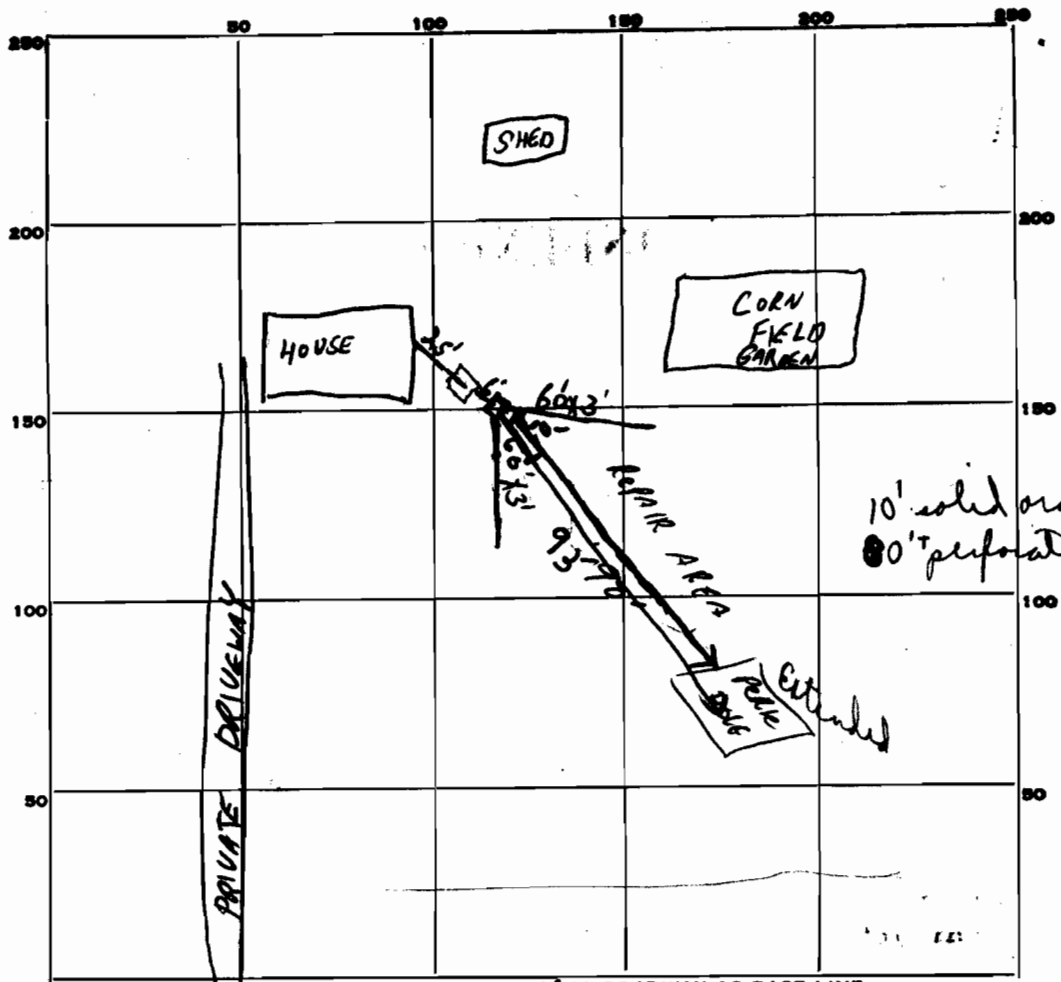

INDICATE NORTH. - NAME ADJOINING ROADWAY AS BASE LINE.

Pfeffakom Road

PERMIT CARD R 20469 Sealed

SEPTIC TANK, LEVEL gusting 750 allora CLEANOUTS \_\_\_\_\_

DISTRIBUTION BOX, LEVEL gusting

TILE FIELD, DEPTH \_\_\_\_\_ FT. TRENCH WIDTH 2 FT.

GRAVEL DEPTH 9ft FT TOTAL LENGTH 90' FT.

NUMBER OF TRENCHES 1 TOTAL BOTTOM AREA 810 sq ft.

SEEPAGE PITS, INSIDE DIAMETER \_\_\_\_\_ FT. DEPTH BELOW INLET \_\_\_\_\_ FT.

ABSORBENT AREA 810 SQ. FT.

REMARKS put T line off of one gusting trench, no other outlet for line in D.B. Spec: 1 trench 2ft wide (810 sq FT) 90ft long, 9ft of gravel, call for inspection before putting in gravel. 4/12 8/12/74 Checked gravel in trench. from 13' up to 4' from surface. Trench 83' long, installed pipe while excavator present. extended trench 10'.

② Covered pipe with gravel + unrolled paper. Filled 1 solid, 8 perforated

DATE SYSTEM APPROVED 8/12/74 INSPECTOR C. Stresker