

Free

APPLICATION

SEWAGE DISPOSAL TESTING

STATE OF MARYLAND - DEPARTMENT OF HEALTH AND MENTAL HYGIENE

HOWARD COUNTY HEALTH DEPARTMENT
ENVIRONMENTAL HEALTH SERVICES

P. O. BOX 476 ELLICOTT CITY, MARYLAND 21043
TELEPHONE: 992-2330

A 32539

P _____

DISTRICT 5th

DATE 3-8-83

158 # / Bedroom
3 BR - 414 # total
inlet mat. 3 1/2 ft.
Total depth max. 9 ft.

TO: THE COUNTY HEALTH OFFICER
ELLICOTT CITY, MARYLAND

I HEREBY APPLY FOR THE NECESSARY TEST IN ORDER TO CONSTRUCT (OR RECONSTRUCT) A SEWAGE DISPOSAL SYSTEM.

PROPERTY OWNER Archie W. Broadwater *Contract purchaser* Caren L. Cleverger-Edwards
ADDRESS part of 5435 Broadwater lane PHONE (301) 469-6040

PROPERTY LOCATION: BROAD WATER FARMS
SUBDIVISION part of 5435 Broadwater lane LOT NO. Approx 1 Acre - for homesite
LOT 1

5455
ROAD AND DESCRIPTION 5435 Broadwater lane

Clarksville, Md
of the Approx 55 Acres a 1 Acre homesite to be recorded seperate
SIZE OF LOT _____ TYPE BLDG. _____
(NUMBER OF BEDROOMS) 3

THE SYSTEM INSTALLED UNDER THIS APPLICATION IS ACCEPTABLE ONLY UNTIL PUBLIC FACILITIES BECOME AVAILABLE. I FULLY UNDERSTAND THE FEE CONNECTED WITH THE FILING OF THIS PERC TEST APPLICATION IS NON-REFUNDABLE UNDER ANY CIRCUMSTANCES. I ALSO AGREE TO COMPLY WITH ALL M.O.S.H.A. REQUIREMENTS IN TESTING THIS LOT.

Caren L. Cleverger-Edwards
(SIGNATURE OF APPLICANT)

APPROVED BY _____ FOR _____ DATE _____

REJECTED BY _____ FOR _____ DATE _____



HOLD PENDING FURTHER TESTS _____ DATE _____

REASONS FOR REJECTION OR HOLDING _____
B.P. # 64322
Signed 4-23-85

THIS IS NOT A PERMIT

← TO BOARDWALK LANE
PROP LINE

CORNER
BENCH
MARK

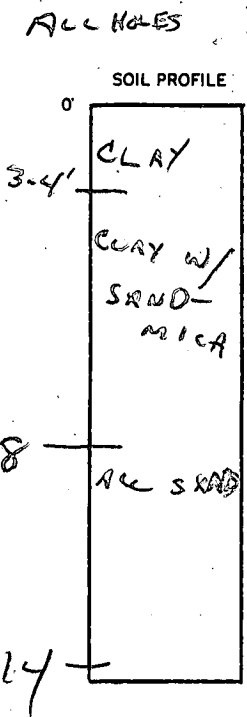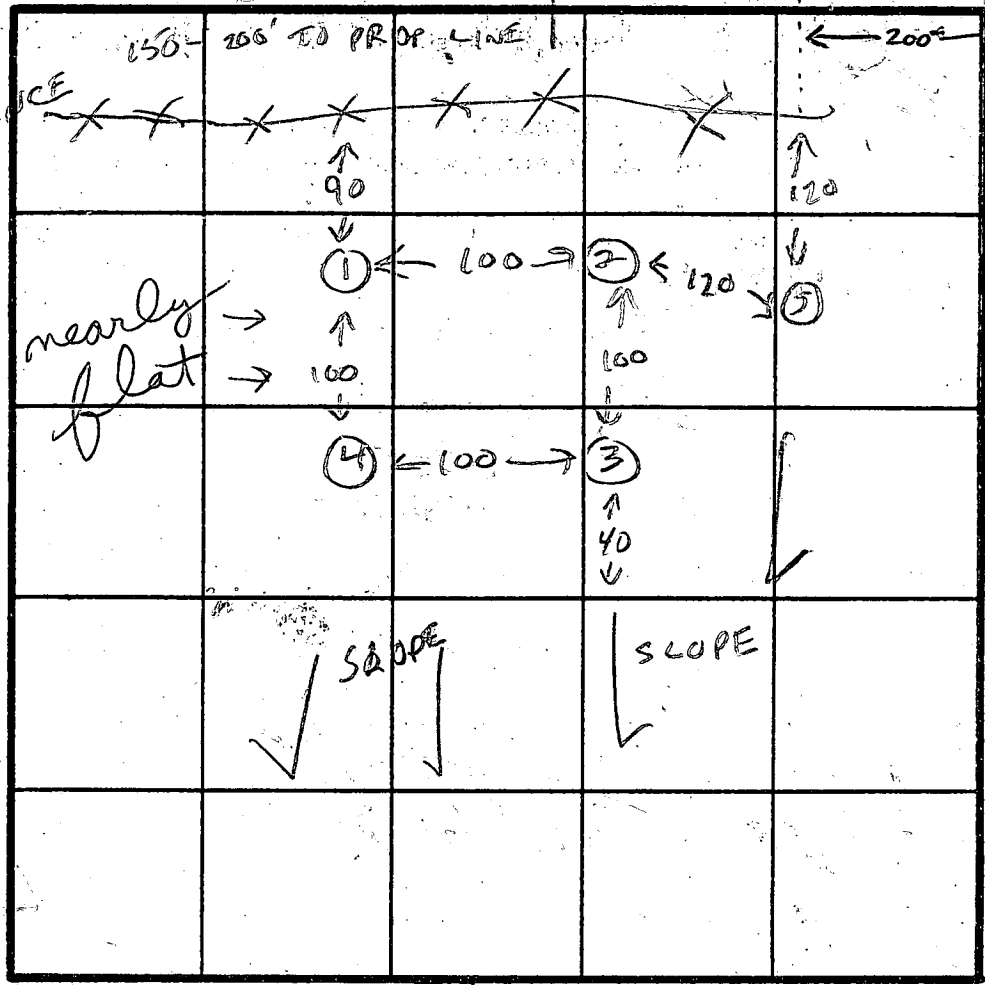

INDICATE NORTH - NAME ADJOINING ROADWAY AS BASE LINE.

HIGHEST

DATE	TEST NO.	DEPTH	PRE-WET		TEST - 1" DROP		TIME
			START	STOP	START	STOP	
3-9-83	1	A	10:42	10:44	10:44	10:48	4 min
		B	10:42	10:44	10:44	10:46	2 min
		C	14	SAND-MICA			
3-9-83	2	3					
		9	VISUAL SAND				
3-9-83	3	3 1/2	10:57	11:01	11:01	11:07	6 min
		9	VISUAL SAND				
3-9-83	4	3	No movement				X
		8	11:24	11:28	11:28	11:37	9 min
		14	- SAND				

REMARKS ANYWHERE ON RIDGE OR 4'-9'

TYPE OF SOIL CLAY TOP THEN CLAY MIXED W/ SAND & MICA

TESTED BY C. Williams ALSO PRESENT MIKE SKIPPER
CAREN EDWARDS

EH-12-1079

Pres.

APPLICATION

A 32539

SEWAGE DISPOSAL TESTING

STATE OF MARYLAND - DEPARTMENT OF HEALTH AND MENTAL HYGIENE

P _____

HOWARD COUNTY HEALTH DEPARTMENT
ENVIRONMENTAL HEALTH SERVICES

DISTRICT 5th

P. O. BOX 476 ELLICOTT CITY, MARYLAND 21043
TELEPHONE: 992-2330

DATE 3-8-83

TO: THE COUNTY HEALTH OFFICER
ELLICOTT CITY, MARYLAND

I HEREBY APPLY FOR THE NECESSARY TEST IN ORDER TO CONSTRUCT (OR RECONSTRUCT) A SEWAGE DISPOSAL SYSTEM.

PROPERTY OWNER Albie W. Broadwater *Contract Purch. Casen h. Cleunges - Edward*
ADDRESS 5435 Broadwater Lane PHONE (301) 469-6040

PROPERTY LOCATION:

SUBDIVISION part of 5435 Broadwater Ln - Approx 1 Acre - for LOT NO. _____
homesite
ROAD AND DESCRIPTION 5435 Broadwater Lane

Clarksville, Md
of the Approx 55 Acres - a 1/2 Acre homesite to be recorded separately
SIZE OF LOT _____ TYPE BLDG. _____
(NUMBER OF BEDROOMS) 3

THE SYSTEM INSTALLED UNDER THIS APPLICATION IS ACCEPTABLE ONLY UNTIL PUBLIC FACILITIES BECOME AVAILABLE. I FULLY UNDERSTAND THE FEE CONNECTED WITH THE FILING OF THIS PERC TEST APPLICATION IS NON-REFUNDABLE UNDER ANY CIRCUMSTANCES. I ALSO AGREE TO COMPLY WITH ALL M.O.S.H.A. REQUIREMENTS IN TESTING THIS LOT.

Paul J. Perry - Edwards
(SIGNATURE OF APPLICANT)

APPROVED BY _____ FOR _____ DATE _____


REJECTED BY _____ FOR _____ DATE _____

HOLD PENDING FURTHER TESTS _____ DATE _____

REASONS FOR REJECTION OR HOLDING _____

THIS IS NOT A PERMIT

SOIL PROFILE

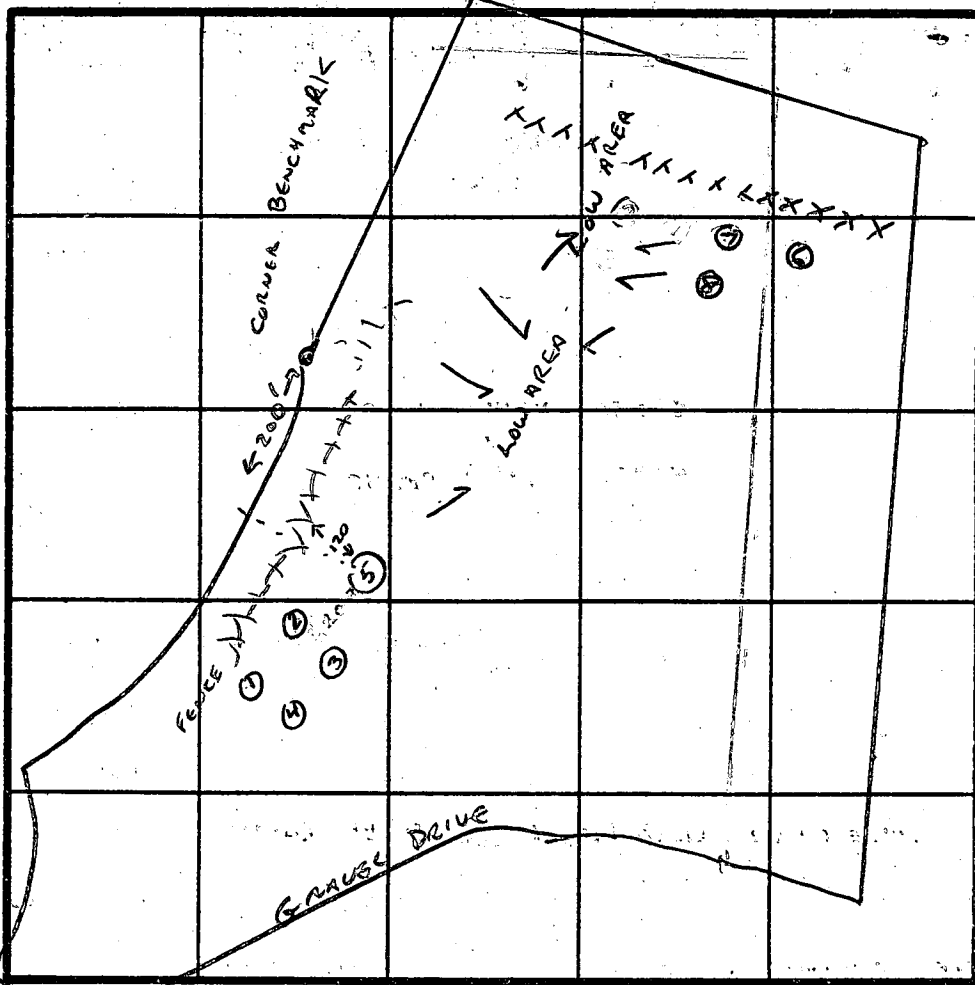

INDICATE NORTH - NAME ADJOINING ROADWAY AS BASE LINE.

DATE	TEST NO.	DEPTH	PRE-WET		TEST - 1" DROP		TIME
			START	STOP	START	STOP	
2-9-83							

REMARKS SEE OTHER PAGE FOR DETAILS

TYPE OF SOIL CLAY. TOP THEN CLAY MIXED W/ MICA - SAND

TESTED BY C. Williams ALSO PRESENT SKIP

RAREN EDWARDS

EH-12-1079