



# APPLICATION

## FOR PERCOLATION TESTING AND SITE EVALUATION

TEST DATE(S) \_\_\_\_\_ TEST TIME \_\_\_\_\_ APR 5 23 269

AGENCY REVIEW: \_\_\_\_\_ DATE 9/7/05

DO NOT WRITE ABOVE THIS LINE

I HEREBY APPLY FOR THE NECESSARY TESTING/EVALUATION PRIOR TO ISSUANCE OF SEWAGE DISPOSAL SYSTEM PERMIT(S) TO:

CHECK AS NEEDED:

- CONSTRUCT NEW SEPTIC SYSTEM(S)
- REPAIR/ADD TO AN EXISTING SEPTIC SYSTEM
- REPLACE AN EXISTING SEPTIC SYSTEM

CHECK AS NEEDED:

- NEW STRUCTURE(S)
- ADDITION TO AN EXISTING STRUCTURE
- REPLACE AN EXISTING STRUCTURE

CHECK ONE:

- CREATE NEW LOT(S)
- BUILD ON AN EXISTING LOT IN A SUBDIVISION
- BUILD ON AN EXISTING PARCEL OF RECORD

IS THE PROPERTY WITHIN 2500' OF ANY RESERVOIR?

- YES
- NO

THE TYPE OF STRUCTURE IS:

- RESIDENTIAL WITH 4705 PROPOSED BEDROOMS IN THE COMPLETED STRUCTURE (NOTE *UNKNOWN* IF APPROPRIATE)
- COMMERCIAL (PROVIDE DETAIL OF NUMBERS AND TYPES OF EMPLOYEES/ CUSTOMERS ON ACCOMPANYING PLAN)
- INSTITUTIONAL/GOVERNMENT (PROVIDE DETAIL OF NUMBERS AND TYPES OF EMPLOYEES/USERS ON ACCOMPANYING PLAN)

PROPERTY OWNER(S) MRS. WILLIAM A. SCHULTE

DAYTIME PHONE 410 443-367-0422 CELL \_\_\_\_\_ FAX 443-367-0420

MAILING ADDRESS 5300 VORSEY HALL DR. ELLICOTT CITY, MD 21042  
STREET CITY/TOWN STATE ZIP

APPLICANT LAND DESIGN & DEVELOPMENT LLC

DAYTIME PHONE 443-367-0422 CELL \_\_\_\_\_ FAX 443-367-0420

MAILING ADDRESS 5300 VORSEY HALL DR #102 ELLICOTT CITY, MD 21042  
STREET CITY/TOWN STATE ZIP


APPLICANT'S ROLE: DEVELOPER BUILDER BUYER RELATIVE/FRIEND REALTOR CONSULTANT

PROPERTY LOCATION  
SUBDIVISION/PROPERTY NAME SCHULTE PROPERTY NORTH SIDE LOT NO. 8

PROPERTY ADDRESS 15320 OLD FREDERICK RD WOODBINE MD 21797  
STREET AT MORGAN STATION ROAD TOWN/POST OFFICE


TAX MAP PAGE(S) 8 GRID 223 PARCEL(S) 8217 PROPOSED LOT SIZE 40,500 sq ft

AS APPLICANT, I UNDERSTAND THE FOLLOWING: THE SYSTEM INSTALLED SUBSEQUENT TO THIS APPLICATION IS ACCEPTABLE ONLY UNTIL PUBLIC SEWERAGE IS AVAILABLE. THIS APPLICATION IS COMPLETE WHEN ALL APPLICABLE FEES AND A SUITABLE SITE PLAN HAVE BEEN RECEIVED. I ACCEPT THE RESPONSIBILITY FOR COMPLIANCE WITH ALL M.O.S.H.A. AND "MISS UTILITY" REQUIREMENTS. APPROVAL IS BASED UPON SATISFACTORY REVIEW OF A PERC CERTIFICATION PLAN. TEST RESULTS WILL BE MAILED TO APPLICANT.

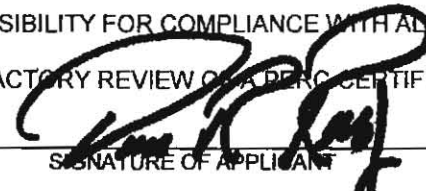  
SIGNATURE OF APPLICANT

HOWARD COUNTY HEALTH DEPARTMENT, BUREAU OF ENVIRONMENTAL HEALTH, WELL AND SEPTIC PROGRAM  
3525-H ELLICOTT MILLS DRIVE, ELLICOTT CITY, MARYLAND 21043-4544 (410) 313-1771 FAX (410) 313-2648  
TDD (410) 313-2323 TOLL FREE 1-877-4MD-DHMH

AP Lot 8

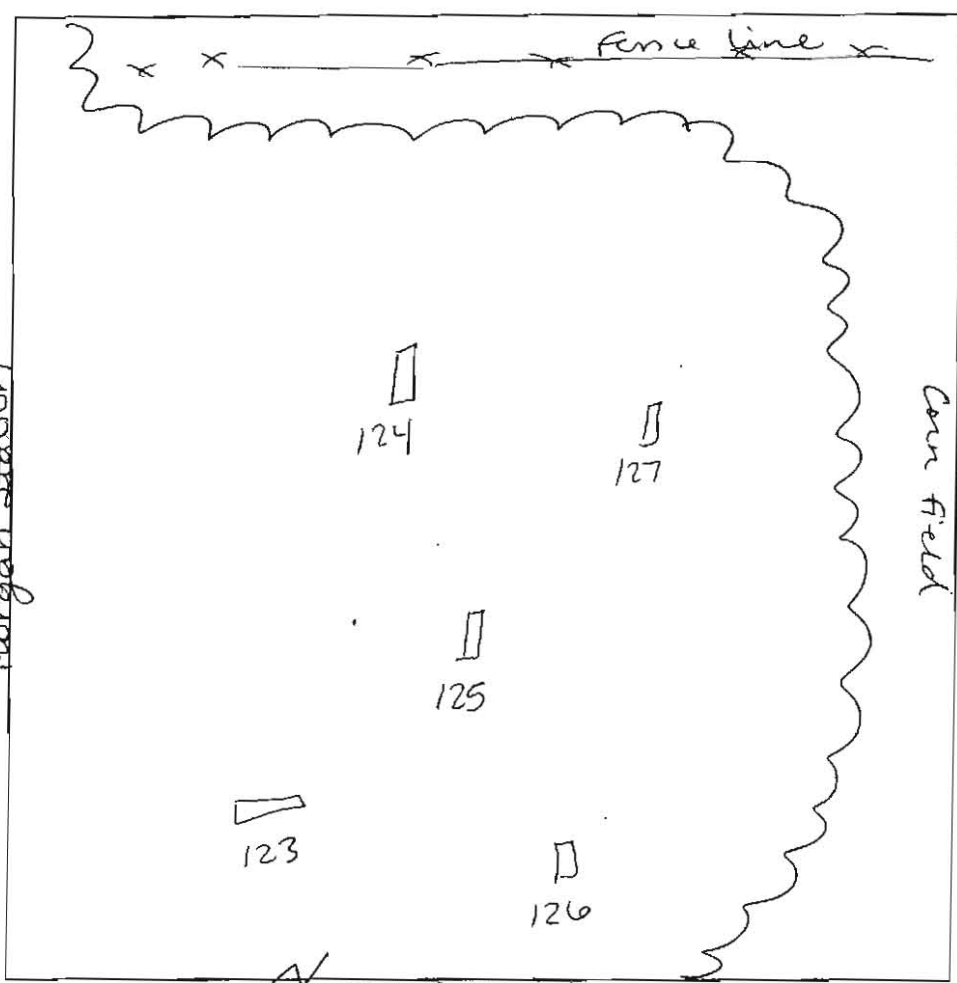

127  
 4" gray brown L roots  
 brownish yellow sil sil sbk 5% gravel  
 3'6" reddish yellow sil sg/sbk compacted in ground 100% gravel/channery  
 9' cobbles 5%

125  
 3' gray brown L reddish yellow sil m <5% gravel  
 brownish yellow/reddish yellow sil sg compact in ground  
 10% chert channery  
 8' yellow sil coarse  
 10% coarse chert

126  
 gray brown sbk L  
 reddish yellow w/ brownish yellow  
 2'5" sil sbk/m 15% gravel  
 3'3" yellow/reddish yellow sil sg 5-10% gravel/chert/channery  
 11" @ bottom 10% coarse chert  
 124  
 gray brown L roots to 4'  
 5" brownish yellow sil  
 3' brownish yellow sil sg 10% chert channery throughout profile  
 11" @ bottom sil/si.

123  
 gray brown L roots sbk  
 1' brownish yellow sil m 10% gravel chert spots  
 3' reddish yellow sil sg well compacted in ground  
 4'5" pink/yellow sil sg  
 11"

DATE	TEST #	DEPTH	START	BREAK 1" DROP	STOP 2" DROP	TIME OF 2nd INCH	P/F/H
11/30/05	127	5' / 12'	9:12	9:15	9:22	7	P
	125	5' / 10'	9:21	9:27	9:37	10	P
	126	5' / 11'	9:29	9:37	9:51	14	P
	124	4'5" / 11'	9:45	9:52	10:00	8	P
	123	4'5" / 11'	10:04	10:07	10:10	3	P

REMARKS Holes staked by surveyor and dug per plan  
 SANITARIAN SF BACKHOE M. Johnson (AEC) OTHERS R. Webster  
 TEST HOLES USED IN SDA \_\_\_\_\_ AVG. PERC TIME 8 SQ. FT/BR \_\_\_\_\_  
 TRENCH WIDTH \_\_\_\_\_ INLET DEPTH \_\_\_\_\_ MAX. BOT DEPTH \_\_\_\_\_ EFFECTIVE SW \_\_\_\_\_

