

FILE INQUIRY NOTES


- 16825 Hardy Road -

DATE	RESULTS OF REVIEW FOR FILE
8/14/18	Call recieved from anonymous person (210-357-6172) who explained septic system was installed on a Saturday (8/4/18) w/o permits. The address of the property they explained was 16825 Hardy Road. → made call to S. Galt who was in the field to stop by and investigate. (KME)
8/14/18	Made a site visit to 16825 Hardy Rd. Spoke with a Hispanic man via his niece who translated. I asked if a septic system was installed over the weekend and he said no. Four truckloads of dirt were hauled in to fill in a depression in the yard, according to the man. A septic c/o was in the area of fresh dirt. The man said they replaced the riser on the septic tank b/c the old one had been allowing water into the tank. From what I understood, they had experienced backing up in the house. The man said water had been collecting in the yard in the area where they spread the dirt. I asked if they ever noticed an odor and he said no. I told them that if they have any problems with their septic to contact our office and gave them my business card. Located well on property (#H0-73-0870). 1-pc cap not secure. Recommended replacing with a 2-piece cap. (SC) [Contacted WTC III contractors. They had been on site within the last year. They said there is a drywell that was full and they had it pumped.]

SITE INSPECTION SHEET

OWNER: _____ PHONE #: _____
ADDRESS: 16825 Hardy Rd. CONTRACTOR: _____
SUBDIVISION: _____ LOT: _____ WELL TAG #: _____
COUNTY #: _____
PROPOSAL: _____

LOCATION DIAGRAM

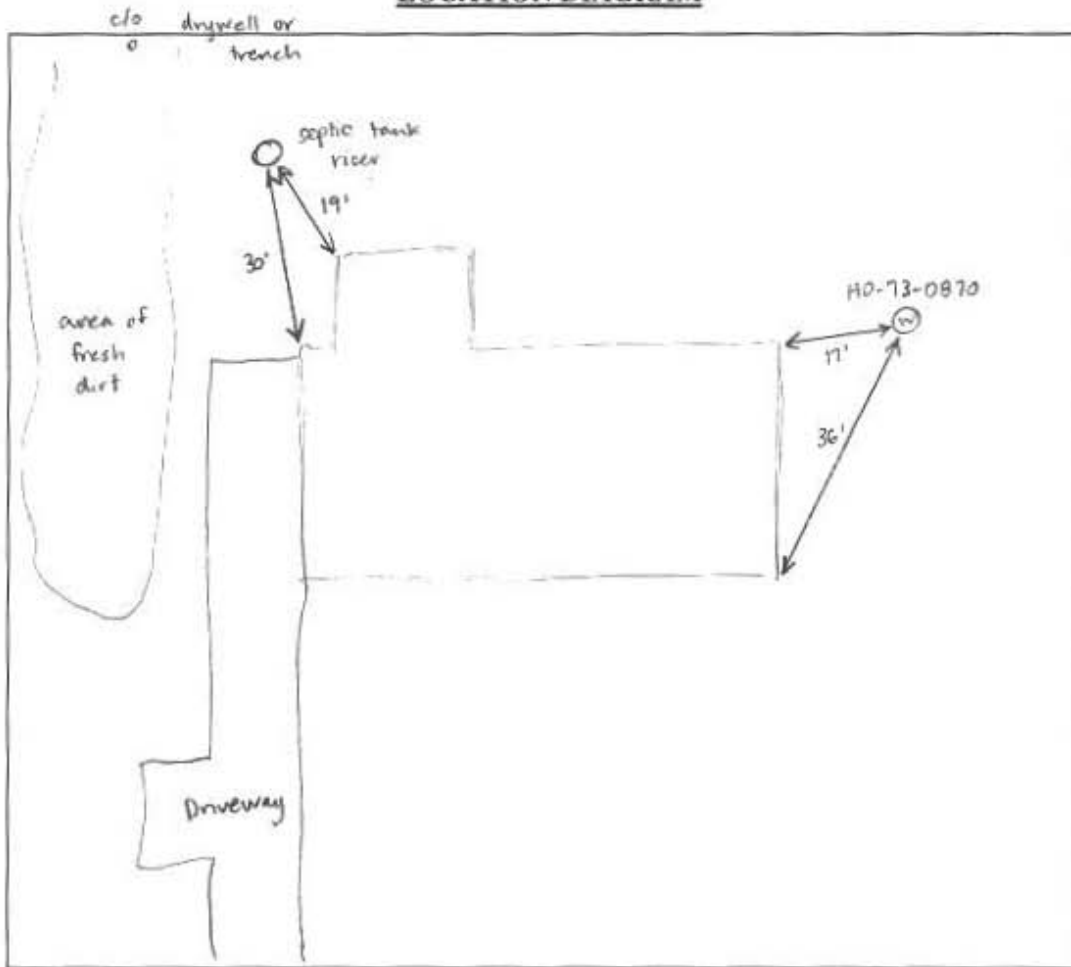

COMMENTS: _____

DATE: 8/14/18 INSPECTOR: Sarah Collins

8/14/18
16825 Hardy Road



New riser on the septic tank

Area of fresh dirt and cleanout (looking north)

