



Bureau of Environmental Health

8930 Stanford Boulevard, Columbia, MD 21045

Main: 410-313-2640 | Fax: 410-313-2648

TDD 410-313-2323 | Toll Free 1-866-313-6300

www.hchealth.org

Facebook: www.facebook.com/hocohealth

Twitter: HowardCoHealthDep

Maura J. Rossman, M.D., Health Officer

APPLICATION FOR PERCOLATION TESTING AND SITE EVALUATION

ASL 10/18

PROPERTY LOCATION

SUBDIVISION/PROPERTY NAME Breezewood Farm

PROPERTY ADDRESS 10639 Breezewood Dr STREET TOWN ZIP

TAX ACCOUNT # TAX MAP GRID PARCEL LOT NO. 8 PROPOSED LOT SIZE (ACRES)

ZONING CATEGORY TIER

PROPERTY OWNER(S) Htin Aung

DAYTIME PHONE CELL 443 844 2437 EMAIL

MAILING ADDRESS 10639 Breezewood Dr WOODSTOCK MD 21163 STREET CITY, STATE ZIP

APPLICANT James Harrison RELATIONSHIP TO OWNER: installer

DAYTIME PHONE CELL 410 596 0057 EMAIL

MAILING ADDRESS STREET CITY, STATE ZIP

I HEREBY APPLY FOR THE NECESSARY TESTING/EVALUATION PRIOR TO ISSUANCE OF SEWAGE DISPOSAL SYSTEM PERMIT(S):

- PROPERTY:
SUBDIVISION: NUMBER OF LOTS INCLUDING RESIDUE:
SUBDIVISION CLASSIFICATION (PER DEPT. OF PLANNING AND ZONING)
MAJOR MINOR
CONSTRUCT NEW OSDS ON UNDEVELOPED LOT
REPAIR OR REPLACE FAILING OSDS
UPGRADE EXISTING OSDS
BUILDING:
RESIDENTIAL WITH EXISTING OR PROPOSED BEDROOMS IN THE COMPLETED STRUCTURE
COMMERCIAL (PROVIDE DETAIL OF TYPE OF USE AND NUMBERS OF EMPLOYEES/CUSTOMERS ON ACCOMPANYING PLAN)
IS THE PROPERTY WITHIN 2500 FEET OF ANY RESERVOIR?
YES
NO

- AS APPLICANT, I UNDERSTAND THE FOLLOWING:
THIS APPLICATION IS VALID FOR TWO(2) YEARS FROM DATE OF FEE PAYMENT AND APPROVAL IS BASED UPON HEALTH OFFICER SIGNATURE OF A PERC CERTIFICATION PLAN PRIOR TO EXPIRATION OF THIS PERMIT.
THE APPLICATION FEE IS NON-REFUNDABLE
THIS APPLICATION MUST BE ACCOMPANIED BY ALL APPLICABLE FEES AND A SUITABLE SITE PLAN IN ORDER TO BE PROCESSED
THIS IS A PUBLIC DOCUMENT

I declare and affirm that to the best of my knowledge, the information contained herein is correct. I declare that I am the owner of the property or duly authorized to make this application on behalf of the owner. I agree to comply with all applicable state and county regulations.
By signature of this application, I hereby grant Howard County Health Department officials the right to enter onto the property for the purpose of inspecting the property as directly related to the requested permit/service.
SIGNATURE OF APPLICANT DATE 10/3/15


A/P

H0-73-1747

(A)
 0 dk brn loam
 mbrk roots
 4" brn sl
 mica roots
 1' brn cl
 sticky roots mica
 4" red brn scl
 30-40% rock roots many mica
 5" red brn sl
 roots many mica dense
 10' Hard Bottom

(B)
 0 dk brn loam
 mbrk roots
 8" lt brn cl
 3.5' brn scl
 5-6' 30-40% rock
 Seepage @ 4.5'
 7' Hard Bottom

(C)
 0 dk brn loam
 mbrk roots
 12" red brn scl platy
 20% rock mica roots
 2' lt brn sl
 many mica roots
 coarse consistent to 9'
 10.5' Moist @ 9'
 Seepage @ 10'

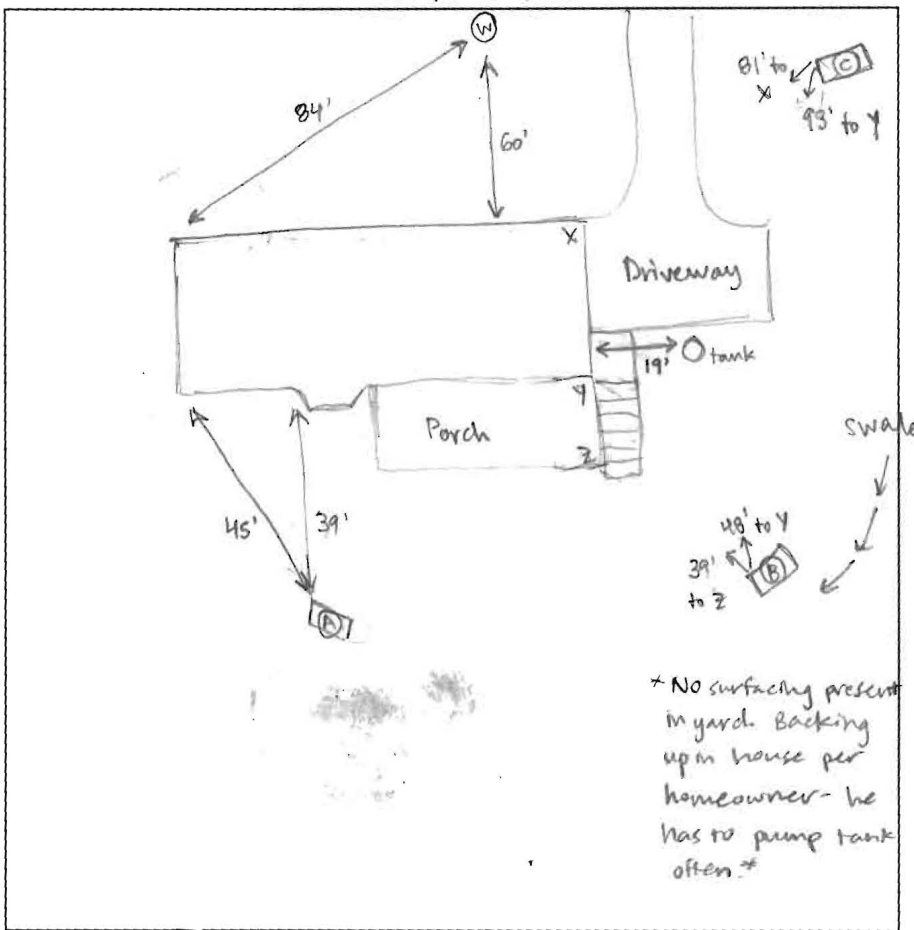

DATE	TEST #	DEPTH	START	BREAK 1" DROP	STOP 2" DROP	TIME OF 2ND INCH	P/F/H
10/16/18	A	6' / 10'	0:00	pulled -	little movement in 10 mins.		
	A	6.5' / 10'	0:00	22:00	55:00	33	
	C	4' / 10.5'	0:00	1:20	3:02	1:42	
	C	repour 4' / 10.5'	0:00	2:12	4:29	2:17	P

REMARKS Holes A + B in swale soils; a system can be installed above hole C 100' + f
 SANITARIAN Sarah Collins BACKHOE James Harrison OTHERS Helper + homeowner (Linn)
 TEST HOLES USED IN SDA C AVG. PERC TIME 2 mins. SQ. FT/BR 3 BR
 TRENCH WIDTH 3' INLET DEPTH 2' MAX. BOT DEPTH 5' EFFECTIVE SW 2-5'



Bureau of Environmental Health
 8930 Stanford Boulevard, Columbia, MD 21045
 Main: 410-313-2640 | Fax: 410-313-2648
 TDD 410-313-2323 | Toll Free 1-866-313-6300
 www.hchealth.org
 Facebook: www.facebook.com/hocohealth
 Twitter: HowardCoHealthDep

Dr. Maura J. Rossman, M.D., Health Officer

INFORMATION FORM – SEPTIC SYSTEM REPAIR/UPGRADE

Reason for Request:

- Failing System
- System relocation for proposed addition
- System upgrade for proposed addition
- Inadequate treatment zone
- Collapsed septic tank
- Collapsed drywell

Has the septic tank been pumped within the last month?

- Yes Date pumped: _____
- No

Was a visual inspection of the septic tank and/or drain fields conducted?

- Yes Explain observations: _____
- No

Was a visual inspection of the sewage line conducted?

- Yes
 - Blockage leading to the tank
 - Yes. Explain: _____
 - No
 - Blockage leading to the field
 - Yes. Explain: _____
 - No

Existing system design

- Drywell
- Trench
- Mound
- Unknown
- Other: _____

Is discharge surfacing on the ground?

- Yes
- No

Additional Comments: Drain Field Failed

*For REPAIRS, are the owners proposing, or do they plan to add in the future, any additions or modifications to the property, i.e. pools, living space additions, garages, etc? This information must be disclosed at the time of this application. The Health Department will not be able to accommodate requests in the field for property modifications unrelated to the repair request. Such requests may require an additional fee, testing, and submittal of a Percolation Certification Plan, if the property does not meet current Code and Regulation.

Septic Contractor: JV Harrison Backhoe Septic Contractor's Phone: _____
 Contractor's Address: 4717 Old Washington Sykesville MD
 Property Address: 10639 Breeze Wood Dr County file: Howard
 Subdivision: Breeze Wood Farms Lot: 8 Year Built: 77
 Owner's Name: HTM A279 Owner's Phone: _____
 Name of previous owners: _____ Existing bedrooms: _____
 Proposed bedrooms: _____

Has this request been previously discussed with a Sanitarian? (Name): no
 Public Sewer available/nearby: N

*A Sanitarian will be in contact within three business days, depending upon the urgency of the situation, to coordinate the scheduling/review of the repair or upgrade.

Prior to scheduling inspections, scaled plans should be submitted to clarify the nature of the addition.

Print out a copy of Real Property Data via Dept. of Taxation website _____ Indexed file found _____

If public sewer may be nearby, verify whether sewer is technically "available" through the Bureau of Engineering.

If sewer is available and the property is within the Metropolitan District, connection to sewer is required; if the owner believes reason for exemption exists, the owner should justify the request in writing.

If soil/site conditions are limited and sewer and/or Metro District status is not conducive to connection, the Sanitarian may recommend pursuit of Emergency Sewer Extension or Emergency Metro District Inclusion. The Owner should contact the Bureau of Utilities for details.

No permit is to be issued nor inspection to be scheduled without prior fee collection at the office unless an emergency situation exists.

The contractor is to notify office of the emergency situation as soon as possible.

*Spoke w/ contractor. System is failing. Tanks dug up. Tank is very deep ~7' to 11' looking @ Monday 10/15 for perc.



HOWARD COUNTY HEALTH DEPARTMENT

64018

DATE 10/3/78

APR 5
596-057

Received From

HTIU LINDA ACING

PHONE #

CASH

CHECK

NO. 570

For

PLUC Repair - 10639
received
Dr

Three hundred thirty Dollars

\$ 330.00

Received By

J King