


SITE INSPECTION SHEET

OWNER: HAIGHT, ALLEN D PHONE #: \_\_\_\_\_  
ADDRESS: 3106 Ellenslie CT CONTRACTOR: \_\_\_\_\_  
Glenwood, MD 21738 WELL TAG #: \_\_\_\_\_  
SUBDIVISION: N/A LOT: 2 COUNTY #: (XIII)  
PROPOSAL: REROUTE WELL LINE FOR POOL INSTALL

LOCATION DIAGRAM

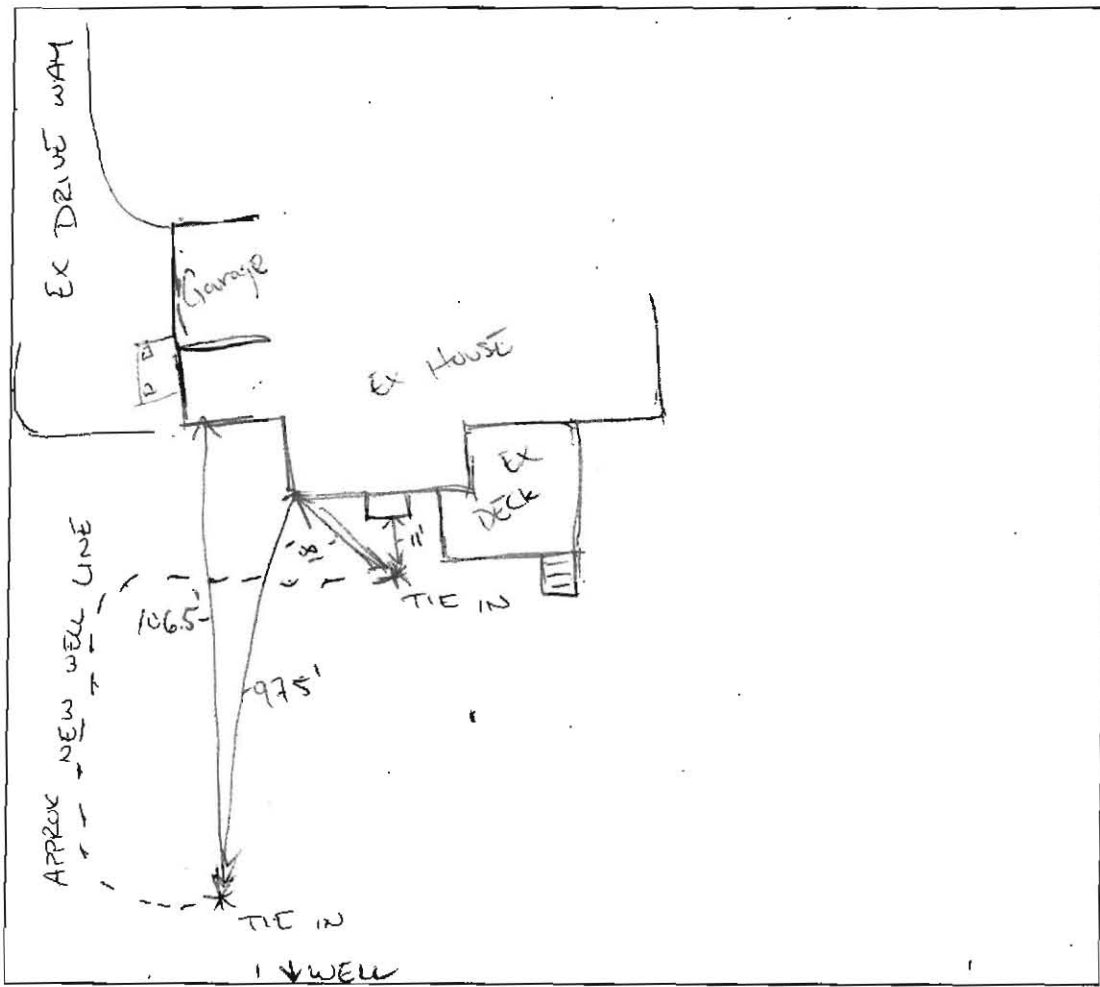

COMMENTS: WATER LINE MEETS FROST DEPTH, REROUTED FOR POOL INSTALL

DATE: 11/16/2018

INSPECTOR: \_\_\_\_\_