

APPLICATION

FOR PERCOLATION TESTING AND SITE EVALUATION

TEST DATE(S) _____ TEST TIME _____

APP 520449-H

AGENCY REVIEW: _____

DATE 10/29/04

DO NOT WRITE ABOVE THIS LINE

I HEREBY APPLY FOR THE NECESSARY TESTING/EVALUATION PRIOR TO ISSUANCE OF SEWAGE DISPOSAL SYSTEM PERMIT(S) TO:

CHECK AS NEEDED:

- CONSTRUCT NEW SEPTIC SYSTEM(S)
- REPAIR/ADD TO AN EXISTING SEPTIC SYSTEM
- REPLACE AN EXISTING SEPTIC SYSTEM

CHECK AS NEEDED:

- NEW STRUCTURE(S)
- ADDITION TO AN EXISTING STRUCTURE
- REPLACE AN EXISTING STRUCTURE

CHECK ONE:

- CREATE NEW LOT(S)
- BUILD ON AN EXISTING LOT IN A SUBDIVISION
- BUILD ON AN EXISTING PARCEL OF RECORD

IS THE PROPERTY WITHIN 2500' OF ANY RESERVOIR?

- YES
- NO

THE TYPE OF STRUCTURE IS:

- RESIDENTIAL WITH unknown PROPOSED BEDROOMS IN THE COMPLETED STRUCTURE (NOTE **UNKNOWN** IF APPROPRIATE)
- COMMERCIAL (PROVIDE DETAIL OF NUMBERS AND TYPES OF EMPLOYEES/ CUSTOMERS ON ACCOMPANYING PLAN)
- INSTITUTIONAL/GOVERNMENT (PROVIDE DETAIL OF NUMBERS AND TYPES OF EMPLOYEES/USERS ON ACCOMPANYING PLAN)

PROPERTY OWNER(S) Carlton E. Heyser, JR.

DAYTIME PHONE _____ CELL _____ FAX _____

MAILING ADDRESS 14526 New Hampshire Ave. Silver Spring, Md. 20904
STREET CITY/TOWN STATE ZIP

APPLICANT Highland Development Corp. Attn: Richard Demmitt

DAYTIME PHONE 410 531 5539 CELL _____ FAX _____

MAILING ADDRESS PO Box 228 Clarksville, Md. 21029
STREET CITY/TOWN STATE ZIP

APPLICANT'S ROLE: DEVELOPER BUILDER BUYER RELATIVE/FRIEND REALTOR CONSULTANT

PROPERTY LOCATION

SUBDIVISION/PROPERTY NAME S. of Scaggsville Rd. (Rt. 216), E. of Browns Bridge Rd. LOT NO. 9

PROPERTY ADDRESS _____
STREET TOWN/POST OFFICE

TAX MAP PAGE(S) 40 GRID 18 PARCEL(S) 178 PROPOSED LOT SIZE 40,224 sf

AS APPLICANT, I UNDERSTAND THE FOLLOWING: THE SYSTEM INSTALLED SUBSEQUENT TO THIS APPLICATION IS ACCEPTABLE ONLY UNTIL PUBLIC SEWERAGE IS AVAILABLE. THIS APPLICATION IS COMPLETE WHEN ALL APPLICABLE FEES AND A SUITABLE SITE PLAN HAVE BEEN RECEIVED. I ACCEPT THE RESPONSIBILITY FOR COMPLIANCE WITH ALL M.O.S.H.A. AND "MISS UTILITY" REQUIREMENTS. APPROVAL IS BASED UPON SATISFACTORY REVIEW OF A PERC CERTIFICATION PLAN. TEST RESULTS WILL BE MAILED TO APPLICANT.

SIGNATURE OF APPLICANT

HOWARD COUNTY HEALTH DEPARTMENT, BUREAU OF ENVIRONMENTAL HEALTH, WELL AND SEPTIC PROGRAM
 3525-H ELLICOTT MILLS DRIVE, ELLICOTT CITY, MARYLAND 21043-4544 (410) 313-1771 FAX (410) 313-2648
 TDD (410) 313-2323 TOLL FREE 1-877-4MD-DHMH

B40a

Not
DUB
FOR
SAFETY
ISSUES
w/
Fract
stand.

587/
B38


587W aka B39
wk platy
Soil structure
to 3', v.
micac
w cemented
Loam-s.l

tan, rdbrn
black,
w cemented
S.g
Trace Rx
10' LS

Densely packed

591

String
red
Si Lm
w/CLAY
SKINS
v.v. wk
Saprolite
@ 6' to 7'
± 25%
v. micac
bl. white ybrn
platy
structure
on N
wall 10'
Bottom
12'

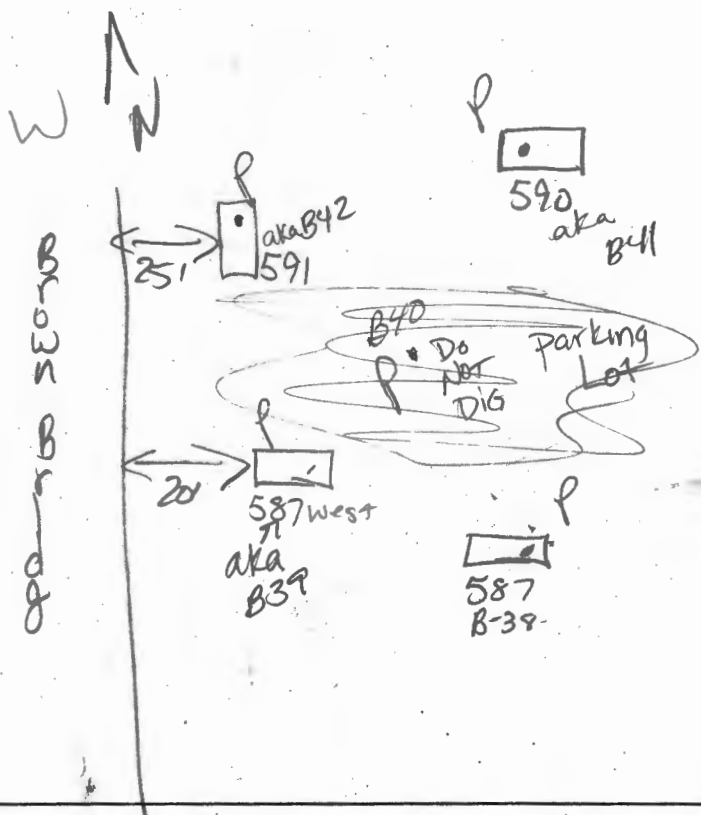

590 aka B41
sbk d
granular
struct to 1'
Loam
2.54R4/G-Red
1/2"
Si L
v. micac
w/ CLAY
in between
Some macropores
w sbk d granular
28'
org brn
wk rdbrn
finegr.
Loam
Trace Rx
1/2'
Bottom

DATE	TEST #	DEPTH	START	BREAK 1" DROP	STOP 2" DROP	TIME OF 2ND INCH	P/F/H
8/2/04	587 ^{B38}	4'	9:04	9:09	9:20	6	P
	B39 587W	4 1/2"	9:08	9:18	9:28	10	P
	aka B42 591	4 1/2'	9:19	9:21	9:23 ⁺	2 ⁺	P
	aka B41 590	3' 2"	9:25 ⁺	9:27	9:30	3 ⁺	P

REMARKS post hole digger size. Holes dug on stake except
ANITARIAN Kacie BACKHOE C. Sharp OTHERS R. Dematt B40

TEST HOLES USED IN SDA _____ AVE. PERC TIME _____ SQ. FT/BR _____
TRENCH WIDTH _____ INLET DEPTH _____ MAX. BOT DEPTH _____ EFFECTIVE SW _____

Keep eye no deeper than 6' bottom

