

PERMIT

SEWAGE DISPOSAL SYSTEM

MARYLAND STATE DEPARTMENT OF HEALTH

HOWARD COUNTY

ELLICOTT CITY

DISTRICT 3rd

DATE 4/5/77

04-334493
INDEXED

P-25561

A 19140

Costello Builders

IS PERMITTED TO INSTALL ALTER

ADDRESS Box 2201 Route 94, Woodbine, Md.

PHONE 442-2288

A SEWAGE DISPOSAL SYSTEM LOCATED AT _____

SUBDIVISION Gwenlee Estates

ROAD 3270 Sharp Road

LOT 13, Blk. A, Sec. 2

PROPERTY OWNER W. L. Boring Theodore & Susan Weiman

ADDRESS Burntwoods Road, Glenwood, Md. 21738

SPECIFICATIONS 4 bedrooms

DRAIN FIELD _____ DEPTH _____ FEET, BOTTOM AREA _____ SQ. FT.

SEEPAGE PITS _____ ABSORBENT SIDE-WALL AREA _____ SQ. FT.

SEPTIC TANK CAPACITY 1250 GALLONS

FOR GARBAGE GRINDER, INCREASE DISPOSAL AREA 22% & TANK CAPACITY 50%.

OTHER TRENCHES - The trenches will begin 15 ft. from the right property line and 120 ft. from the road edge, as seen from the road. The trenches will be 10 ft. deep, 2 ft. wide, contain 5 ft. of stone and follow the contour of the land. There will be a minimum of 195 sq. ft. of sidewall area per bedroom in the trenches. No trench will exceed 75 ft. in length, and all trenches will be connected in series, with each running parallel to the last and spaced 20 ft. apart center to center. NOTE: CALL FOR INSPECTION OF TRENCH BEFORE PLACING STONE IN TRENCH. NOTE: ALL PIPE FROM HOUSE TO DISPOSAL AREA MUST BE CAST IRON. PERMIT VOID AFTER THREE YEARS. NOTE: INSTALL STAND PIPE ON SEPTIC TANK. STAND PIPES MUST BE 6 INCHES IN DIAMETER. CAST IRON, CONCRETE OR TERRA COTTA ACCEPTED.

PLANS APPROVED BY Robert T. Moorefield

DATE 2/19/76

FILL SEPTIC TANK AND DISTRIBUTION BOX WITH WATER BEFORE CALLING FOR AN INSPECTION. COVER NO WORK UNTIL INSPECTED AND APPROVED.


NEITHER THE HOWARD COUNTY COMMISSIONERS NOR THE HEALTH DEPARTMENT IS RESPONSIBLE FOR THE SUCCESSFUL OPERATION OF ANY SYSTEM.

Dave Ornel Here 4/29/77

THIS PERMIT SIGNED AND RETURNED

4/6/77
Serial # 52571-77A

19140

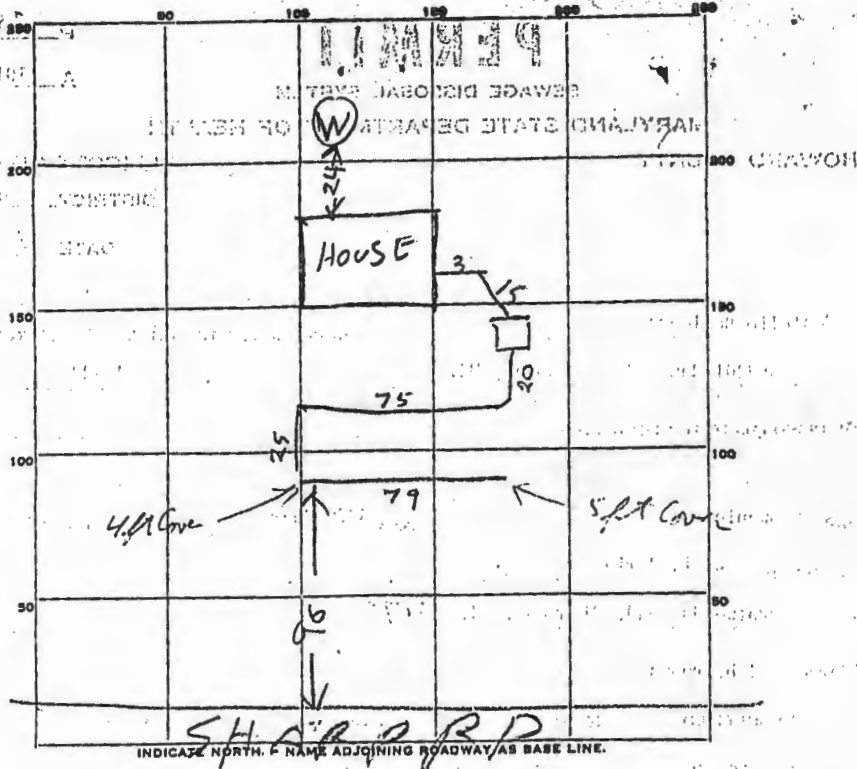

PERMIT CARD _____

SEPTIC TANK, LEVEL 1250 OK CLEANOUTS 01-

DISTRIBUTION BOX, LEVEL _____

PITCH _____ FT. TRENCH WIDTH 2 FT.

GRAVEL DEPTH 7 ft IN. TOTAL LENGTH 2 FT.

NUMBER OF TRENCHES 1 TOTAL BOTTOM AREA 1.54

SEEPAGE PITS, INSIDE DIAMETER _____ FT. DEPTH BELOW INLET _____ FT.

ABSORBENT AREA _____ SQ. FT.

REMARKS 5/3/77 No one could find sheet for
previous inspection so builder copy used R/H
D.O. cell was here 4/29/77 also R/H has on 5/3/77
-Stone added system OK

DATE SYSTEM APPROVED 5/3/77 INSPECTOR Thompson & Hodges