

APPLICATION

19140

SEWAGE DISPOSAL TESTING

P. _____

STATE OF MARYLAND - DEPARTMENT OF HEALTH AND MENTAL HYGIENE

HOWARD COUNTY HEALTH DEPARTMENT
ENVIRONMENTAL HEALTH SERVICES
P. O. BOX 476, ELLICOTT CITY, MARYLAND 21043
TELEPHONE: 468-8000, EXT. 386

DISTRICT Third & Fourth

DATE October 30, 1973

S.T.
302 1000 402 1330
The trench will begin 15' from the right property line and 12.5' from the road edge, as seen from the road. The trench will be 18' deep, 2' wide, contain 5' spacers and follow the contour of the land. There will be a minimum of 175' of sidewall/B.P. in the trench. No trench will exceed 75' in length, and all trenches will be connected in series with each running parallel to the last, and spaced 2' apart, center-to-center. 2 inspections R.M.

TO: THE COUNTY HEALTH OFFICER
ELLICOTT CITY, MARYLAND

I, HEREBY, APPLY FOR THE NECESSARY TEST IN ORDER TO CONSTRUCT (OR RECONSTRUCT) A SEWAGE DISPOSAL SYSTEM.

PROPERTY OWNER Mr. Weldon L. Boxing

ADDRESS Burntwoods Road, Glenwood, Maryland PHONE 442-2483

PROPERTY LOCATION:

SUBDIVISION Glenlea Estates - Section II LOT NO. 13, Block A

ROAD AND DESCRIPTION West side of Sharp Road

SIZE OF LOT 150' x 270' TYPE BLDG. 3 or 4
NUMBER OF BEDROOMS

IF NOT SINGLE RESIDENCE DESCRIBE _____

THE SYSTEM INSTALLED UNDER THIS APPLICATION IS ACCEPTABLE ONLY UNTIL PUBLIC FACILITIES BECOME AVAILABLE.

SIGNATURE OF APPLICANT William R. Gopher BLDG. PERMIT SIGNED AND RETURNED 3/3/77
Robert J. Moorefield 21242.21 No. 3101.5

APPROVED BY _____ FOR Trench (s) DATE FEB 76 2/19/76
(KIND OF SYSTEM)


REJECTED BY _____ FOR _____ DATE _____
(KIND OF SYSTEM)

HOLD PENDING FURTHER TESTS _____ DATE _____

REASONS FOR REJECTION OR HOLDING _____

THIS IS NOT A PERMIT

145

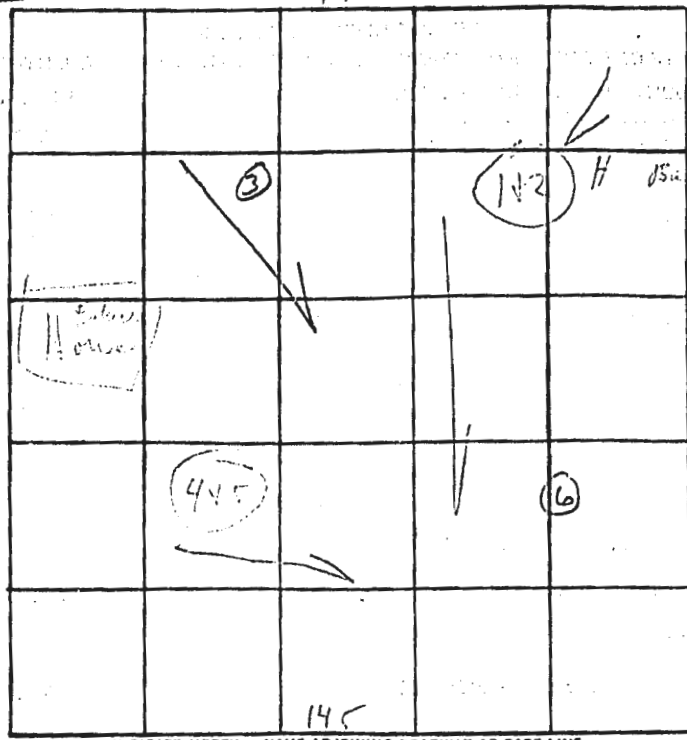

270

270'

L-13-A

E = 13
inlet = 5

INDICATE NORTH - NAME ADJOINING ROADWAY AS BASE LINE.

DATE	TEST NO.	DEPTH	PRE-WET		TEST - 1" DROP		TIME
			START	STOP	START	STOP	
	1	1' 5"	3:27	3:40	3:40	3:44	14
	2	1' 12"	3:29	3:24	3:34	3:46	12
	3	12 pl	Sample				
	4	5 1/4"	3:55	4:00	4:00	4:07	9
	5	1/2'	4:00	4:01	4:01	4:03	2
	6	12 pl	Sample				

REMARKS D.S. Vented Hole RS.

TYPE OF SOIL _____