

# APPLICATION

SEWAGE DISPOSAL TESTING

A 34897

STATE OF MARYLAND - DEPARTMENT OF HEALTH AND MENTAL HYGIENE

P \_\_\_\_\_

HOWARD COUNTY HEALTH DEPARTMENT  
ENVIRONMENTAL HEALTH SERVICES

DISTRICT 5

P. O. BOX 476 ELLICOTT CITY, MARYLAND 21043  
TELEPHONE: 992-2330

DATE 3-29-85

TO: THE COUNTY HEALTH OFFICER  
ELLICOTT CITY, MARYLAND

I, HEREBY, APPLY FOR THE NECESSARY TEST IN ORDER TO CONSTRUCT (OR RECONSTRUCT) A SEWAGE DISPOSAL SYSTEM.

PROPERTY ~~OWNER~~ DEVELOPER Prestwick Drive Joint Venture King

ADDRESS Box 196, Clarksville, Maryland 21029 PHONE 854-0498

PROPERTY LOCATION:

SUBDIVISION Ralph Greene Property / ~~Green Fields~~ Sec. 1 LOT NO. New LOT 12 ON  
6534 Final

ROAD AND DESCRIPTION End of Prestwick Drive

DDG PERMIT SIGNED  
AND RETURNED 10-21-89  
Serial # 1011 9389

SIZE OF LOT 3 acres TYPE BLDG. single family - 5 Bed  
(NUMBER OF BEDROOMS)

THE SYSTEM INSTALLED UNDER THIS APPLICATION IS ACCEPTABLE ONLY UNTIL PUBLIC FACILITIES BECOME AVAILABLE. I FULLY UNDERSTAND THE FEE CONNECTED WITH THE FILING OF THIS PERC TEST-APPLICATION IS NON-REFUNDABLE UNDER ANY CIRCUMSTANCES. I ALSO AGREE TO COMPLY WITH ALL M.O.S.H.A. REQUIREMENTS IN TESTING THIS LOT.

Ally Mangly  
SIGNATURE OF APPLICANT


APPROVED BY Sidney Abel FOR Shallow Tile fields DATE 2-14-85

REJECTED BY \_\_\_\_\_ FOR \_\_\_\_\_ DATE \_\_\_\_\_

HOLD PENDING FURTHER TESTS \_\_\_\_\_ DATE \_\_\_\_\_

REASONS FOR REJECTION OR HOLDING 4-9-85 Perc SATISFACTORY, Hold For Review WATER IN TWO HOLES,  
Hold For Certified Subdivision plat, hole location, house AND well size S Abel

# THIS IS NOT A PERMIT

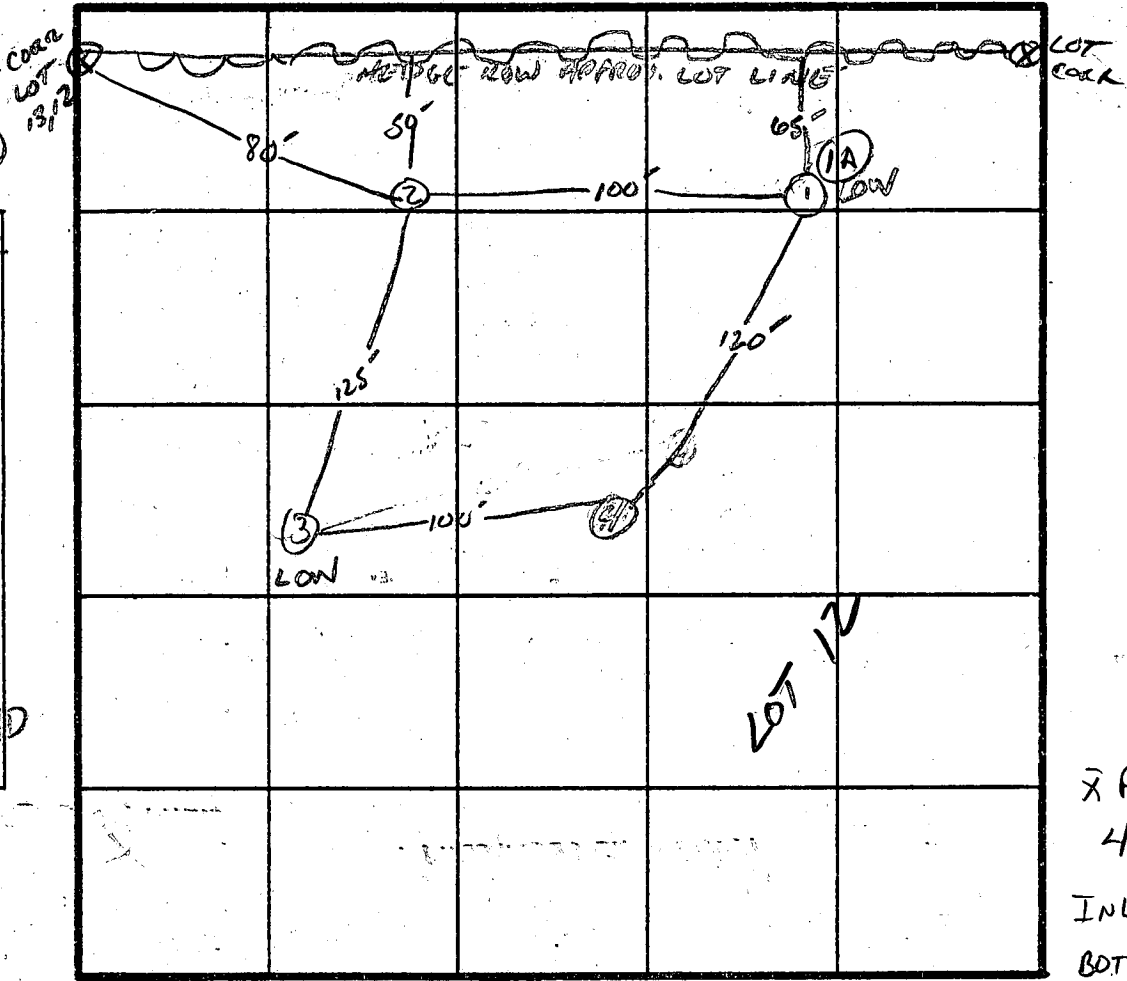

X Perc. Time  
 4min  
 INLET 2.0'  
 BOTTOM MAX 3.5'

158 P/BR

CLW

INDICATE NORTH - NAME ADJOINING ROADWAY AS BASE LINE.

River Clyde DR.

DATE	TEST NO.	DEPTH	PRE-WET		TEST - 1" DROP		TIME	
			START	STOP	START	STOP		
4/9/85	15	4"	2:56	2:52:30	2:52:30	2:56	3.5min	
	1V	12"	UNIFORM SOIL STRUCTURE Below 3.5" WATER AT 10.5"					
	25	5"	3:00	3:01	3:01	3:02:30	1.5min	
	2V	12"	UNIFORM SOIL STRUCTURE Below 3.5"					
	35	5"	3:11	3:14	3:14	3:18	4min	
	3V	12"	UNIFORM SOIL STRUCTURE Below 3" WATER AT 10.5"					
	45	4"	3:27	3:29	3:29	3:34	5min	
	4V	12"	UNIFORM SOIL STRUCTURE Below 3.5"					
7/29	1A	NEW SHELF DUG 3"	NOT TESTED - VISIBLY OK					

REMARKS

SYSTEM FIRST, Shallow Syst. only BOTTOM MAX 3.5'

TYPE OF SOIL

TESTED BY

8/Abel

Phil Mangitz, Richard Demist  
ALSO PRESENT C. G. S. S. S.

EH-12-1079

SOIL PROFILE

0" AP  
 9" BROWN CLAY LOAM 10% SAPROLITE  
 35" BROWN SILTY SAND 10% SAPROLITE  
 11" hole

0" AP  
 9" BROWN CLAY LOAM 10% SAPROLITE  
 35" BROWN SILTY SAND 10% SAPROLITE