

APPLICATION

A 17169

P _____

SEWAGE DISPOSAL TESTING

MARYLAND STATE DEPARTMENT OF HEALTH

HOWARD COUNTY

ELLICOTT CITY

DISTRICT 2

DATE 6/23/72

TO: THE COUNTY HEALTH OFFICER
ELLICOTT CITY, MARYLAND

I, HEREBY, APPLY FOR THE NECESSARY TESTS IN ORDER TO CONSTRUCT (OR RECONSTRUCT) A SEWAGE DISPOSAL SYSTEM.

PROPERTY OWNER Walter Shank & wf.

ADDRESS 13194 Sky Way, Ellicott City, Maryland PHONE 531-5631

PROPERTY LOCATION:

SUBDIVISION _____ LOT NO. _____

ROAD AND DESCRIPTION Sky Way off Walt-Ann Drive

OCCUPANT _____ PHONE _____

PERSON TO CONSTRUCT SYSTEM _____

ADDRESS _____ PHONE _____

SIZE OF LOT 20.57 acres TYPE BLDG. THERE IS NO DIVISION OF LAND INVOLVED

IF NOT SINGLE RESIDENCE DESCRIBE _____

**THIS HOUSE IS FOR RENTAL PURPOSES - 2 houses
already on property**

SIGNATURE OF APPLICANT /s/ Walter J. Shank

APPROVED BY _____ FOR _____ DATE _____

(KIND OF SYSTEM)


REJECTED BY _____ FOR _____ DATE _____

(KIND OF SYSTEM)

HOLD PENDING FURTHER TESTS _____ DATE _____

REASONS FOR REJECTION OR HOLDING _____

THIS IS NOT A PERMIT

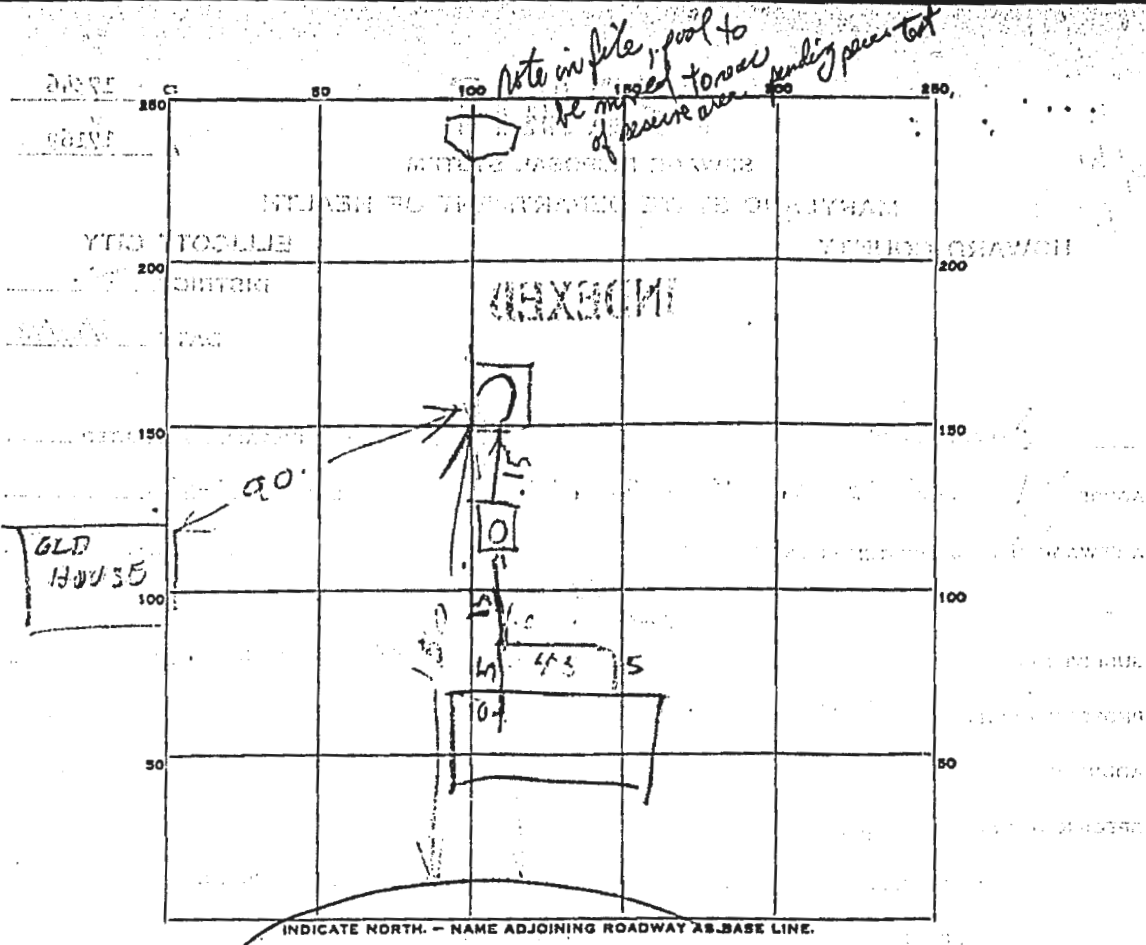

PERMIT CARD _____

SEPTIC TANK, LEVEL _____ CLEANOUTS _____

DISTRIBUTION BOX, LEVEL _____

TILE FIELD, DEPTH _____ FT. TRENCH WIDTH _____ FT.

GRAVEL DEPTH _____ IN. TOTAL LENGTH _____ FT.

NUMBER OF TRENCHES _____ TOTAL BOTTOM AREA _____

SEEPAGE PITS, INSIDE DIAMETER 12 FT. DEPTH BELOW INLET 10 FT.

ABSORBENT AREA 650 SQ. FT. *60 manure absorbers*

REMARKS 3/5/77: Found all 1 inch 4F to be unusable
Remainder of this Well is 65 FT

Well not yet installed

DATE SYSTEM APPROVED 3/5/77 INSPECTOR Raymond W. Hodge