

# APPLICATION

SEWAGE DISPOSAL TESTING

A. 05-778

R. 06053  
11-8-62

MARYLAND STATE DEPARTMENT OF HEALTH

HOWARD COUNTY 750 Gallon Tank

ELLICOTT CITY

Dry Well - 300 sq ft sidewalk area below the inlet. DISTRICT 5  
DATE 9/14/62

Please the dry well 55 ft to 75 ft behind the house  
The house is to be placed about 160 ft from the  
front lot line and about 30 ft from the side  
of the lot which is closest to Route 108

TO: THE COUNTY HEALTH OFFICER  
ELLICOTT CITY, MARYLAND

Permit denied  
no notes hereon

I, HEREBY, APPLY FOR THE NECESSARY TESTS IN ORDER TO CONSTRUCT (OR RECONSTRUCT) A SEWAGE DISPOSAL SYSTEM.

PROPERTY OWNER Charles Langerfelder  
ADDRESS 6200 Hamilton Ave Balt 6. PHONE \_\_\_\_\_

PROPERTY LOCATION:

SUBDIVISION \_\_\_\_\_ LOT NO. \_\_\_\_\_

ROAD AND DESCRIPTION Sheppard Lane - 1/2 mile from Rt 108  
across from farm with white fence around it

OCCUPANT \_\_\_\_\_ PHONE \_\_\_\_\_

PERSON TO CONSTRUCT SYSTEM \_\_\_\_\_

ADDRESS \_\_\_\_\_ PHONE \_\_\_\_\_

SIZE OF LOT 3 acres TYPE BLDG. 3 NUMBER OF BEDROOMS \_\_\_\_\_

IF NOT SINGLE RESIDENCE DESCRIBE \_\_\_\_\_

SIGNATURE OF APPLICANT James H. Franklin


APPROVED BY Raymond Hodger FOR Dry Well DATE 14 Sept 62

REJECTED BY \_\_\_\_\_ FOR \_\_\_\_\_ DATE \_\_\_\_\_

HOLD PENDING FURTHER TESTS \_\_\_\_\_ DATE \_\_\_\_\_

REASONS FOR REJECTION OR HOLDING \_\_\_\_\_

## THIS IS NOT A PERMIT

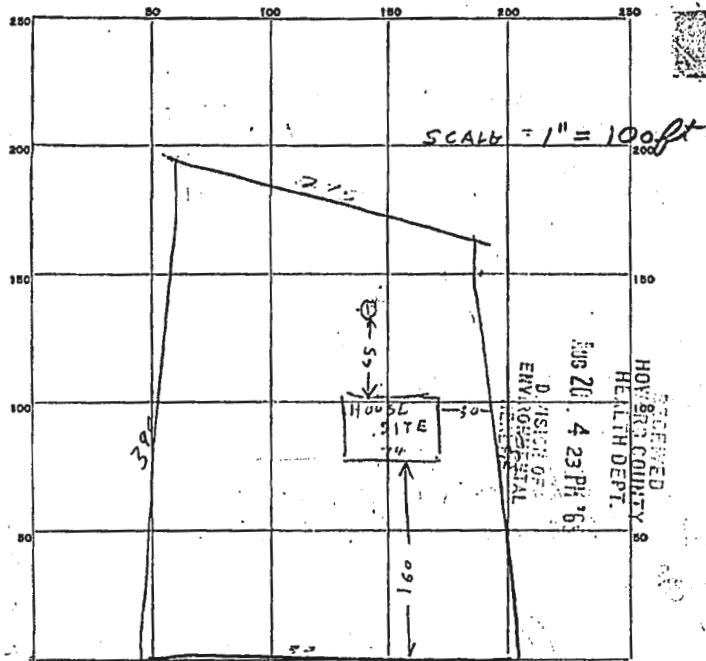

INDICATE NORTH. - NAME ADJOINING ROADWAY AS BASE LINE.

SHEPHERD LANE

TO Route 108 →

DATE	TEST NO.	DEPTH	PRE-WET		TEST - 1" DROP		TIME
			START	STOP	START	STOP	
12/4/62	1	9	113	114	114	117	3 min

SOIL AUGER FINDING Rock & Sand Entire Depth

TESTED BY Raymond Hodges

REMARKS \_\_\_\_\_

ALSO PRESENT James H. Louder LOT NO. \_\_\_\_\_