


MID2

ChB2

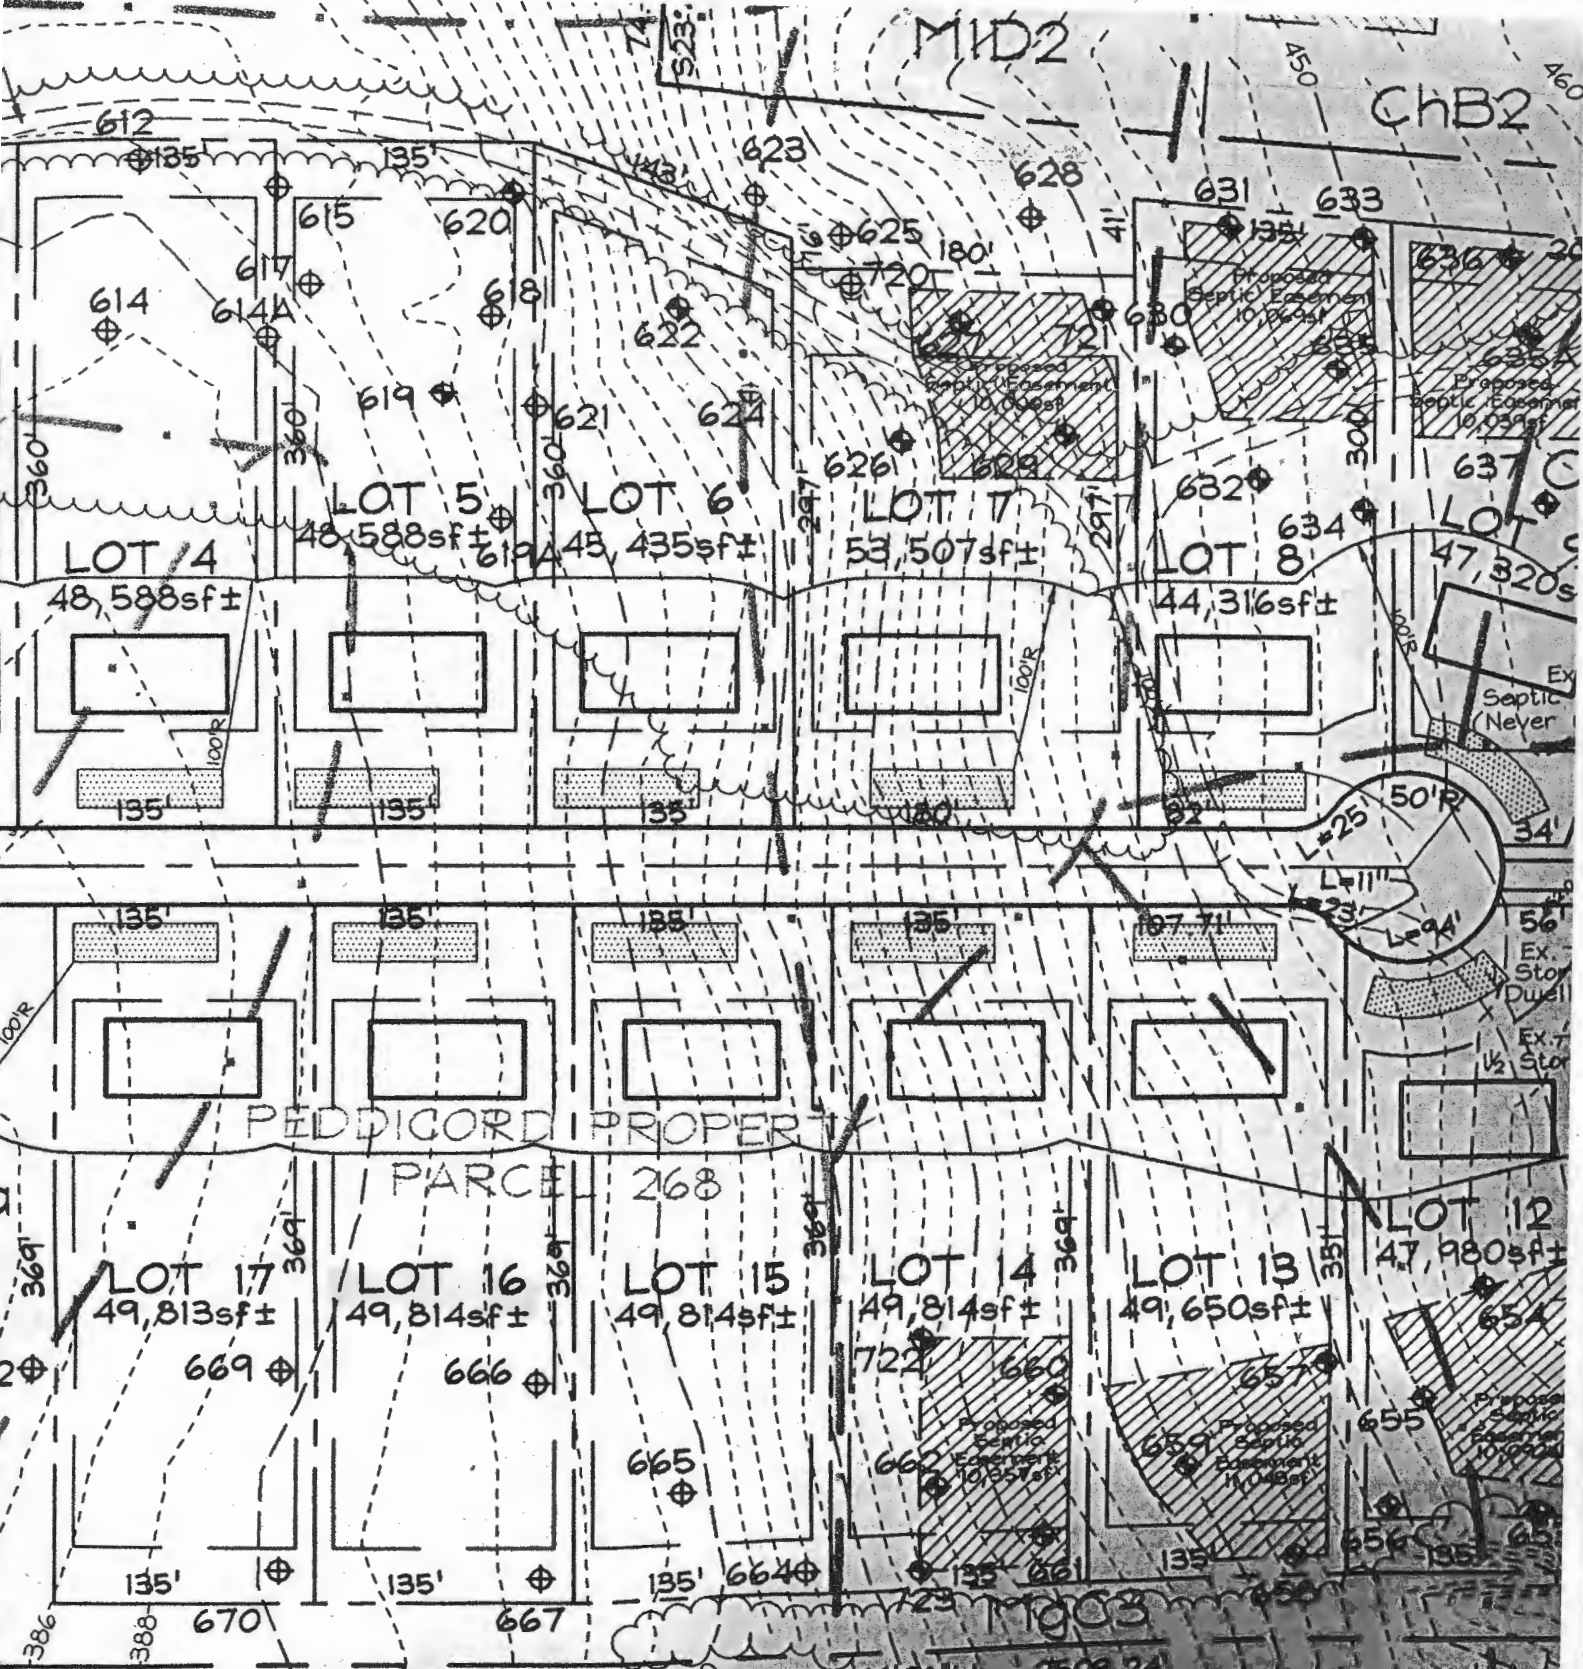

PEDDICORD PROPERTY

PARCEL 268

Approval per <sup>3</sup>CgB2  
 WILLIAM AND DEBRA  
 2/4/04 DAVIS  
 See PARCEL 51 LOT 4  
 FOX RUN ESTATES  
 APPRAT #8359  
 ZONED R-2

HUGH AND RUTH  
 GREGORY Ex. Well  
 PARCEL 51 LOT 4  
 FOX RUN ESTATES  
 PLAT #8360  
 ZONED RC-DEC