

4/3/86
1:30 P.M.

APPLICATION

PERCOLATION TESTING

A 30649
P _____

HOWARD COUNTY HEALTH DEPARTMENT
BUREAU OF ENVIRONMENTAL HEALTH
P.O. BOX 476 ELLICOTT CITY, MARYLAND 21043
TELEPHONE: 461-9933

DISTRICT _____
DATE 3/12/86

TO: THE COUNTY HEALTH OFFICER
ELLICOTT CITY, MARYLAND

I, HEREBY, APPLY FOR THE NECESSARY TEST IN ORDER TO CONSTRUCT (OR RECONSTRUCT) A SEWAGE DISPOSAL SYSTEM.

PROPERTY OWNER _____
ADDRESS _____ PHONE _____

PROSPECTIVE BUYER FERNANDO NESTORIO
ADDRESS 1301 RITCHIE ROAD PHONE (301) 350-0063
CAPITOL HEIGHTS MD 20743

PROPERTY LOCATION:
SUBDIVISION WARFIELD ESTATES LOT NO. OLD LOT #4
NEW LOT #38
ROAD AND DESCRIPTION STAPLETON DR.

TAX MAP _____ PARCEL # _____
SIZE OF LOT _____ TYPE BLDG. _____
(SINGLE FAMILY DWELLING OR COMMERCIAL)

THE SYSTEM INSTALLED UNDER THIS APPLICATION IS ACCEPTABLE ONLY UNTIL PUBLIC FACILITIES BECOME AVAILABLE. I FULLY UNDERSTAND THE FEE CONNECTED WITH THE FILING OF THIS PERC TEST APPLICATION IS NON-REFUNDABLE UNDER ANY CIRCUMSTANCES. I ALSO AGREE TO COMPLY WITH ALL M.O.S.H.A. REQUIREMENTS IN TESTING THIS LOT. [Signature]
(SIGNATURE OF APPLICANT)

APPROVED BY _____ FOR _____ DATE _____



REJECTED BY _____ FOR _____ DATE _____

HOLD PENDING FURTHER TESTS _____ DATE _____

REASONS FOR REJECTION OR HOLDING THIS ATTEMPT FAILED, PREVIOUS PERC AREA OK
But Records not located at this time, Sewerage System not.
4/10/86 C. Wells


THIS IS NOT A PERMIT

#1 SOIL PROFILE

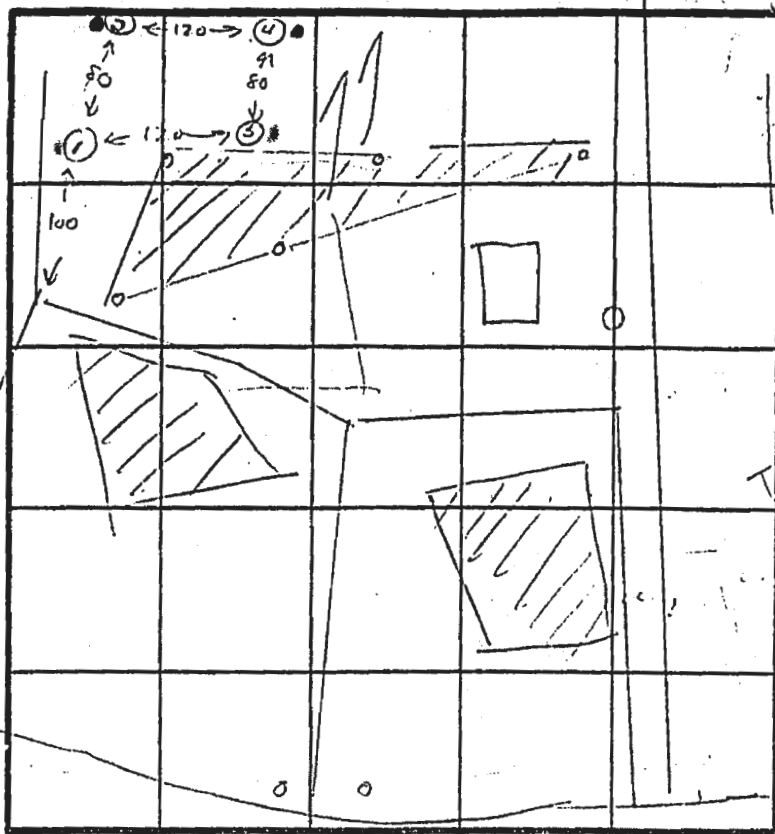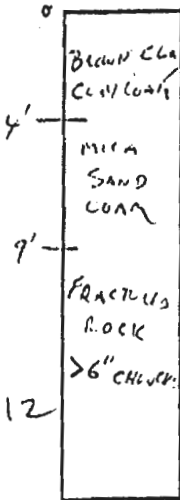


INDICATE NORTH - NAME ADJOINING ROADWAY AS BASE LINE.

#3

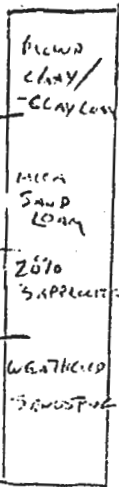

DATE	TEST NO.	DEPTH	PRE-WET		TEST - 1' DROP		TIME	
			START	STOP	START	STOP		
4/4/86	1	4 9 12	8:10	8:12	8:12	8:15	3 MIN	
			FRACTURED ROCK - 6' BELOW SURFACE AT 9'					
			ROCK					
4/4/86	2	5 10	CLAY TO 5'					
			MOTTLED CLAY MICA LOAM 5'-10'					X
4/4/86	3	6 10 12	CLAY TO 6'					
			MICA LOAM					
			WEATHERED SANDSTONE AT 12'					
X	4	-	NOT FINISHED - BACKFILL BY CONTRACTOR.					
		12'	CONTRACTOR STARTS WATER AT 12'					
			WHEN EXCAVATED 1 MONTH PREVIOUS.					

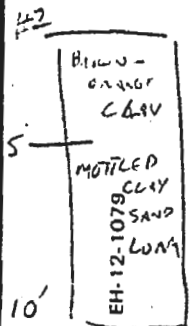

REMARKS: NOT POSSIBLE TO MOVE PEEC AREA ANY LOWER ON THIS LOT;
SOME ADJUSTMENT SHOULD BE CONSIDERED TO IMPROVE
TYPE OF SOIL: HOUSE AND WELL SITE. WELL IS PERMANENT BUT NEEDED BY SEPTICS,
TESTED BY: C. W. Quinn ALSO PRESENT: NESTORIN

CLAY/
WATER ROCK
↑

