

C11 2358
 SEQUENCE NO. (OEP USE ONLY)
 (THIS NUMBER IS TO BE PUNCHED IN COLS. 3-6 ON ALL CARDS)

STATE OF OHIO
 WELL COMPLETION REPORT
 FILL IN THIS FORM COMPLETELY
 PLEASE PRINT OR TYPE

THIS REPORT MUST BE SUBMITTED WITHIN 45 DAYS AFTER WELL IS COMPLETED.
 COUNTY NUMBER **A33793**

DATE Received
 DATE WELL COMPLETED **080885**
 Depth of Well **325** (TO NEAREST FOOT)
 PERMIT NO. FROM "PERMIT TO DRILL WELL" **H0-81-1098**

OWNER **SINES, WILLIAM**
 STREET OR RFD **TRINIDAD MILLS RD** first name TOWN **DAYTON**
 SUBDIVISION **FOXHALL VILLAS** SECTION **1** LOT **3**

WELL LOG
 Not required for driven wells

STATE THE KIND OF FORMATIONS PENETRATED, THEIR COLOR, DEPTH, THICKNESS AND IF WATER BEARING

DESCRIPTION (Use additional sheets if needed)	FEET		Check if water bearing
	FROM	TO	
Brown shale	0	37	
Gray mica rock	37	325	

DRY WELLS 1-325'
 2-265'

Filled in with cement + DRILLING MATERIALS

GROUTING RECORD

WELL HAS BEEN GROUTED (Circle appropriate box) **Y** **N**

TYPE OF GROUTING MATERIAL
 CEMENT **CM** BENTONITE CLAY **BC**

NO. OF BAGS **9** NO. OF POUNDS **846**

GALLONS OF WATER **37**

DEPTH OF GROUT SEAL (to nearest foot)
 from ft. to **32** ft.
 (enter 0 if from surface)

CASING RECORD

casing types insert appropriate code below

ST **CO**
 STEEL CONCRETE
PL **OT**
 PLASTIC OTHER

MAIN CASING TYPE **ST** **6** **40**
 Nominal diameter top (main) casing (nearest inch) Total depth of main casing (nearest foot)

OTHER CASING (if used)
 diameter inch depth (feet) from to

SCREEN RECORD

screen type or open hole insert appropriate code below

ST **BR** **HO**
 STEEL BRASS OPEN HOLE
PL **OT**
 PLASTIC OTHER

C2

DEPTH (nearest ft.)

1	2	3	4	5	6	7	8	9	10	11	12	13	14	15	16	17	18	19	20

EACH SCREEN

SLOT SIZE 1 2 3

DIAMETER OF SCREEN (NEAREST INCH)

GRAVEL PACK IF WELL DRILLED WAS FLOWING WELL INSERT F IN BOX 68

OEP USE ONLY (NOT TO BE FILLED IN BY DRILLER)

T (E.R.O.S.)

WQ

TELESCOPE CASING LOG INDICATOR OTHER DATA

C3

PUMPING TEST

HOURS PUMPED (nearest hour) **6**

PUMPING RATE (gal. per min. to nearest gal.) **2**

METHOD USED TO MEASURE PUMPING RATE **bucket**

WATER LEVEL (distance from land surface) BEFORE PUMPING **41**

WHEN PUMPING **204**

TYPE OF PUMP USED (for test)
A air **P** piston **T** turbine
C centrifugal **R** rotary **O** other (describe below)
J jet **S** submersible

PUMP INSTALLED

DRILLER WILL INSTALL PUMP YES NO

IF DRILLER INSTALLS PUMP, THIS SECTION MUST BE COMPLETED FOR ALL WELLS EXCEPT HOME USE


TYPE OF PUMP INSTALLED PLACE (A,C,J,P,R,S,T,O) IN BOX - SEE ABOVE:

CAPACITY: GALLONS PER MINUTE (to nearest gallon)

PUMP HORSE POWER

PUMP COLUMN LENGTH (nearest ft.)

CASING HEIGHT (circle appropriate box and enter casing height)
 above } LAND SURFACE (nearest foot)
 below }

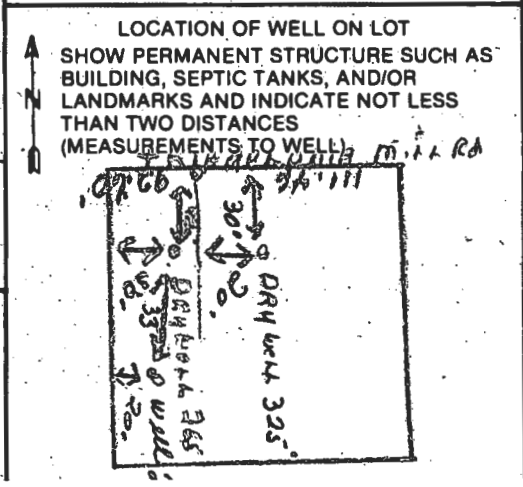

CIRCLE APPROPRIATE LETTER A WELL WAS ABANDONED AND SEALED WHEN THIS WELL WAS COMPLETED

E. ELECTRIC LOG OBTAINED

P. TEST WELL CONVERTED TO PRODUCTION WELL

I HEREBY CERTIFY THAT THIS WELL HAS BEEN CONSTRUCTED IN ACCORDANCE WITH COMAR 10:17.13 "WELL CONSTRUCTION" AND IN CONFORMANCE WITH ALL CONDITIONS STATED IN THE ABOVE CAPTIONED PERMIT, AND THAT THE INFORMATION PRESENTED HEREIN IS ACCURATE AND COMPLETE TO THE BEST OF MY KNOWLEDGE.

DRILLERS IDENT. NO. **238**

Joseph P. Mays

DRILLERS SIGNATURE (MUST MATCH SIGNATURE ON APPLICATION)

SITE SUPERVISOR (sign. of driller or journeyman responsible for sitework if different from permittee)

SITE INSPECTION SHEET

OWNER: _____ PHONE #: _____


ADDRESS: 13331 Triadelphia Mill Rd. CONTRACTOR: Easturday

WELL TAG #: _____

SUBDIVISION: _____ LOT: _____ COUNTY #: _____

PROPOSAL: Well only has 0.18 gpm - drill a new well. House has 11 people currently and will house 15 people soon.

LOCATION DIAGRAM

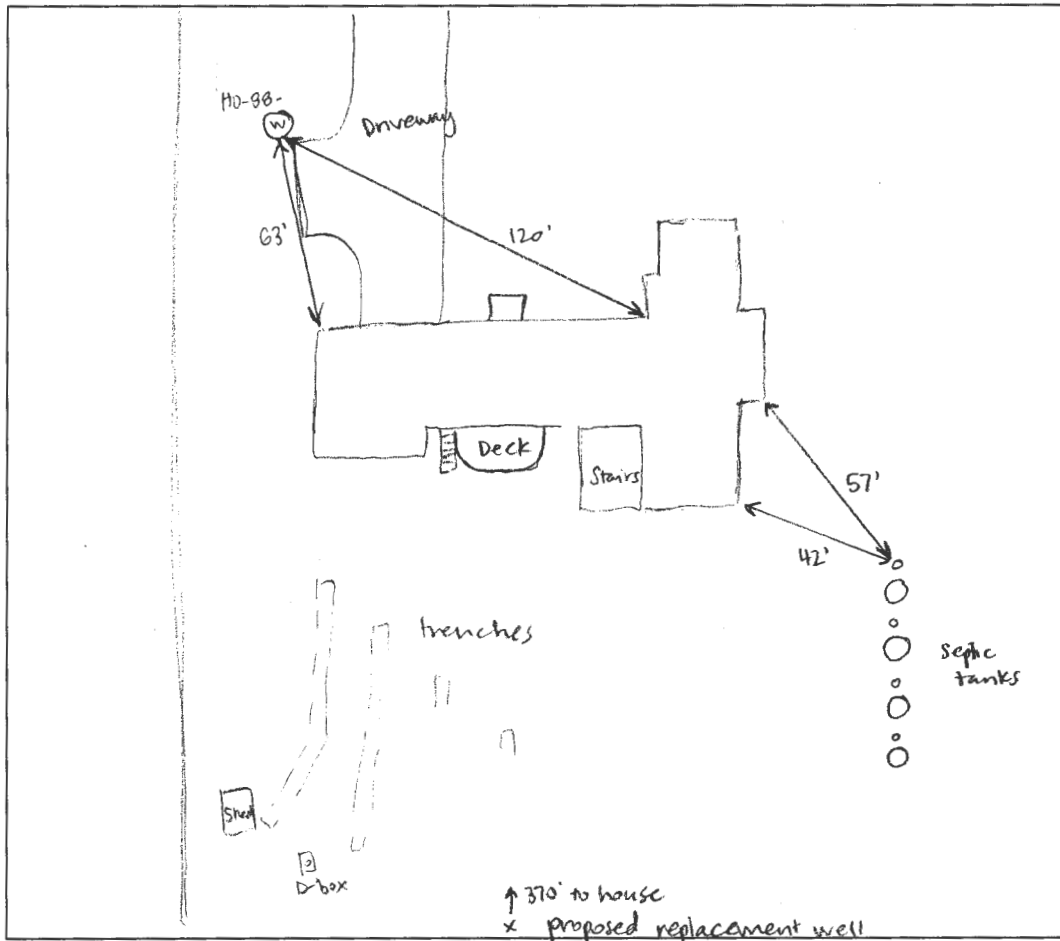


COMMENTS: Met George Easterday + son of homeowner on site. George does not want to drill in the front yard b/c of previous dry holes on lot and dry holes + contamination issues at new subdivision across the street. Well line will have to run between trenches and property line + will need to be sleeved 15' before D-box to within 50' of house.

DATE: 10/17/13 INSPECTOR: Sarah Collins

1" = 50'


TRIADELPHIA MILL RC

- PERC-PASS 1984
- PERC-PASS 2011

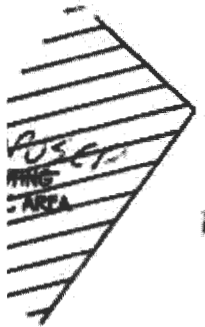

PROSC
W TANK
LOCATION

EXISTING
ENCHES

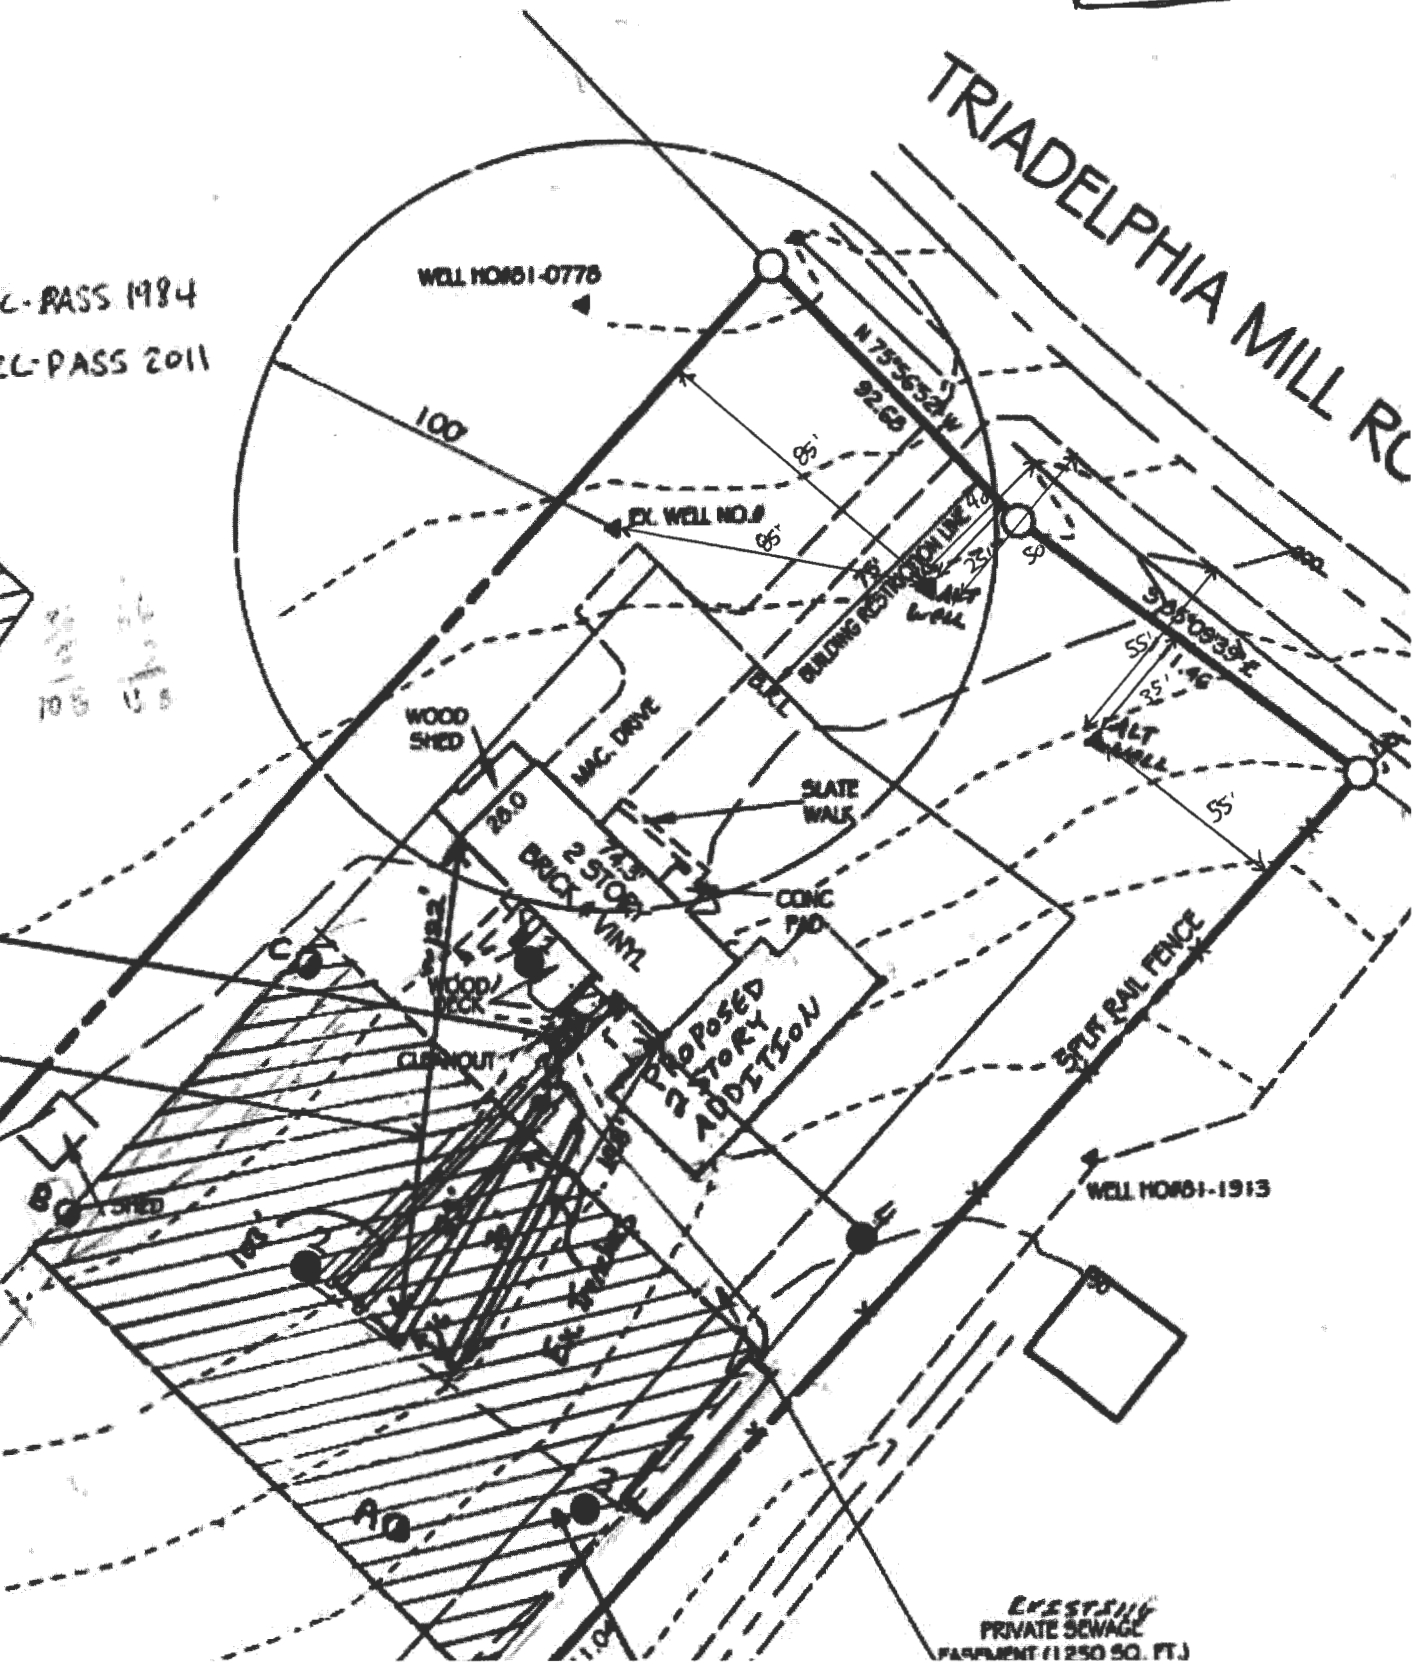

EXISTING
PRIVATE SEWAGE
PARAPET (1250 SQ. FT.)