

Handwritten notes:
4/10/78
French cess - to p...
2/24/78
2/27/78 - final

Handwritten note:
2/27/78

Handwritten notes:
4/10/78 P.C.O.
C.H.D.
27423

PERMIT

SEWAGE DISPOSAL SYSTEM

MARYLAND STATE DEPARTMENT OF HEALTH

A 21235

HOWARD COUNTY

INDEXED

ELLICOTT CITY

DISTRICT 5th

INDEXED

DATE 1/10/78

Jim Brittingham

IS PERMITTED TO INSTALL ALTER

ADDRESS _____

SUBDIVISION H. Heritage

ROAD Sharp Road

LOT 12 Sec 1

PROPERTY OWNER _____

ADDRESS _____

SPECIFICATIONS

~~4~~ 4 bedrooms

SEPTIC TANK CAPACITY 1350 GALLONS

DRAIN FIELD _____ DEPTH _____ FEET. BOTTOM AREA _____ SQ. FT.

DEEP TRENCH _____ DEPTH _____ FEET. BOTTOM AREA _____ SQ. FT.

SEEPAGE PITS _____ ABSORBENT SIDE WALL AREA 145 SQ. FT. per bedroom

INLET PIPE 4 FT. BELOW ORIGINAL GRADE. MAXIMUM DEPTH 10 FT. BELOW ORIGINAL GRADE

EFFECTIVE DEPTH AT _____ FT. BELOW ORIGINAL GRADE

LOCATE DISPOSAL AREA 20 FT. FROM front LOT LINE AND 105 FT. FROM left LOT LINE AS SEEN WHEN FACING LOT FROM the road.

PLANS APPROVED BY R. T. Moorefield

DATE 2/19/77

COVER NO WORK UNTIL INSPECTED AND APPROVED

NEITHER THE HOWARD COUNTY COUNCIL NOR THE HEALTH DEPARTMENT IS RESPONSIBLE FOR THE SUCCESSFUL OPERATION OF ANY SYSTEM

NOTE IF TRENCH IS USED CALL FOR INSPECTION BEFORE PLACING GRAVEL IN TRENCH

NOTE NO DRY WELL SHALL EXCEED 15 FOOT IN DIAMETER


NOTE ALL PIPE FROM HOUSE TO DISPOSAL AREA MUST BE CAST IRON

PERMIT VOID AFTER THREE YEARS

NOTE INSTALL STAND PIPE ON SEPTIC TANK AND DRY WELL. STAND PIPES MUST BE 6 INCHES IN DIAMETER. CAST IRON, CONCRETE OR TERRA COTTA ACCEPTED

INSTALLER IS RESPONSIBLE FOR OBTAINING FINAL APPROVAL ON THIS PERMIT.

Handwritten note:
A 21235

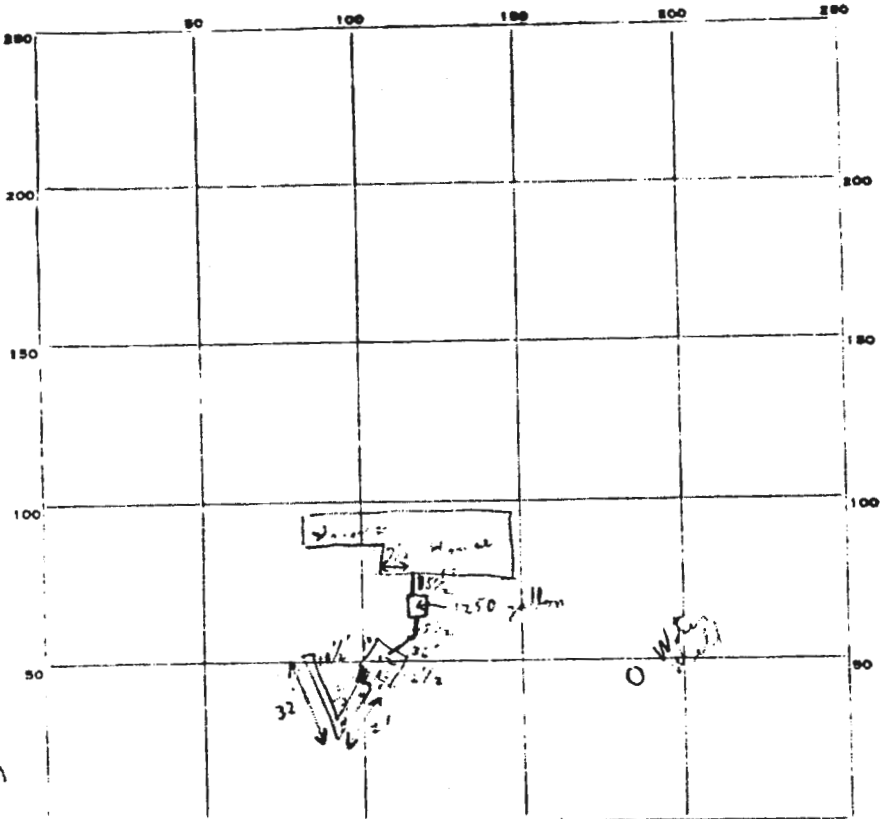

INDICATE NORTH - NAME ADJOINING ROADWAY AS BASE LINE

PERMIT CARD No. 1000 (3/10) Shady Rd S.T. P.W.
 SEPTIC TANK, LEVEL ok (new) CLEANOUTS 7/24/78 No
 DISTRIBUTION BOX, LEVEL N/S 7/27/78 Yes

TRENCH FIELD, DEPTH 10 FT. TRENCH WIDTH — FT.
 GRAVEL DEPTH 7 IN. TOTAL LENGTH 43 FT. 0 37 1 2
 NUMBER OF TRENCHES 1 TOTAL BOTTOM AREA —
 SEEPAGE PITS, INSIDE DIAMETER 48 FT. DEPTH BELOW INLET 6.5 FT. (291)
 ABSORBENT AREA 662 SQ. FT.

REMARKS 7/10/78 No trench at present of 1/2 inch hole in house
septic tank 3 2/24/78 checked - 'Depth of Pit 10 1/2'
no more pipe in trench - 1/2 inch hole in trench. 1/2 inch
bullet hole in trench 2/25/78 paper in trench 1/2 inch
at 1/2 inch in trench
C.R.

DATE SYSTEM APPROVED 2/27/78 INSPECTOR C.R. 2/27/78

