


Percolation Certification Plan for 1450 Shaffersville Road  
(PC #49876)

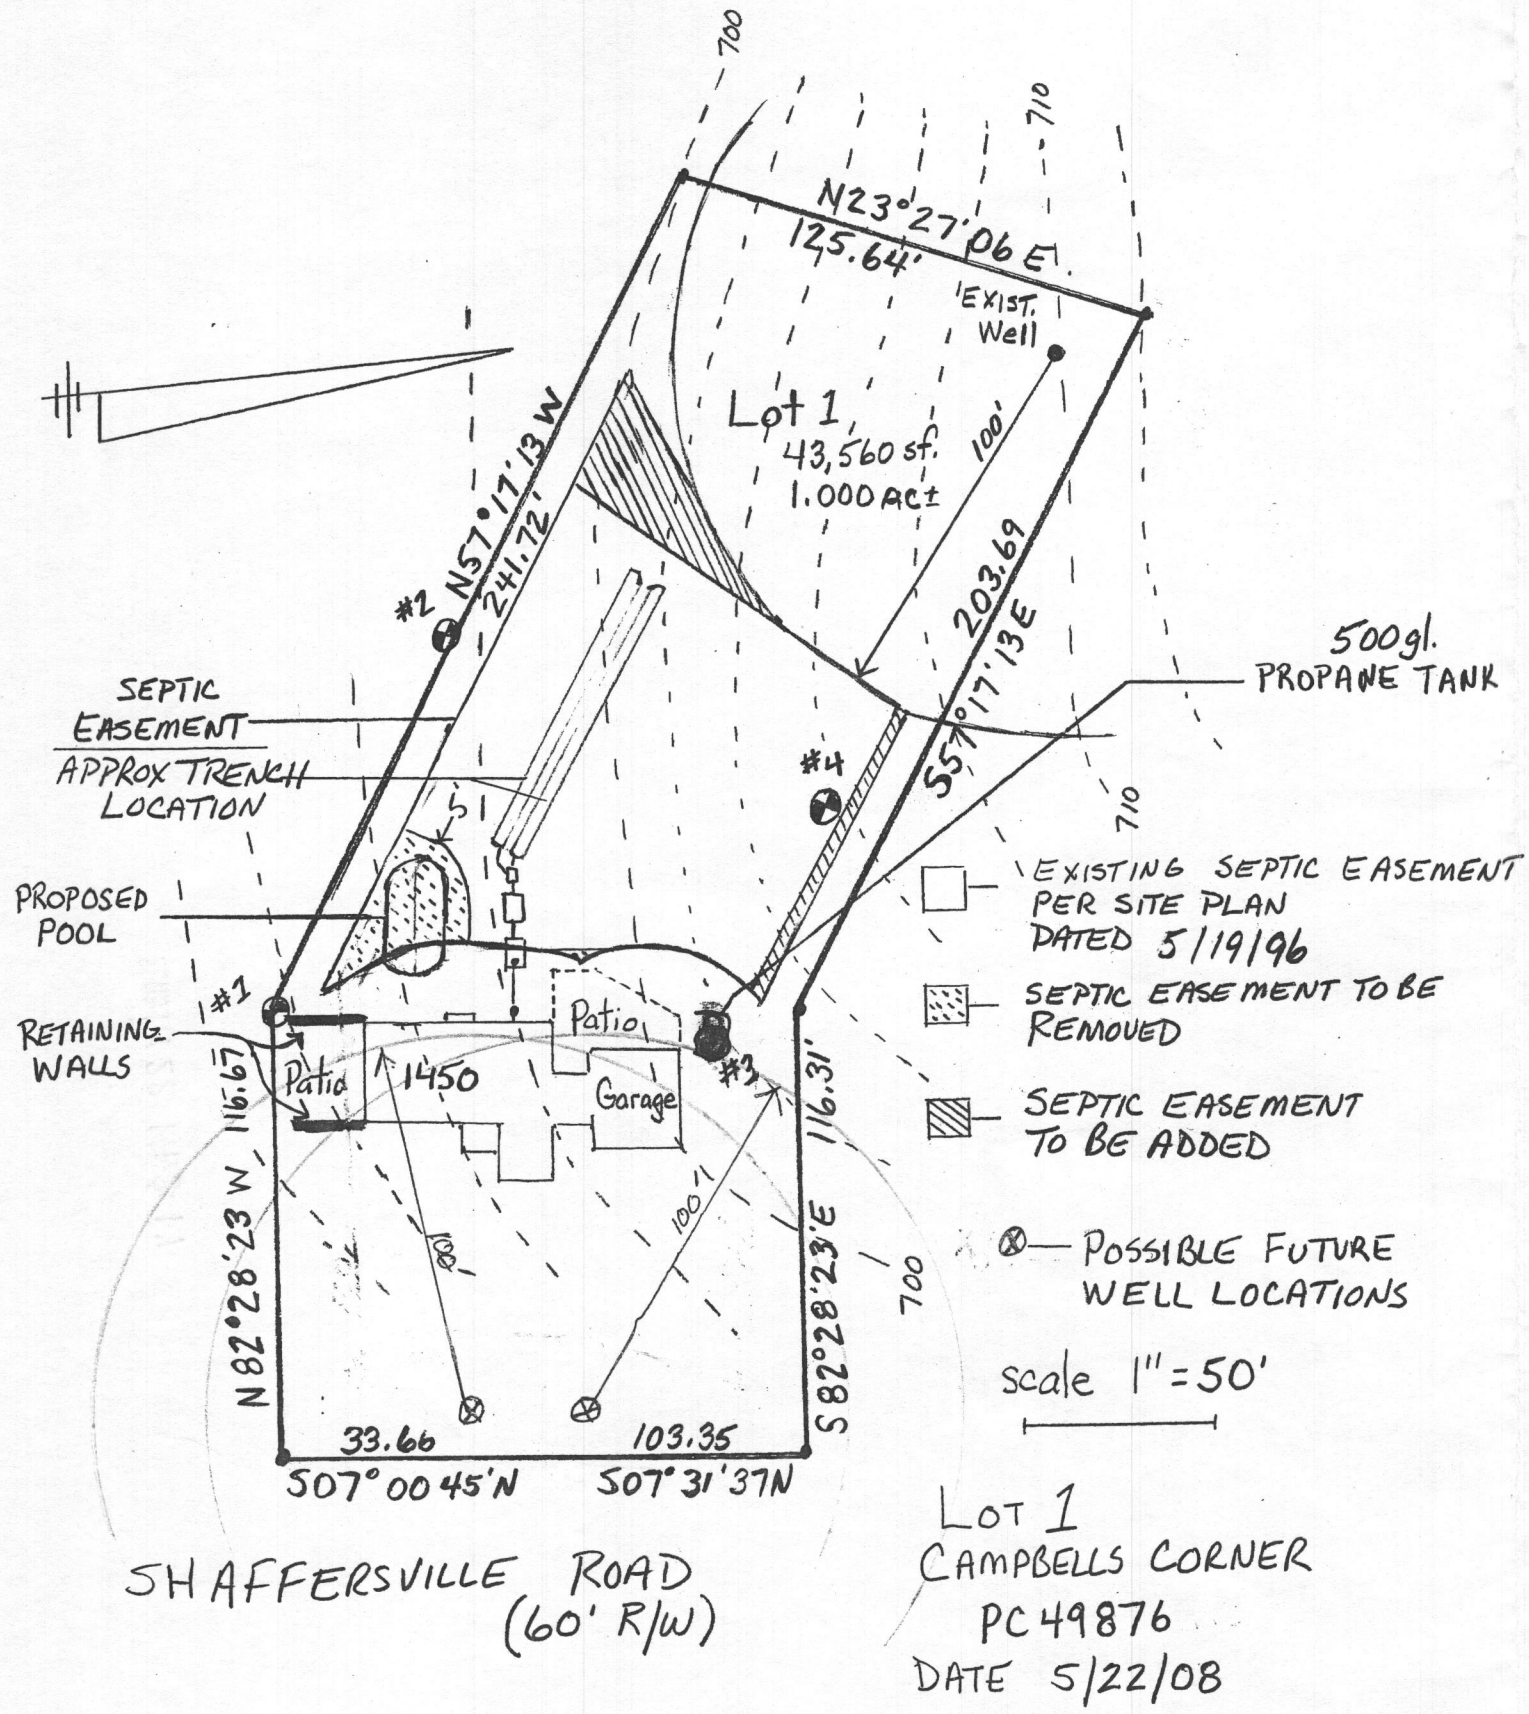

NOTES:

1. All existing wells on the subject property and within 100 feet of subject property boundaries are represented to the best of my knowledge and belief.
2. Topography on this plat is from Howard County gis and is verified to accurately represent the relative elevation changes on and near the subject property.
3. Any changes to a private sewage easement shall require a revised percolation certification plan.
4. These areas designate a private sewage easement of at least 10,000 sq. ft. as required by the Maryland Department of Environment for individual sewage disposal. Improvements of any nature in this easement are restricted. This easement shall become null and void upon connection to a public sewerage system. The County Health Officer shall have authority to grant adjustments to the private sewage easement. Recordation of a revised sewage easement shall not be necessary.
5. All of these shall remain: the existing residence, garage, patio, lp tank, well, and septic system.
6. The purpose for this Percolation Certification Plan is to adjust the boundaries of the existing septic easement in support of a building permit application for an aboveground pool.

I certify that the information shown hereon is based on work performed in my presence or by my direction, and is correct to the best of my knowledge and belief.

Steve Lybell 5/22/08  
(Signature) (Date)

Approved for private water and private sewerage systems.

B. Neff for Peter Beilensen, MD 6/4/2008  
(Signature) (Date)  
MBB MJO