

(OEP USE ONLY)

WELL COMPLETION REPORT
FILL IN THIS FORM COMPLETELY
PLEASE PRINT OR TYPE

45 DAYS AFTER WELL IS COMPLETED.

(THIS NUMBER IS TO BE PUNCHED
IN COLS. 3-6 ON ALL CARDS)

COUNTY
NUMBER

A22314

Date Received
(OEP use only)

DATE WELL COMPLETED

10/21/82

Depth of Well

160

(TO NEAREST FOOT)

PERMIT NO.
FROM PERMIT TO DRILL WELL

40-73-4292

OWNER, Evans
last name

Maurice T.
first name

STREET OR RFD
Shore Road

TOWN
Glenely

SUBDIVISION
Gwenlee Estates

SECTION
3, area 2

LOT
2

WELL LOG

Not required for driven wells

STATE THE KIND OF FORMATIONS
PENETRATED, THEIR COLOR, DEPTH,
THICKNESS AND IF WATER BEARING

DESCRIPTION (Use
additional sheets if needed)

FEET
FROM TO

Check
if water
bearing

Top Soil	0	2	
Sandy	2	10	
Sand Stone	10	20	
Micka	20	55	
Sand Stone	55	60	
Micka	60	160	

GROUTING RECORD

WELL HAS BEEN GROUTED
(Circle Appropriate Box)

YES NO

TYPE OF GROUTING MATERIAL:

CEMENT BENTONITE CLAY

NO. OF BAGS 5 NO. OF POUNDS 500

GALLONS OF WATER 30

DEPTH OF GROUT SEAL (to nearest foot)

from 0 TOP (enter 0 if from surface) to 21 BOTTOM 51"

CASING RECORD

casing types
insert
appropriate
code
below

STEEL CONCRETE
PLASTIC OTHER

MAIN CASING TYPE
Nominal diameter top(main)casing (nearest inch) 6
Total depth of main casing (nearest foot) 33

OTHER CASING (if used)
diameter inch depth (feet) from to

EACH CASING

SCREEN RECORD

screen type or openhole
insert appropriate code below

STEEL BRASS OPEN HOLE
BRONZE PLASTIC OTHER

DEPTH (nearest ft.)

HO 28 160

SLOT SIZE

DIAMETER OF SCREEN (NEAREST INCH)

GRAVEL PACK

IF WELL DRILLED WAS FLOWING WELL CIRCLE BOX

OEP USE ONLY (NOT TO BE FILLED IN BY DRILLER)

TELESCOPE CASING LOG INDICATOR OTHER DATA

C 3

PUMPING TEST

HOURS PUMPED (nearest hour) 3

PUMPING RATE (gal. per min. to nearest gal.) 10

METHOD USED TO MEASURE PUMPING RATE

WATER LEVEL (distance from land surface)

BEFORE PUMPING 23

WHEN PUMPING 160

TYPE OF PUMP USED (for test)

A air P piston T turbine
C centrifugal R rotary O other (describe below)
J jet S submersible

PUMP INSTALLED

DRILLER WILL INSTALL PUMP (CIRCLE APPROPRIATE BOX) YES NO

IF DRILLER INSTALLS PUMP, THIS SECTION MUST BE COMPLETED FOR ALL WELLS EXCEPT HOME USE

TYPE OF PUMP (WRITE APPROPRIATE LETTER IN BOX - SEE ABOVE: (A, C, J, P; R, S, T, O))

CAPACITY: GALLONS PER MINUTE (to nearest gallon)


PUMP HORSE POWER

PUMP COLUMN LENGTH (nearest ft.)

CASING HEIGHT (circle appropriate box and enter casing height)

above } LAND SURFACE
below } 3 (nearest foot)

LOCATION OF WELL ON LOT
SHOW PERMANENT STRUCTURE SUCH AS BUILDING, SEPTIC TANKS, AND/OR LANDMARKS AND INDICATE NOT LESS THAN TWO DISTANCES (MEASUREMENTS TO WELL)

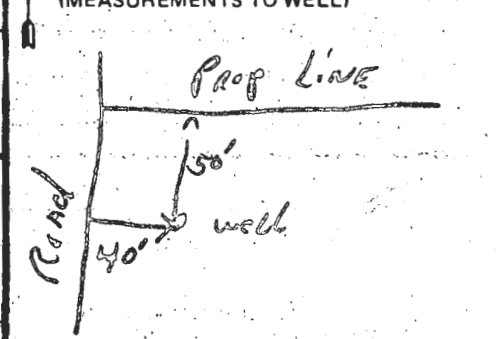

- A WELL WAS ABANDONED AND SEALED WHEN THIS WELL WAS COMPLETED
- E ELECTRIC LOG OBTAINED
- P TEST WELL CONVERTED TO PRODUCTION WELL

I HEREBY CERTIFY THAT THIS WELL HAS BEEN CONSTRUCTED IN ACCORDANCE WITH COMAR 10.17.13 "WELL CONSTRUCTION" AND IN CONFORMANCE WITH ALL CONDITIONS STATED IN THE ABOVE CAPTIONED PERMIT, AND THAT THE INFORMATION PRESENTED HEREIN IS ACCURATE AND COMPLETE TO THE BEST OF MY KNOWLEDGE.

DRILLERS IDENT. NO. 223
Ralph E. Mayne
DRILLERS SIGNATURE
(MUST MATCH SIGNATURE ON APPLICATION)

SITE SUPERVISOR (sign of driller or journeyman responsible for sitework if different from permittee)