

C1 3120

SEQUENCE NO. (OEP USE ONLY)

STATE OF MARYLAND WELL COMPLETION REPORT

THIS REPORT MUST BE SUBMITTED WITHIN 45 DAYS AFTER WELL IS COMPLETED.

(THIS NUMBER IS TO BE PUNCHED IN COLS. 3-6 ON ALL CARDS)

COUNTY NUMBER A22317

Date Received (OEP use only)

DATE WELL COMPLETED

3/10/82

Depth of Well

165

(TO NEAREST FOOT)

PERMIT NO.

FROM "PERMIT TO DRILL WELL"

40-73-4120

OWNER D&B Construction Company - Doug Pruett

STREET OR RFD Sharp Road TOWN Glenwood

SUBDIVISION Gwenee Estates SECTION 3 LOT 5

WELL LOG

Not required for driven wells

STATE THE KIND OF FORMATIONS PENETRATED, THEIR COLOR, DEPTH, THICKNESS AND IF WATER BEARING

Table with columns: DESCRIPTION, FEET FROM, FEET TO, Check if water bearing. Rows include Brown shale, Sand, Gray mica rock.

GROUTING RECORD

WELL HAS BEEN GROUTED (Y/N), TYPE OF GROUTING MATERIAL, CEMENT, BENTONITE CLAY, NO. OF BAGS, NO. OF POUNDS, GALLONS OF WATER, DEPTH OF GROUT SEAL.

CASING RECORD

Diagram of casing types (ST, CO, PL, OT), MAIN CASING TYPE, Nominal diameter, Total depth of main casing.

OTHER CASING (if used) diameter, depth

SCREEN RECORD

Diagram of screen types (ST, BR, HO, PL, OT), screen type or open hole, slot size.


Table for screen depth with columns for depth (nearest ft.) and rows for each screen.

DIAMETER OF SCREEN (NEAREST INCH), GRAVEL PACK, IF WELL DRILLED WAS FLOWING WELL CIRCLE BOX.

OEP USE ONLY (NOT TO BE FILLED IN BY DRILLER), T, WQ, TELESCOPE CASING, LOG INDICATOR, OTHER DATA.

PUMPING TEST, HOURS PUMPED, PUMPING RATE, METHOD USED TO MEASURE PUMPING RATE, WATER LEVEL, BEFORE PUMPING, WHEN PUMPING, TYPE OF PUMP USED.

PUMP INSTALLED, DRILLER WILL INSTALL PUMP, IF DRILLER INSTALLS PUMP, TYPE OF PUMP, CAPACITY, GALLONS PER MINUTE, PUMP HORSE POWER, PUMP COLUMN LENGTH, CASING HEIGHT, LAND SURFACE.

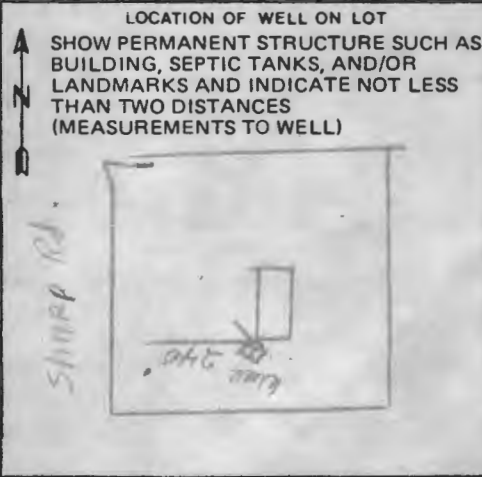

- CIRCLE APPROPRIATE BOX: A WELL WAS ABANDONED AND SEALED, ELECTRIC LOG OBTAINED, TEST WELL CONVERTED TO PRODUCTION WELL.

I HEREBY CERTIFY THAT THIS WELL HAS BEEN CONSTRUCTED IN ACCORDANCE WITH COMAR 10.17.13 "WELL CONSTRUCTION" AND IN CONFORMANCE WITH ALL CONDITIONS STATED IN THE ABOVE CAPTIONED PERMIT...

DRILLERS IDENT NO. 238, DRILLERS SIGNATURE Joseph P. Harper

SITE SUPERVISOR (sign of driller or journeyman responsible for sitework if different from permittee)