

6/15/82
Be. Mealy
around 1:00 P.M.

PERMIT

Approved 6/18/82
Stager
P 31969
31969
A 22317

SEWAGE DISPOSAL SYSTEM
MARYLAND STATE DEPARTMENT OF HEALTH

HOWARD COUNTY

ELLICOTT CITY

DISTRICT 4th

DATE 6/8/82

INDEX

D. D. & B. Construction Company, Inc. IS PERMITTED TO INSTALL ALTER

ADDRESS 14621 Peach Orchard Road, Silver Spring, Md. 20904 PHONE 384-1140

SUBDIVISION Gwenlee Estates ROAD 3191 Sharp Road LOT 5, Sec. 3, Area 2

PROPERTY OWNER Douglas Pruett

ADDRESS 8111 15th Avenue, Hyattsville, Maryland 20783

SPECIFICATIONS 4 bedrooms

SEPTIC TANK CAPACITY 1250 GALLONS

DRAIN FIELD _____ DEPTH _____ FEET, BOTTOM AREA _____ SQ. FT.

DEEP TRENCH _____ DEPTH _____ FEET, BOTTOM AREA _____ SQ. FT.

DRY WELL SEEPAGE PITS XXH ABSORBENT SIDE-WALL AREA 170 SQ. FT. per bedroom

INLET PIPE 4 1/2 FT. BELOW ORIGINAL GRADE. MAXIMUM DEPTH 10 FT. BELOW ORIGINAL GRADE

EFFECTIVE DEPTH AT _____ FT. BELOW ORIGINAL GRADE.

LOCATE DISPOSAL AREA 115 FT. FROM front LOT LINE AND 15 FT. FROM left LOT LINE AS SEEN WHEN

FACING LOT FROM Sharp Road. Okay to add trench off dry well if needed to make up absorbent sidewall area in system. NOTE: IF GARBAGE GRINDER IS USED SEPTIC TANK

CAPACITY NEEDS TO BE INCREASED BY 50% AND DISPOSAL AREA BY 22%.

PLANS APPROVED BY Raymond Hodges & Frank Skinner DATE 1/13/78 & 5/10/82

COVER NO WORK UNTIL INSPECTED AND APPROVED.

NEITHER THE HOWARD COUNTY COUNCIL NOR THE HEALTH DEPARTMENT IS RESPONSIBLE FOR THE SUCCESSFUL OPERATION OF ANY SYSTEM.

NOTE: IF TRENCH IS USED CALL FOR INSPECTION BEFORE PLACING GRAVEL IN TRENCH.

NOTE: NO DRY WELL SHALL EXCEED 15 FOOT IN DIAMETER.

NOTE: ALL PIPE FROM HOUSE TO DISPOSAL AREA MUST BE CAST IRON.

PERMIT VOID AFTER THREE YEARS.


NOTE: INSTALL STAND PIPE ON SEPTIC TANK AND DRY WELL. STAND PIPES MUST BE 6 INCHES IN DIAMETER. CAST IRON, CONCRETE OR TERRA COTTA ACCEPTED.

*INSTALLER IS RESPONSIBLE FOR OBTAINING FINAL APPROVAL ON THIS PERMIT.

A 22317 31969

22317

170
680

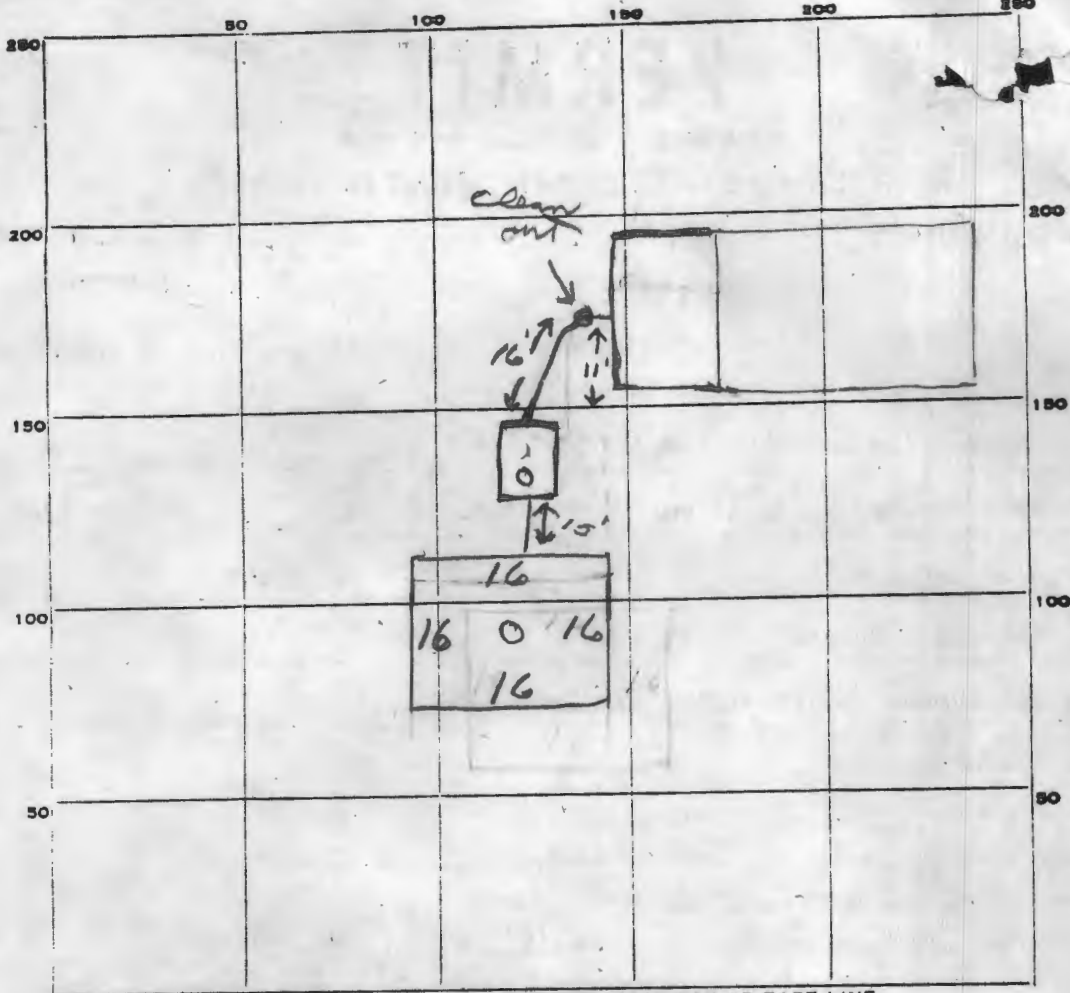

B.P. SFD
49326

INDICATE NORTH. - NAME ADJOINING ROADWAY AS BASE LINE.

Sharp Road

PERMIT CARD

SEPTIC TANK, LEVEL CLEANOUTS ST / DW

DISTRIBUTION BOX, LEVEL _____

TILE FIELD, DEPTH _____ FT. TRENCH WIDTH _____ FT.

GRAVEL DEPTH _____ IN. TOTAL LENGTH _____ FT.

NUMBER OF TRENCHES _____ TOTAL BOTTOM AREA _____

SEEPAGE PITS, INSIDE DIAMETER 64 FT. DEPTH BELOW INLET 10 1/2 FT.

ABSORBENT AREA 672 SQ. FT.

REMARKS 6/18/82 - Dry well dug 4 ft deeper than spec's
what appears to be honest error. Dry well cavity looked
to be excellent once from spec with no water problems
so I approved this one time only. Location OK ft
6/18/82 OK to cover all work

DATE SYSTEM APPROVED 6/18/82 INSPECTOR Stayer