

6/15/67
Ready

app. 6-15-67
Dunin

PERMIT

P 12651
A 58113-T
A 09009

SEWAGE DISPOSAL SYSTEM

MARYLAND STATE DEPARTMENT OF HEALTH

HOWARD COUNTY

ELLICOTT CITY

INDEXED

DISTRICT 3

DATE 5-5-67

Adeock Excavating Co., Inc.

IS PERMITTED TO INSTALL ALTER

ADDRESS 5545 Deloris Ave. Baltimore, Md. 21227 PHONE 247-1024

A SEWAGE DISPOSAL-SYSTEM LOCATED AT _____

SUBDIVISION Burnt Wood ROAD 3302 Sharp Rd LOT 15, Blk. A, Sec 3 Pt. 2

PROPERTY OWNER Burnt Woods Development Co., Inc.

ADDRESS 212 Greenwood Road, E.C., Md. 21043

SPECIFICATIONS 4 Bedrooms

DRAIN FIELD _____ DEPTH _____ FEET, BOTTOM AREA _____ SQ. FT.

SEEPAGE PITS _____ ABSORBENT SIDE-WALL AREA _____ SQ. FT.

SEPTIC TANK CAPACITY 1,000 GALLONS

FOR GARBAGE GRINDER, INCREASE DISPOSAL AREA 22% & TANK CAPACITY 50%.

OTHER Dry Well - 138 sq. ft. sidewall area below inlet pipe per bedroom inlet pipe must be 4 ft below grade. Place Dry Well - 20 ft. from front lot line and 29 ft. from left side line as seen when facing lot from Sharp Rd. Maximum depth 14 1/2 ft. below original grade.

PERMIT VOID AFTER THREE YEARS.


PLANS APPROVED BY D. W. Monaghan DATE 9-28-64

FILL SEPTIC TANK AND DISTRIBUTION BOX WITH WATER BEFORE CALLING FOR AN INSPECTION. COVER NO WORK UNTIL INSPECTED AND APPROVED.

NEITHER THE HOWARD COUNTY COMMISSIONERS NOR THE HEALTH DEPARTMENT IS RESPONSIBLE FOR THE SUCCESSFUL OPERATION OF ANY SYSTEM.

NOTIFY THE HEALTH DEPARTMENT 48 HOURS BEFORE EXCAVATIONS ARE TO BE BACK FILLED.

58113-1
A 09009

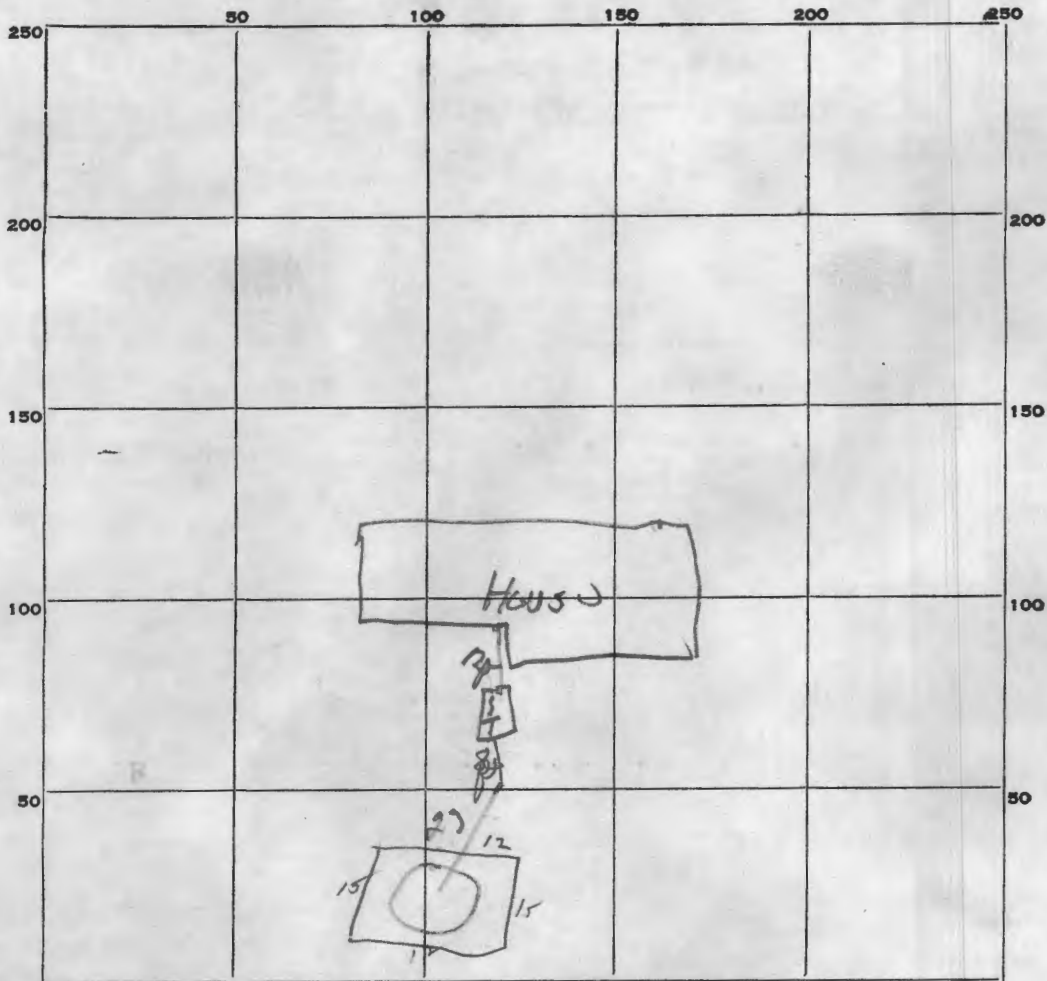

INDICATE NORTH, - NAME ADJOINING ROADWAY AS BASE LINE.

Shang Ro

PERMIT CARD OK

SEPTIC TANK, LEVEL OK

CLEANOUTS OK

DISTRIBUTION BOX, LEVEL _____

TILE FIELD, DEPTH _____ FT. TRENCH WIDTH _____ FT.

GRAVEL DEPTH _____ IN. TOTAL LENGTH _____ FT.

NUMBER OF TRENCHES _____ TOTAL BOTTOM AREA _____

SEEPAGE PITS, INSIDE DIAMETER Perimeter of poly well 54 FT. DEPTH BELOW INLET 10 FT.

ABSORBENT AREA 540 SQ. FT.

REMARKS _____

DATE SYSTEM APPROVED

6/15/67

INSPECTOR

Du Meng