

APPLICATION

A 09009

P _____

SEWAGE DISPOSAL TESTING

MARYLAND STATE DEPARTMENT OF HEALTH

HOWARD COUNTY

ELLICOTT CITY

DISTRICT 3

DATE 9/9/64

Septic Tank - 3 bedroom - 750 gal
4 " - 1000 gal
5 " - 1500 gal.

Dry Well - 138 sq ft sidewalk area below inlet pipe for bedroom toilet pipe must be 4 ft below grade

Place Dry Well 50 ft from front lot line and 50 ft from left side line as seen when facing lot from Sharp Rd.

TO: THE COUNTY HEALTH OFFICER
ELLICOTT CITY, MARYLAND

I, HEREBY, APPLY FOR THE NECESSARY TESTS IN ORDER TO CONSTRUCT (OR RECONSTRUCT) A SEWAGE DISPOSAL SYSTEM.

PROPERTY OWNER Burnt Woods Development Co., Inc.

ADDRESS 212 Greenwood Road, E.C., Md. PHONE NO 5-1345

PROPERTY LOCATION:

SUBDIVISION Burnt Wood LOT NO. 15, Blk. A, Sec. 2 ^{sec 3 pt. 2}

ROAD AND DESCRIPTION Sharp Rd

OCCUPANT _____ PHONE _____

PERSON TO CONSTRUCT SYSTEM _____

ADDRESS _____ PHONE _____

SIZE OF LOT 210' x 261' x 120' TYPE BLDG. test per bedroom
NUMBER OF BEDROOMS 4

IF NOT SINGLE RESIDENCE DESCRIBE _____

SIGNATURE OF APPLICANT /s/ M. A. Wakefield, Jr.


APPROVED BY [Signature] FOR Dry Well DATE 7/28/64
(KIND OF SYSTEM)

REJECTED BY _____ FOR _____ DATE _____
(KIND OF SYSTEM)

HOLD PENDING FURTHER TESTS _____ DATE _____

REASONS FOR REJECTION OR HOLDING _____

THIS IS NOT A PERMIT

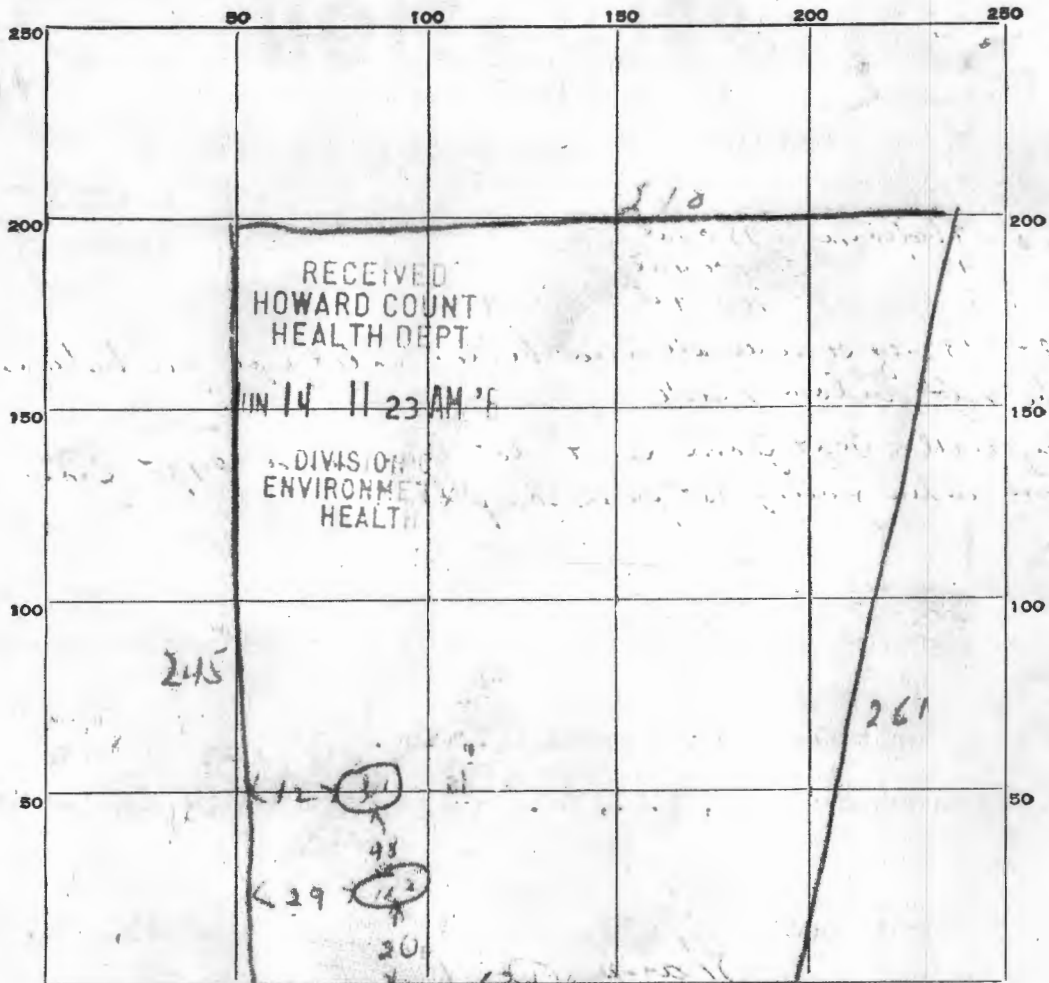

INDICATE NORTH. NAME ADJOINING ROADWAY AS BASE LINE.

Shemp Rd

DATE	TEST NO.	DEPTH	PRE-WET		TEST - 1" DROP		TIME
			START	STOP	START	STOP	
9/16/64	1	10 1/2 ft	152	154	154	206	12 min
	2	5 1/2 ft	152	156	156	204	8 min
	3	10 1/2 ft	155	157	157	211	14 min
	4	5 1/2 ft	156	207	207	229	22 min

SOIL AUGER FINDING

TESTED BY

Dum 9/16/64

REMARKS

ALSO PRESENT

L. Booth

LOT NO.

15A 263, pt. 2