


SITE INSPECTION SHEET

OWNER: _____ PHONE #: _____
ADDRESS: 3298 Sharp Rd. CONTRACTOR: United Propane
WELL TAG #: None
SUBDIVISION: _____ LOT: _____ COUNTY #: _____
PROPOSAL: LP tank location

LOCATION DIAGRAM

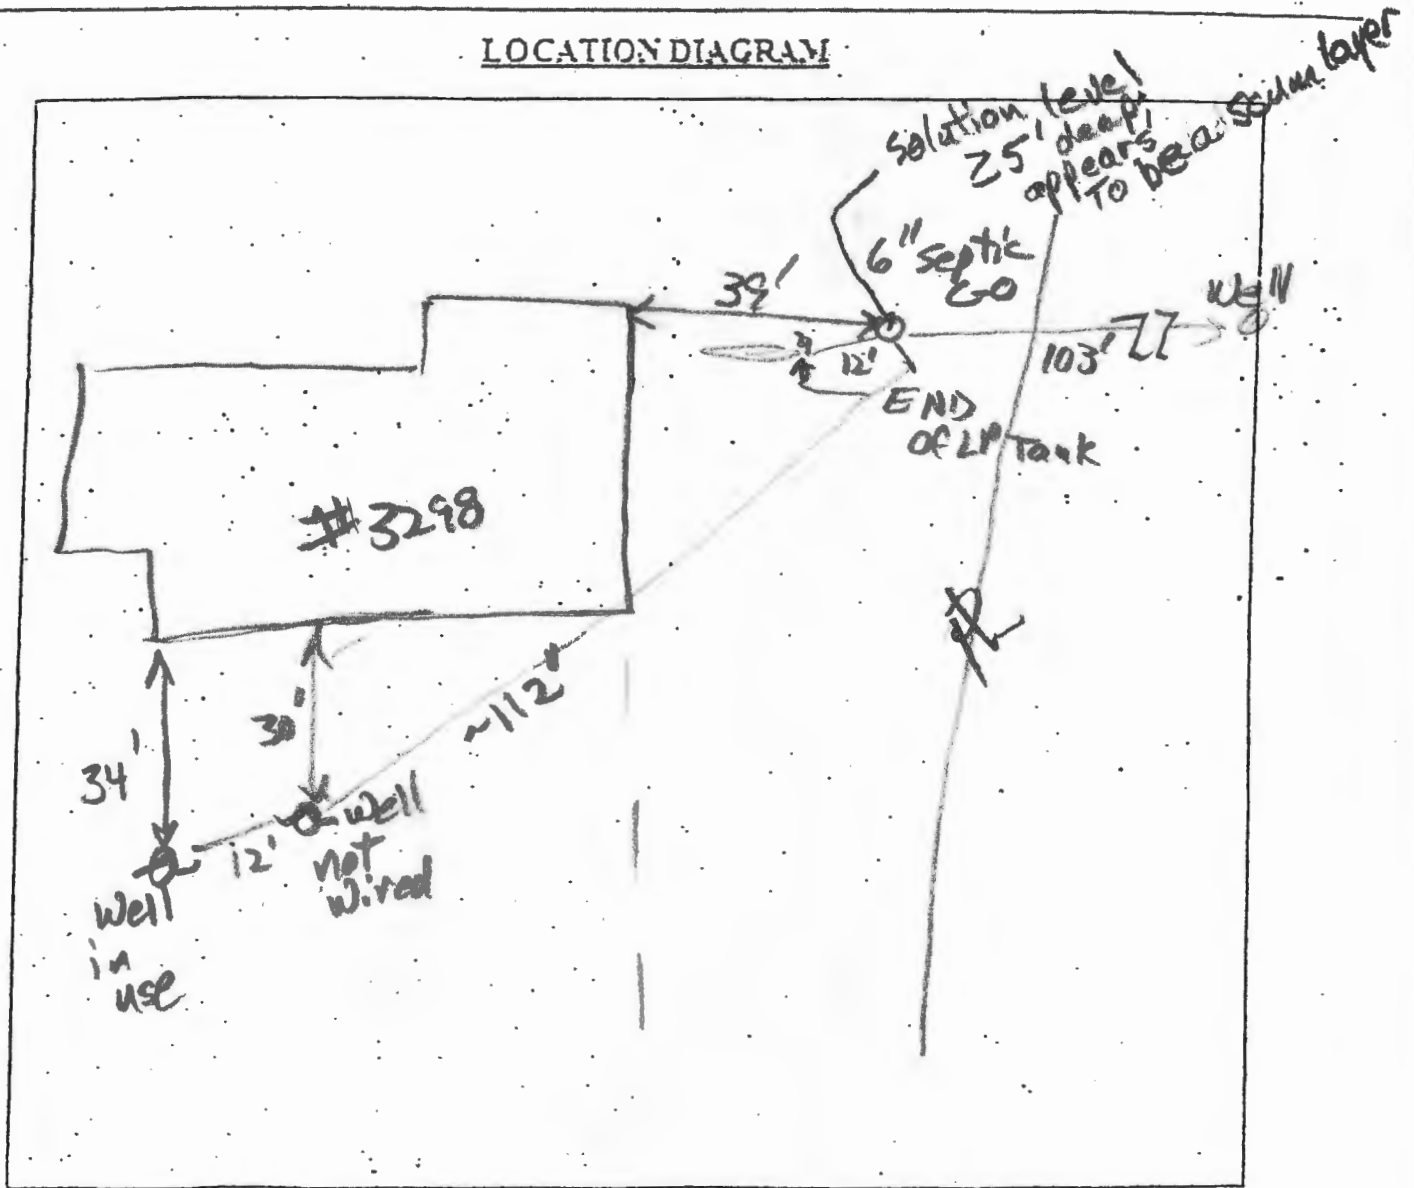


COMMENTS: Advised Applicant (Mollie Leedy) that indicated location, 12' from Dry Well cleanout, is OK (100' from well). Also emphasized importance of locating sewer line, prior to digging.
Y/21/10

SITE INSPECTION SHEET

OWNER: Peter Hamilton PHONE #: _____
ADDRESS: 3298 Sharp Rd CONTRACTOR: _____
SUBDIVISION: _____ LOT: _____ WELL TAG #: _____
COUNTY #: _____
PROPOSAL: 500 gal LP tank (underground)

LOCATION DIAGRAM

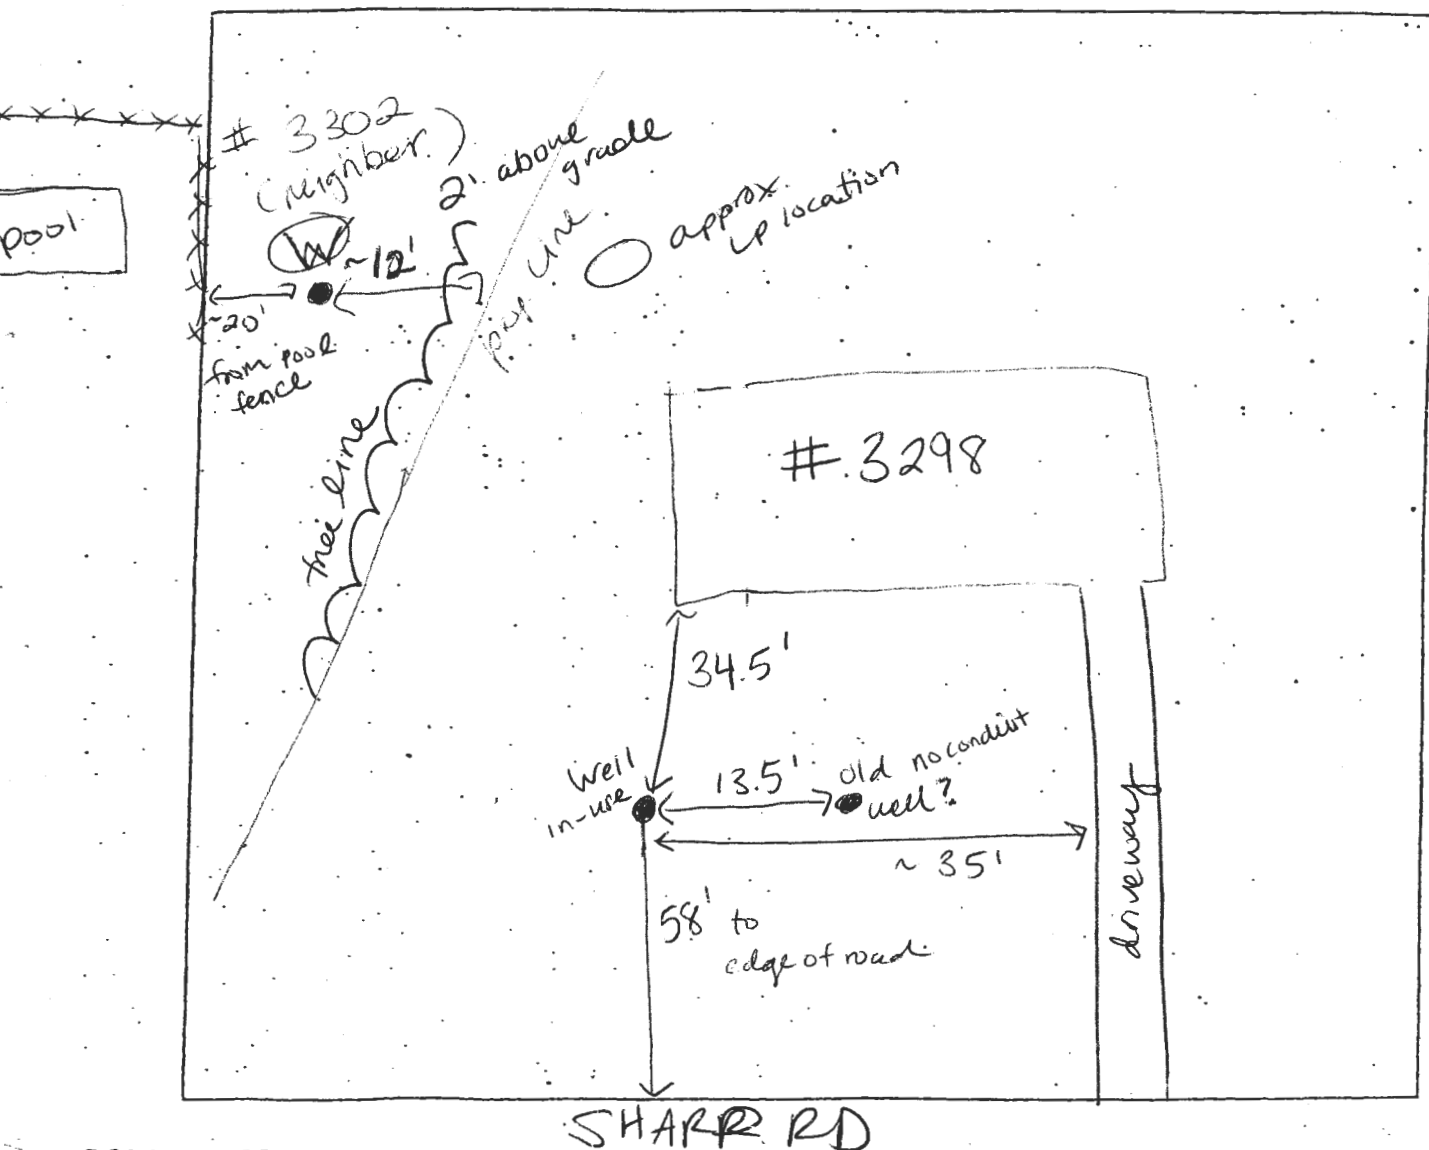

COMMENTS: _____
1-20-10 HS

proposed LP tank location not approvable
rfb

