


A# 00795

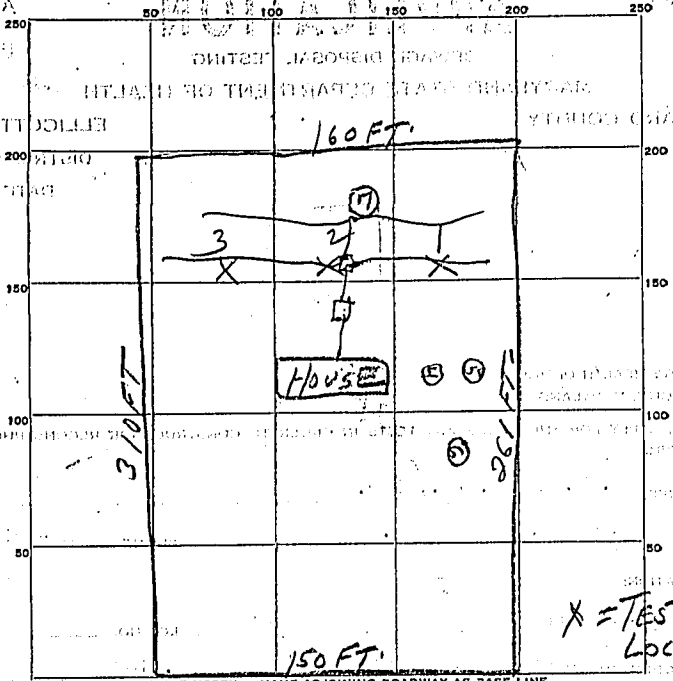

X = TEST HOLE LOCATIONS

INDICATE NORTH. - NAME ADJOINING ROADWAY AS BASE LINE.

DATE	TEST NO.	DEPTH	PRE-WET		TEST - 1" DROP		TIME
			START	STOP	START	STOP	
4-22-59	1	3 FT.	1:57	1:57	1:39	1:47	8 min
	2	3 FT.	1:35	1:39	1:39	1:47	8 min
	3		1:49	1:52	1:52	1:59	7 min
A-033542-17-61	4		10:02	10:24			
	5		10:03				
	6		10:04				
	7	6 FT.	11:13	11:26	11:26	11:44	18 min

A-033542-17-61
 2-17-61
 Carl H. Williams

SOIL AUGER FINDING

TESTED BY

J.H.

REMARKS

ALSO PRESENT

LOT NO. 5