

APPLICATION

SEWAGE DISPOSAL TESTING

MARYLAND STATE DEPARTMENT OF HEALTH

HOWARD COUNTY

ELLICOTT CITY

DISTRICT 4th

DATE 10/20/72

A 17572

P _____

TO: THE COUNTY HEALTH OFFICER
ELLICOTT CITY, MARYLAND

I, HEREBY, APPLY FOR THE NECESSARY TESTS IN ORDER TO CONSTRUCT (OR RECONSTRUCT) A SEWAGE DISPOSAL SYSTEM.

PROPERTY OWNER Fred A. Switzer

ADDRESS Cooksville, Md. 21723

PHONE 489-4304

PROPERTY LOCATION:

SUBDIVISION _____

LOT NO. _____

ROAD AND DESCRIPTION Route 97, Route 40 to 97, go north on 97 approximately 1/4 mile going north on left hand side of road. Mailbox with Switzer's name on it.

OCCUPANT _____

PHONE _____

PERSON TO CONSTRUCT SYSTEM _____

ADDRESS _____

PHONE _____

SIZE OF LOT 0.65 acre

Existing dwelling
TYPE BLDG. 3 bedrooms
NUMBER OF BEDROOMS

IF NOT SINGLE RESIDENCE DESCRIBE _____

SIGNATURE OF APPLICANT W. Whitney Wiley (Md. State Highway Adm.)

APPROVED BY C. Stecker

FOR Rdy Well

(KIND OF SYSTEM)

DATE 11/10/72

REJECTED BY _____

FOR _____

(KIND OF SYSTEM)

DATE _____

HOLD PENDING FURTHER TESTS _____


DATE _____

REASONS FOR REJECTION OR HOLDING Hold for P.W. or F.F. to review

Hold (written vertically on the left side of the page)

Double check location of Rdy Well relocation. C.B.A.
(Due to well)

THIS IS NOT A PERMIT

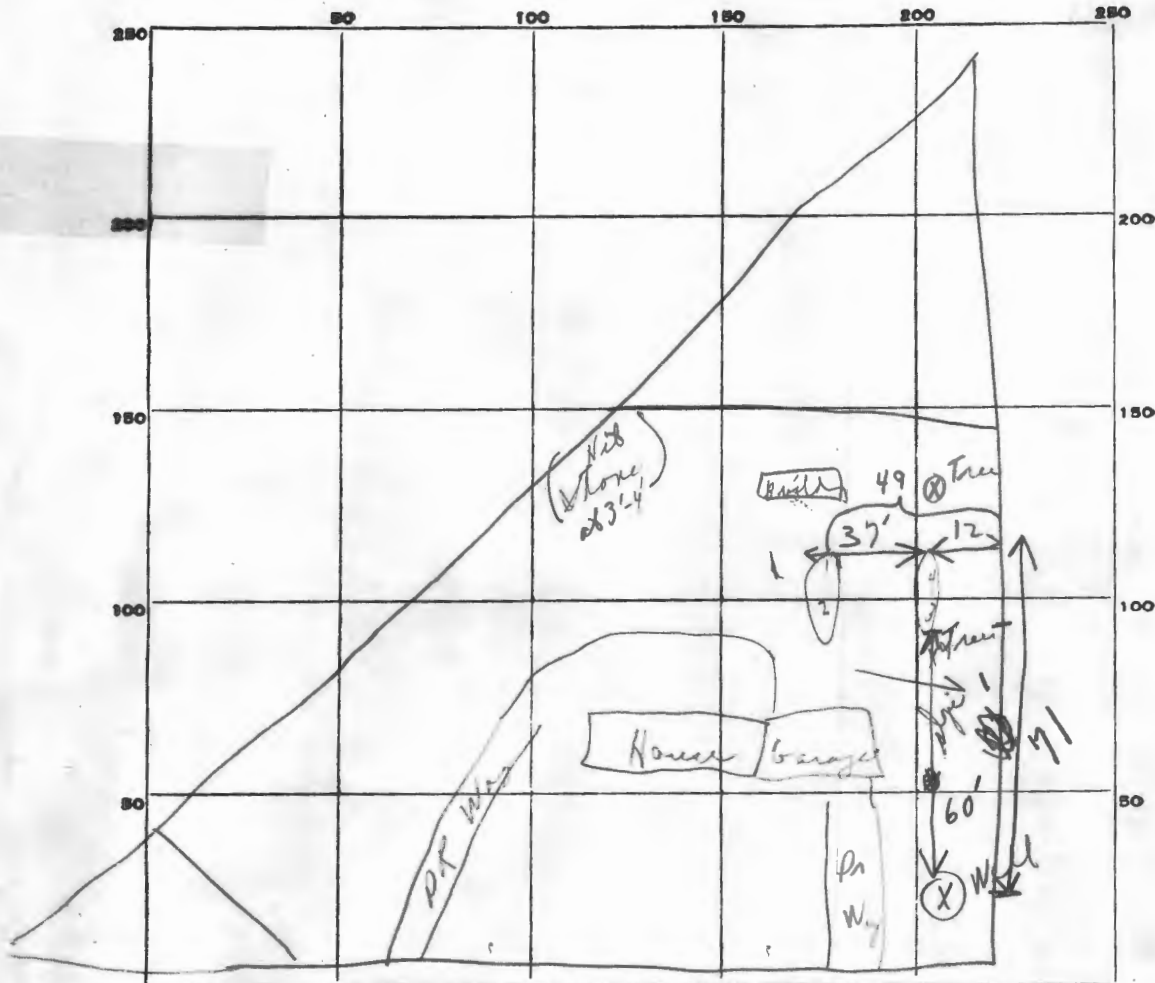

INDICATE NORTH. - NAME ADJOINING ROADWAY AS BASE LINE.

Md Route 99

DATE	TEST NO.	DEPTH	PRE-WET		TEST - 1" DROP		TIME
			START	STOP	START	STOP	
11/10/22	1	3' s	11:44	11:46	11:46	11:50	4 min
	2	10 1/2' o	11:44	11:47	11:47	11:58	11 min
	3	4' s	12:04	12:07	12:07	12:11	4 min
	4	11' b	12:06	12:08	12:08	12:12	4 min

3 7/8' good soil

#1 Edge of Prop Well

Use

Hold { Hole { 1 + 2 { Sinter mat 3' Maximum depth 10 1/2' Rock

SOIL AUGER FINDING

TESTED BY

B.S.

REMARKS

Sandy soil

APPLICATION

SEWAGE DISPOSAL TESTING

MARYLAND STATE DEPARTMENT OF HEALTH

HOWARD COUNTY

ELLICOTT CITY

DISTRICT 4th

DATE 10/20/72

A 17572
P _____

*2-12' ft holes
40 or 50 ft.
apart*
10/10/72

TO: THE COUNTY HEALTH OFFICER
ELLICOTT CITY, MARYLAND

I, HEREBY, APPLY FOR THE NECESSARY TESTS IN ORDER TO CONSTRUCT (OR RECONSTRUCT) A SEWAGE DISPOSAL SYSTEM.

PROPERTY OWNER Fred A. Switzer

ADDRESS Cockeville, Md. 21723

PHONE 489-4304

PROPERTY LOCATION:

SUBDIVISION _____ LOT NO. _____

ROAD AND ~~DISCUSS~~ Route 97, Route 40 to 97, go north on 97 approximately
1/2 mile going north on left hand side of road. Mailbox with Switzer's name

OCCUPANT _____ PHONE _____

PERSON TO CONSTRUCT SYSTEM _____

ADDRESS _____ PHONE _____

SIZE OF LOT 0.65 acre

TYPE BLDG. Existing dwelling
3 bedrooms
NUMBER OF BEDROOMS

IF NOT SINGLE RESIDENCE DESCRIBE _____

SIGNATURE OF APPLICANT W. Whitney Puley (Ind. State Highway ad)

APPROVED BY C. Stecker

FOR Dry Well
(KIND OF SYSTEM)

DATE 11/10/72

REJECTED BY _____

FOR _____
(KIND OF SYSTEM)

DATE _____

HOLD PENDING FURTHER TESTS _____

DATE _____


REASONS FOR REJECTION OR HOLDING

11/10/72 Hold for P.W. or F.F. to review.

Checked with F.F. ok. (Note location of Dry Well!!)

Double check location of Dry Well relocation. C.B.S.
(Due to well)

THIS IS NOT A PERMIT

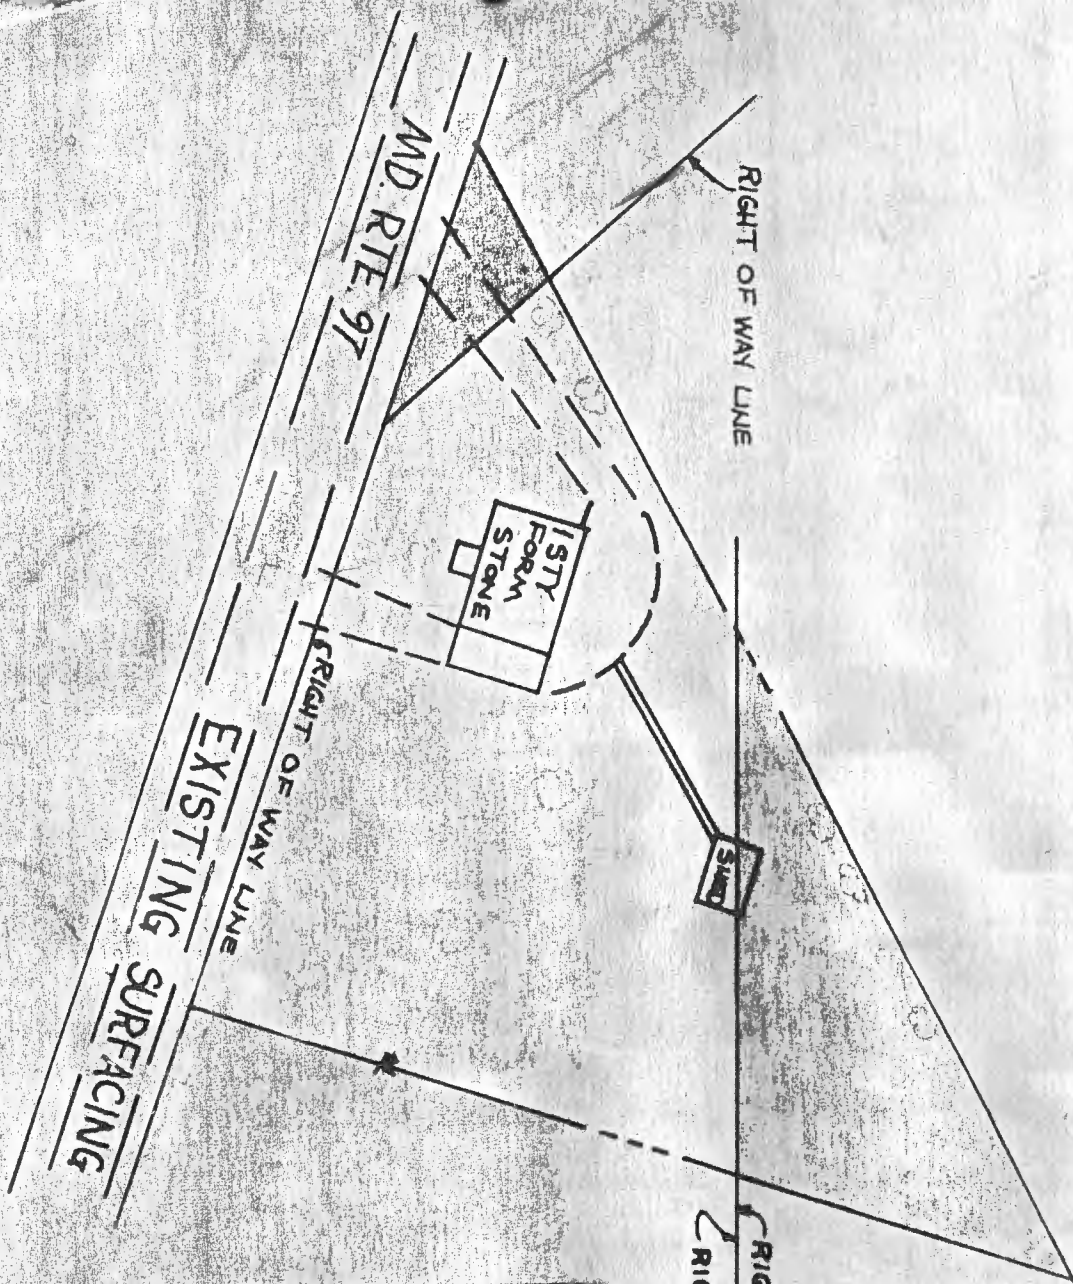

NAME	FRED A. SWITZER
ITEM NO.	60559
FEE	0.16 ACT
PERPETUAL EASEMENT	—
REVERTIBLE EASEMENT	—
AREA REMAINING	0.42 /
SCALE	1" = 50'

Real Property Data Search (w3)

Search Result for HOWARD COUNTY

View Map		View GroundRent Redemption			View GroundRent Registration				
Tax Exempt:		Special Tax Recapture:							
Exempt Class:		NONE							
Account Identifier:		District - 04 Account Number - 329260							
Owner Information									
Owner Name:		BOND ADAM BOND HELEN			Use:		RESIDENTIAL		
Mailing Address:		33 CEDAR POND DR APT 3 WARWICK RI 02886-			Principal Residence:		NO		
					Deed Reference:		/17941/ 00112		
Location & Structure Information									
Premises Address:		1400 HOODS MILL RD SYKESVILLE 21784-0000			Legal Description:		.530 AR 1400 HOODS MILL RD SYKESVILLE		
Map:	Grid:	Parcel:	Sub District:	Subdivision:	Section:	Block:	Lot:	Assessment Year:	Plat No:
0008	0017	0126		0000				2017	Plat Ref:
Special Tax Areas:				Town:		NONE			
				Ad Valorem:		100			
				Tax Class:					
Primary Structure Built		Above Grade Living Area		Finished Basement Area		Property Land Area		County Use	
1948		1,224 SF		180 SF		23,086 SF			
Stories	Basement	Type	Exterior	Full/Half Bath	Garage	Last Major Renovation			
1 1/2	YES	STANDARD UNIT	FRAME	2 full	1 Attached				
Value Information									
		Base Value		Value		Phase-in Assessments			
				As of		As of		As of	
				01/01/2017		07/01/2018		07/01/2019	
Land:		173,600		148,000					
Improvements		58,400		102,700					
Total:		232,000		250,700		244,467		250,700	
Preferential Land:		0						0	
Transfer Information									
Seller: ODONNELL SHAWN M				Date: 11/29/2017		Price: \$268,000			
Type: ARMS LENGTH IMPROVED				Deed1: /17941/ 00112		Deed2:			
Seller: HOUGH LINDA G				Date: 06/02/2016		Price: \$250,000			
Type: ARMS LENGTH IMPROVED				Deed1: /16885/ 00261		Deed2:			
Seller: HOUGH LINDA G				Date: 01/10/2000		Price: \$115,000			
Type: ARMS LENGTH IMPROVED				Deed1: /04988/ 00690		Deed2:			
Exemption Information									
Partial Exempt Assessments:		Class		07/01/2018		07/01/2019			
County:		000		0.00					
State:		000		0.00					
Municipal:		000		0.00 0.00		0.00 0.00			
Tax Exempt:		Special Tax Recapture:							
Exempt Class:		NONE							
Homestead Application Information									