

1/2/81
Permit
APPLICATION

SEWAGE DISPOSAL TESTING

STATE OF MARYLAND - DEPARTMENT OF HEALTH AND MENTAL HYGIENE

A 29411
P _____

HOWARD COUNTY HEALTH DEPARTMENT
ENVIRONMENTAL HEALTH SERVICES
P.O. BOX 476 ELLICOTT, MARYLAND 21043
TELEPHONE: 992-2330

DISTRICT 4th
DATE 1/17/79

TO: THE COUNTY HEALTH OFFICER
ELLICOTT CITY, MARYLAND

I, HEREBY, APPLY FOR THE NECESSARY TEST IN ORDER TO CONSTRUCT (OR RECONSTRUCT) A SEWAGE DISPOSAL SYSTEM.

PROPERTY OWNER H.B.L. Properties, Inc. DAVID & DENA CADOGAN

ADDRESS _____ PHONE Boender - 465-7777

PROPERTY LOCATION Now # 6

SUBDIVISION _____ LOT NO. 12

ROAD AND DESCRIPTION Old Frederick Road
14651 Red Lion Drive

SIZE OF LOT 4.1 acres TYPE BLDG. 3 or 4 bedrooms

THE SYSTEM INSTALLED UNDER THIS APPLICATION IS ACCEPTABLE ONLY UNTIL PUBLIC FACILITIES BECOME AVAILABLE.

I FULLY UNDERSTAND THE FEE CONNECTED WITH THE FILING OF THIS PERC TEST APPLICATION IS NON-REFUNDABLE UNDER

ANY CIRCUMSTANCES.

SIGNATURE OF APPLICANT /s/ Jack Boender for E. Brooke Lee *spec written*

APPROVED BY Raymond Hodge FOR my well out reach DATE 6/17/84

REJECTED BY _____ FOR _____ DATE _____

HOLD PENDING FURTHER TESTS not 10,000 ft DATE _____

REASONS FOR REJECTION OR HOLDING 1/23/79 V. complete 1/23/79 V. complete 1/23/79 V. complete
6/25/81 not 10,000 ft, additional area req'd F.S. 1/23/79 V. complete 1/23/79 V. complete
1/23/79 V. complete 1/23/79 V. complete 1/23/79 V. complete

BP. 20844

THIS IS NOT A PERMIT

#6

#12

SOIL PROFILE

Below
loam



El. 30

INDICATE NORTH - NAME ADJOINING ROADWAY AS BASE LINE.

DATE	TEST NO.	DEPTH	PRE-WET		TEST - 1" DROP		TIME
			START	STOP	START	STOP	
1/25/79	1	11 -	ROCKY	THROUGHOUT			
	2.5	3	306	311	311	316	5
	2D	13	307	310	310	315	5
	3	5 -	3:49	3:51	3:51	3:54	3 min
1/23/79	(L) 4	14'	3:55	3:58	3:58	4:02	4 min
1/25/79	(SS) 5D	4	402	411	NO DROP		FAILS
		13 1/2	406	409	409	415	6
	6						
1/23/79	7		Veneer - loam below				
2.5D	(L) 8	13 1/2'	clay				
1/26/79	5 m	4 1/2'	125	132	132	145	13
						6	36

GLK

use for SY *

ended 3'

6 min

REMARKS

1/23/79 cold wet

TYPE OF SOIL


(L) - excellent sand

TESTED BY

1/23/79 C. B. 2 holes

ALSO PRESENT

Devina
Reims +

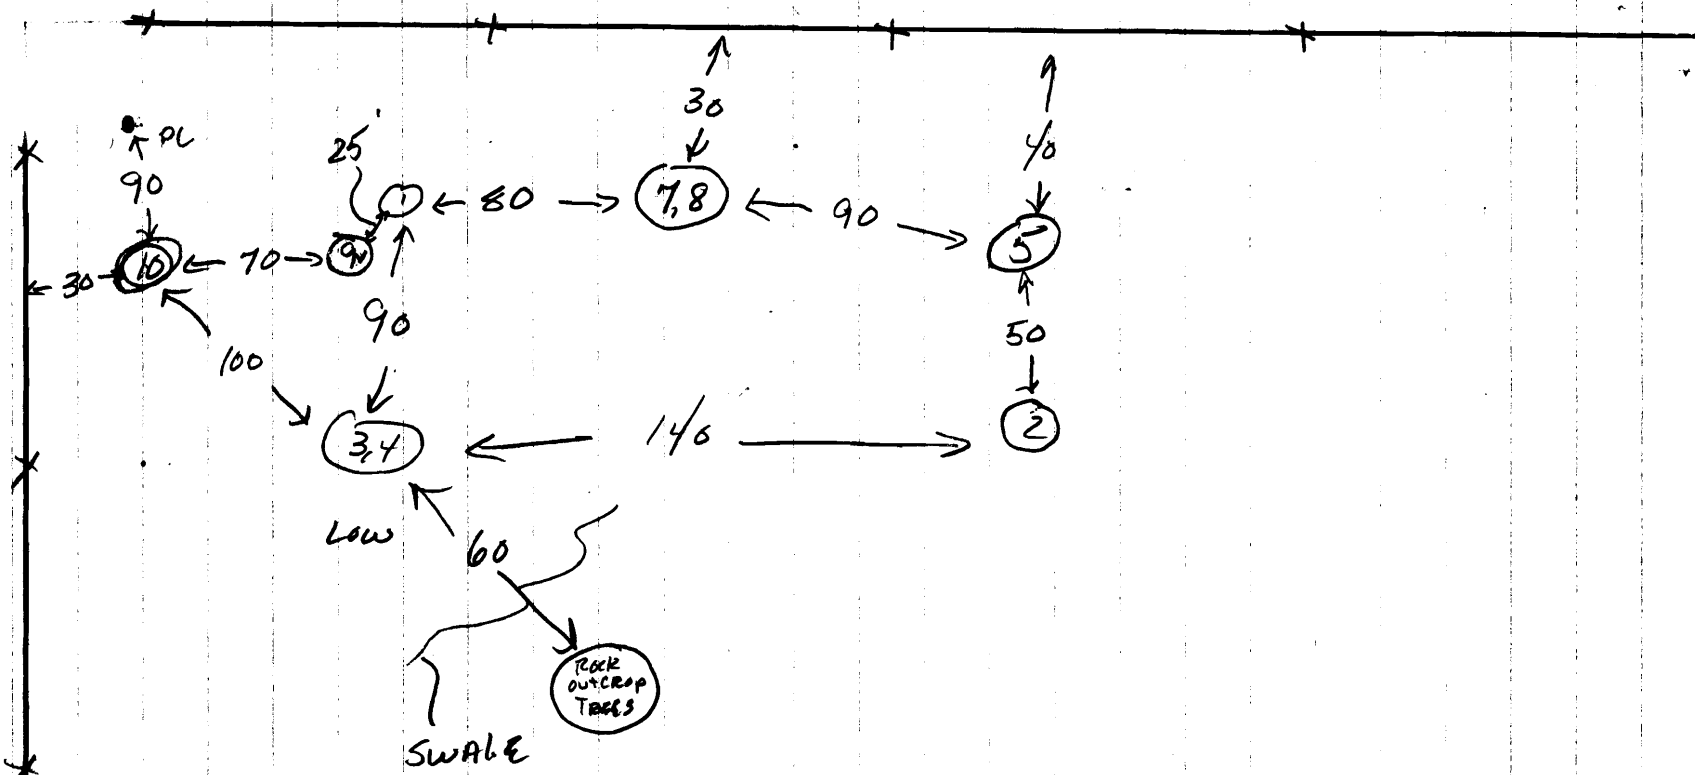


⑨ 1-4 clay (2-4 rocky), 4-13 Red + yellow Mottled loam some small chunk rock

⑩ S 4 1/2 11:27 11:32 11:36
 M 8 1/2 11:27 11:38 12:01
 D 9' sand Rock
 E, 100' Hole \$10 FS

1/2 - 9 Red + yellow Mottled loam
 Rocky 2 - 1/2'

SK 6/81

HBL Lot 6

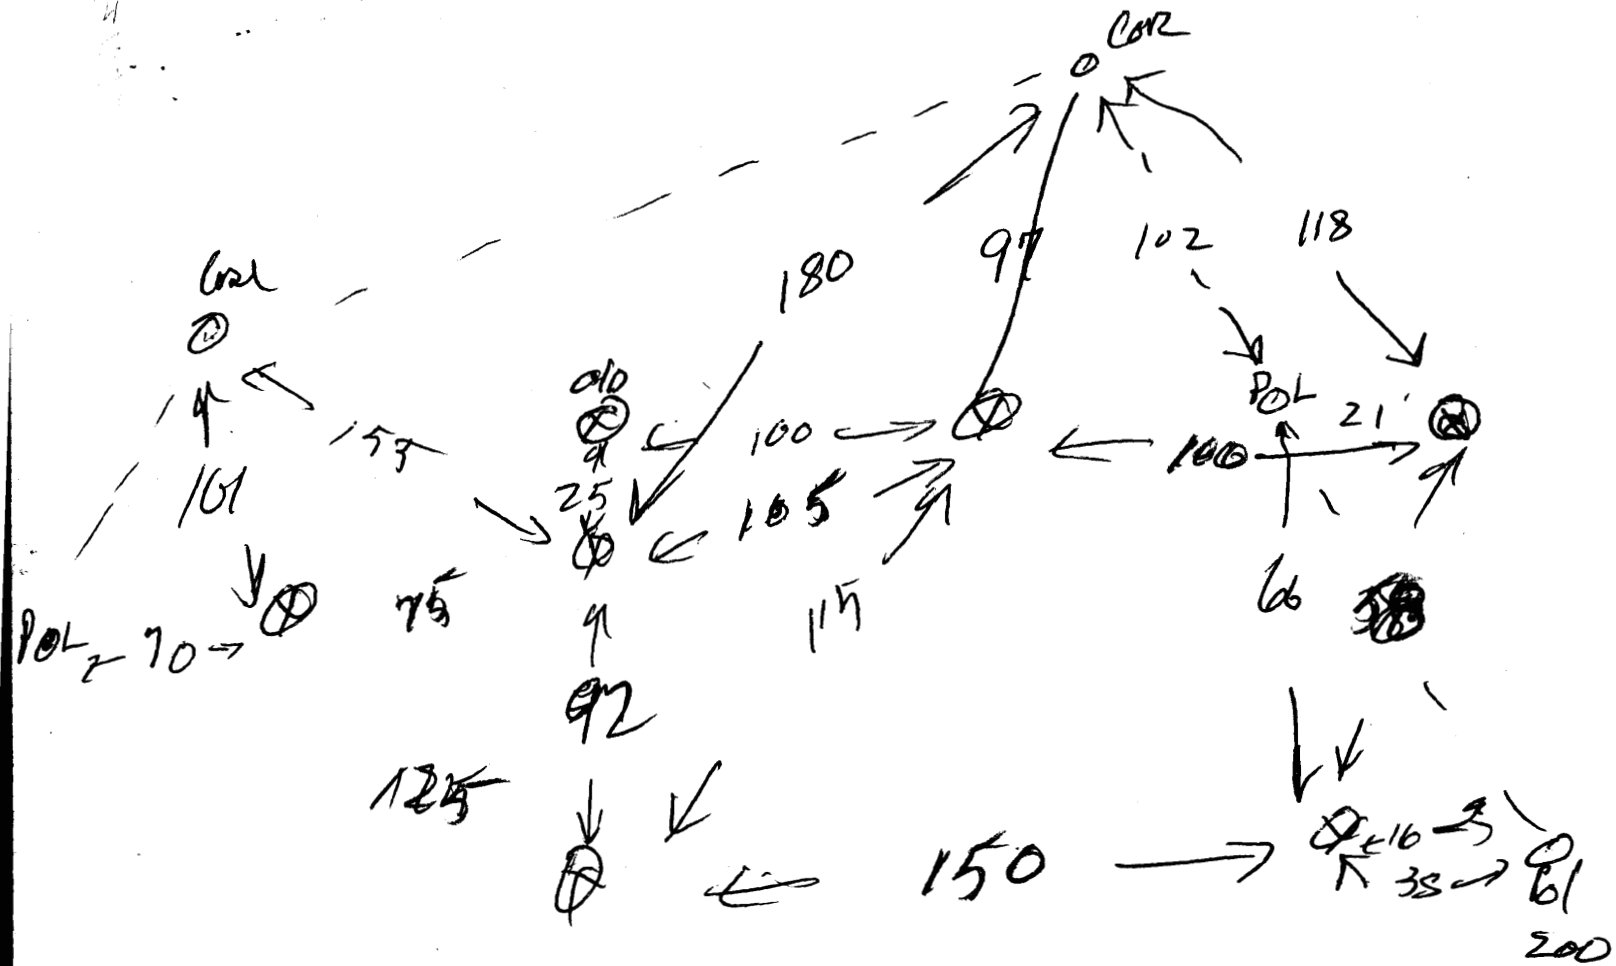

9K 8/4/81