

\*\*\*\*\*  
WATER WELL ABANDONMENT SEALING REPORT FORM  
\*\*\*\*\*

SUBMIT COPIES OF COMPLETED FORM TO:

- \* COUNTY ENVIRONMENTAL AGENCY (contact MDE, WMA if address needed)
- \* WELL OWNER
- \* MDE, WATER MANAGEMENT ADMINISTRATION, WELL PROGRAM

DATE WELL ABANDONED: 7/16/18 (month/day/year)

\* PERMIT NUMBER OF ABANDONED WELL (if any): \_\_\_\_\_


\* PERMIT NUMBER OF REPLACEMENT WELL: \_\_\_\_\_

\* PERSON ABANDONING WELL: John Greer WELL DRILLER'S LICENSE NUMBER: 086

\* OWNER'S NAME: Snap Holdings LLC CIRCLE: MWD / MSD / MGD

\* WELL LOCATION:  
COUNTY: Howard Co.  
NEAREST TOWN: CLARKSVILLE  
TAX MAP 0041 BLOCK 0001 PARCEL 0208  
SUBDIVISION: \_\_\_\_\_  
SECTION: \_\_\_\_\_ LOT: \_\_\_\_\_  
STREET ADDRESS: 12074 <sup>LOT</sup> Halt Shop Rd.

SITE LOCATION MAP

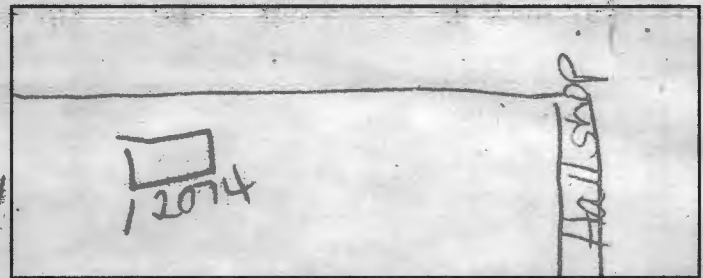

LATITUDE 3 9.105700

LONGITUDE 7 6.560737

LOG OF SEALING MATERIAL

MATERIAL	FEET	
	FROM	TO
Sand	15	5
Cement	5	2
Back Fill	2	0
VOLUME OF MATERIAL USED		
<u>5 cu yards.</u>		

\* TYPE OF WELL BEING ABANDONED:  
 DRILLED                       JETTED  
 BORED                          HAND DUG  
 OTHER (specify): \_\_\_\_\_

\* USE CODE:  
 DOMESTIC                      \_\_\_\_\_ MUNICIPAL/PUBLIC  
 IRRIGATION                    \_\_\_\_\_ INDUSTRIAL  
 TEST/OBSERVATION            \_\_\_\_\_ GEOTHERMAL

\* TYPE OF CASING:  
 STEEL                              \_\_\_\_\_ PLASTIC  
 CONCRETE                        \_\_\_\_\_ OTHER (specify) \_\_\_\_\_

SIZE OF CASING: 30' INCHES IN DIAMETER

DEPTH OF WELL: 15 FEET DEEP

WAS ANY CASING REMOVED?  YES \_\_\_\_\_ NO  
If yes, length removed, in feet: 3

WAS CASING RIPPED OR PERFORATED? \_\_\_\_\_ YES  NO

SIGNATURE-MASTER WELL DRILLER OR SUPERVISING SANITARIAN LICENSE#

086 MWD / MSD / MGS CIRCLE ONE 7/16/18 DATE

COUNTY

Pursuant to § 10-624 of the State Govt. Article of the Maryland Code, personal info requested on this form is used in processing this form pursuant to COMAR 26.04.04. Failure to provide the info may result in this form not being processed. You have the right to inspect, amend, or correct this form. The Maryland Department of the Environment is subject to the Maryland Public Information Act. This form may be made available on the Internet via MDE's website and is subject to inspection or copying, in whole or in part, by the public and other governmental agencies, if not protected by federal or State Law.

\*\*\*\*\*  
 WATER WELL ABANDONMENT-SEALING REPORT FORM  
 \*\*\*\*\*

**SUBMIT COPIES OF COMPLETED FORM TO:**

- \* COUNTY ENVIRONMENTAL AGENCY (contact MDE, WMA if address needed)
- \* WELL OWNER
- \* MDE, WATER MANAGEMENT ADMINISTRATION, WELL PROGRAM

DATE WELL ABANDONED: 7/16/18 (month/day/year)

\* PERMIT NUMBER OF ABANDONED WELL (if any) \_\_\_\_\_


\* PERMIT NUMBER OF REPLACEMENT WELL: \_\_\_\_\_

\* PERSON ABANDONING WELL: John Greer WELL DRILLER'S LICENSE NUMBER: 086

\* OWNER'S NAME: Snap Holdings LLC CIRCLE: MWD / MSD / MGD

SITE LOCATION MAP

\* WELL LOCATION:  
 COUNTY: Howard Co.  
 NEAREST TOWN: CRACKSVILLE  
 TAX MAP 0041 BLOCK 0001 PARCEL 0208  
 SUBDIVISION: \_\_\_\_\_  
 SECTION: \_\_\_\_\_ LOT \_\_\_\_\_  
 STREET ADDRESS: 12074 Hall Shop Rd

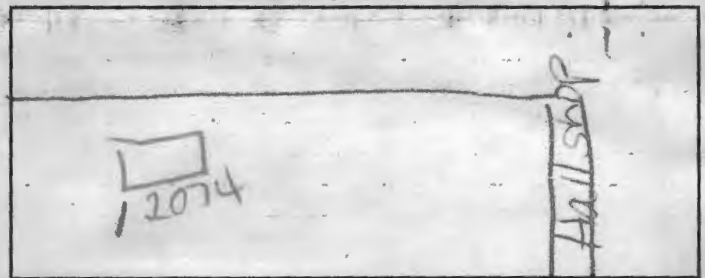

LATITUDE 3 9.105700  
 LONGITUDE 7 6.560737

LOG OF SEALING MATERIAL

MATERIAL	FEET	
	FROM	TO
Sand	15	5
Cement	5	2
Back Fill	2	0
VOLUME OF MATERIAL USED		
<u>5 cu yards</u>		

\* TYPE OF WELL BEING ABANDONED:  
 DRILLED  
 BORED  
 JETTED  
 HAND DUG  
 OTHER (specify) \_\_\_\_\_

\* USE CODE:  
 DOMESTIC  
 IRRIGATION  
 TEST/OBSERVATION  
 MUNICIPAL/PUBLIC  
 INDUSTRIAL  
 GEOTHERMAL

\* TYPE OF CASING:  
 STEEL  
 CONCRETE  
 PLASTIC  
 OTHER (specify) \_\_\_\_\_

SIZE OF CASING: 30' INCHES IN DIAMETER

DEPTH OF WELL: 15 FEET DEEP

WAS ANY CASING REMOVED?  YES  NO  
 If yes, length removed, in feet: 3

WAS CASING RIPPED OR PERFORATED?  YES  NO

SIGNATURE-MASTER WELL DRILLER OR SUPERVISING SANITARIAN LICENSE# \_\_\_\_\_

086

MWD / MSD / MGS  
 CIRCLE ONE

7/16/18  
 DATE