

APPLICATION

A 20645

SEWAGE DISPOSAL TESTING

P _____

STATE OF MARYLAND - DEPARTMENT OF HEALTH AND MENTAL HYGIENE

DISTRICT 3rd

HOWARD COUNTY HEALTH DEPARTMENT
ENVIRONMENTAL HEALTH SERVICES

DATE 9/9/74

P. O. BOX 476, ELLICOTT CITY, MARYLAND 21043
TELEPHONE: 463-3000, EXT. 336

Preliminary
9/13/74
9:30 A.M.

3 B.R. 1000gal septic tank | 4 B.R. 1250gal septic tank
125 SQ. FT. effective sidewall absorption area per bedroom, to begin below the first 3 1/2 ft. of non-porous soil. Maximum depth permitted for drywell is 1 1/2 ft. below original grade. Place the drywell 15ft. from the lot line that is 270 ft. long, and 130 ft. from the rear lot line that is 212 ft. long, as seen when facing the property from Ramsburg Road.

TO: THE COUNTY HEALTH OFFICER
ELLICOTT CITY, MARYLAND

I, HEREBY, APPLY FOR THE NECESSARY TEST IN ORDER TO CONSTRUCT (OR RECONSTRUCT) A SEWAGE DISPOSAL SYSTEM.

PROPERTY OWNER E. L. Ramsburg and wife

ADDRESS 185 Henryton Road, Marriottsville, Md. PHONE 328-2696

PROPERTY LOCATION:

SUBDIVISION Henryton Heights LOT NO. 14, Sec. 2

ROAD AND DESCRIPTION Ramsburg Road

SIZE OF LOT 62,000 sq. ft. ± TYPE BLDG. 3 or 4 bedrooms
NUMBER OF BEDROOMS

IF NOT SINGLE RESIDENCE DESCRIBE _____

THE SYSTEM INSTALLED UNDER THIS APPLICATION IS ACCEPTABLE ONLY UNTIL PUBLIC FACILITIES BECOME AVAILABLE.

SIGNATURE OF APPLICANT /s/ E. L. Ramsburg


APPROVED BY Frank Skinner FOR Drywell DATE 12/10/75
(KIND OF SYSTEM)

REJECTED BY _____ FOR _____ DATE _____
(KIND OF SYSTEM)

HOLD PENDING FURTHER TESTS _____ DATE _____

REASONS FOR REJECTION OR HOLDING _____

THIS IS NOT A PERMIT

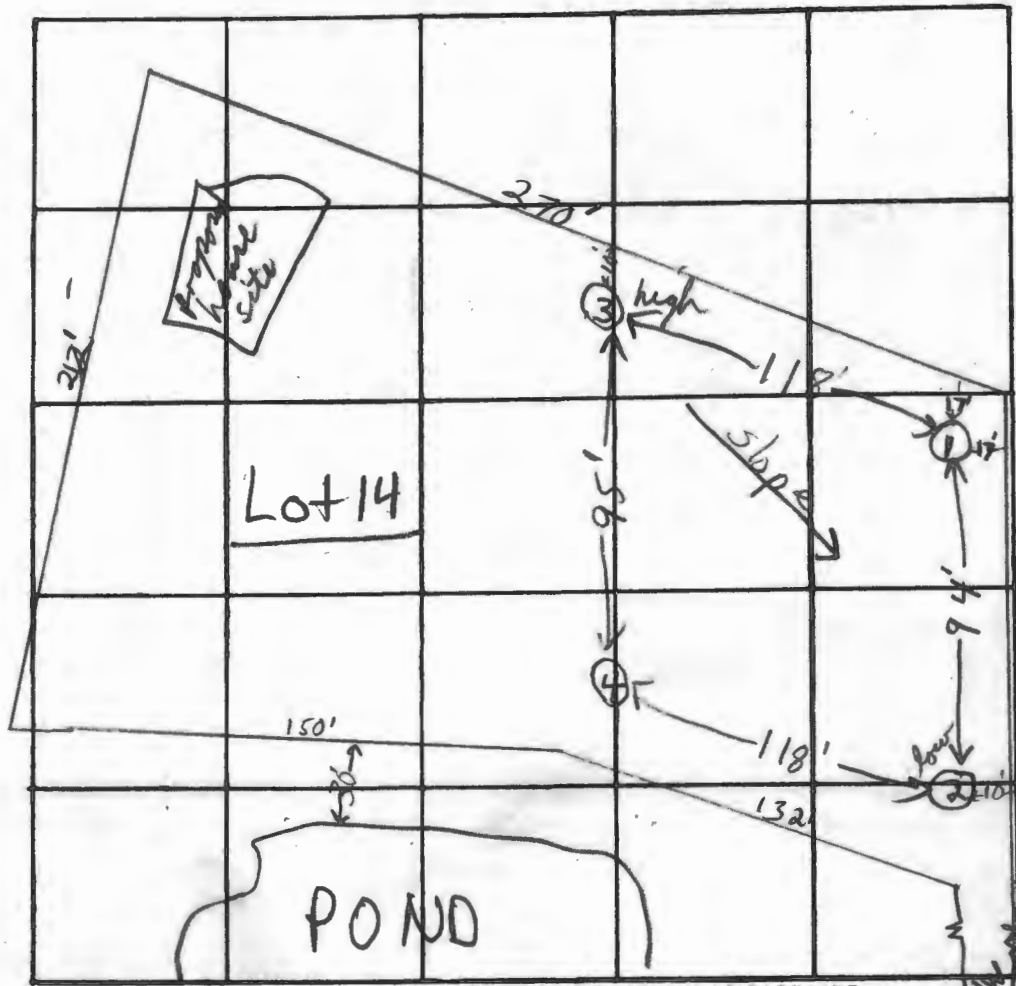

DATE	TEST NO.	DEPTH	PRE-WET		TEST - 1" DROP		TIME	
			START	STOP	START	STOP		
9/13/74	1	4'	1:44	1:45	1:45	1:47	2 min	
	1A	12 1/2'	1:44	1:47	1:47	1:53	6 min	
	2 low	3'	1:48	1:49	1:49	1:51	2 min	
	2A	12'	1:50	1:55	1:55	2:02	7 min	
	3 high	3 1/2'	2:10	2:11	2:11	2:13	2 min	
	3A	11 1/2'	2:15	2:16	2:16	2:19	3 min	
	4	11	Visual; top 4' clayey; mica lam below					

unit 3 1/2'

2
6
2
7
2
3
6 1/2

4 min avg.

REMARKS _____

TYPE OF SOIL mic. lam; sandy

TESTED BY F.S. & H.Z. ALSO PRESENT: Barth & Co.

TANCE
8.09'
6.35'


4"x4" Concrete Monument

EL RAMSBURG & WIFE
357/382

345.25'
212.00'

Lot 14
60,392[±] s.t.

Building Restriction Line
N64°25'30"W
150.00'

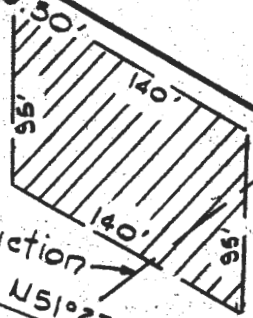


S43°30'50"E
743.30'
473.00'

N34°19'30"E
133.25'


2

Lot 15
119,110[±] s.t.

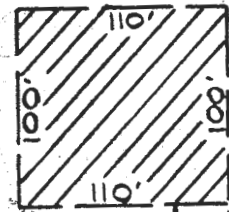

Lot 13
169,198[±] s.t.

Building Restriction Line
N73°31'50"W
390.00'

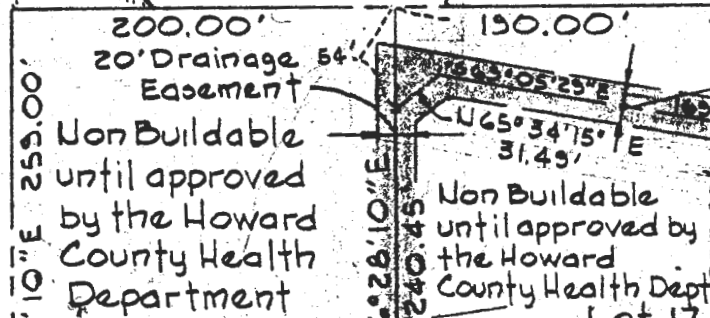

Building Restriction Line

Lot 16
50,350[±] s.t.

13

Non Buildable until approved by the Howard County Health Dept.
Lot 17
42,190[±] s.t.

N19°28'00"E
60.00'

S70°32'00"E
141.58'

12

ROAD
R=1670.00'
R=1730.00'

L=510.07'
S16°28'10"W
L=528.40'

299.96'

10

N70°32'00"W
141.58'


15

Building Restriction Line

Lot 18

14

EU RAMSBURG & WIFE
397/382

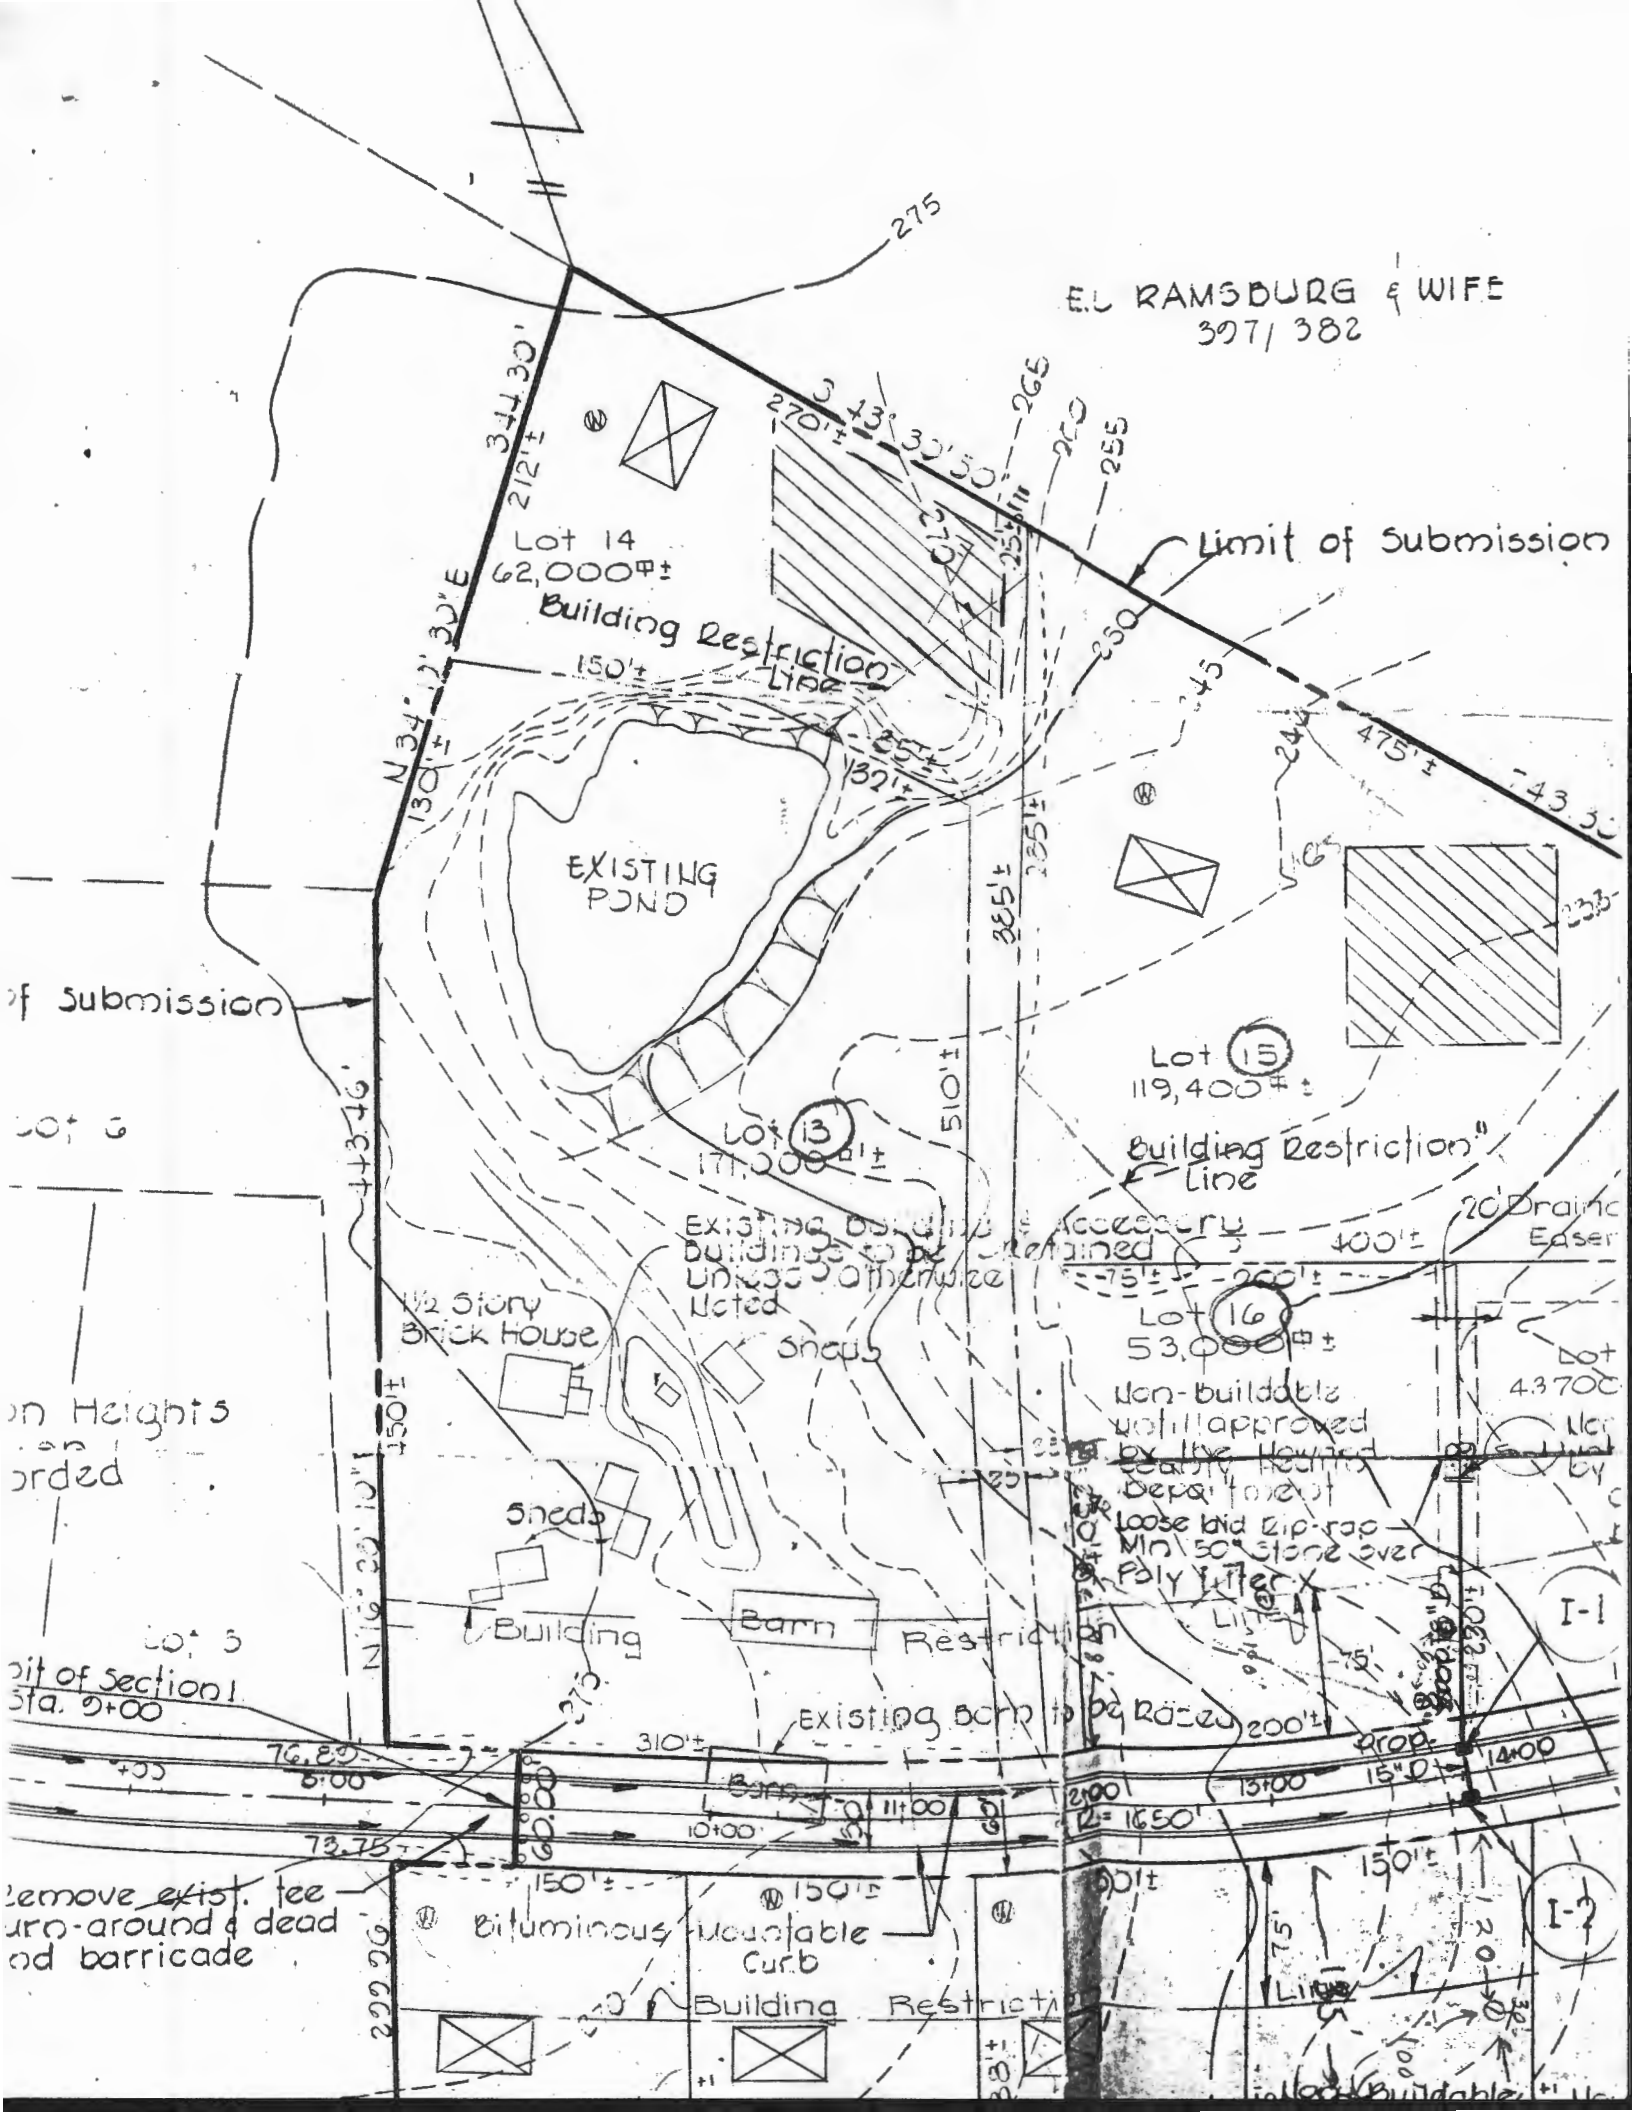

Lot 14
62,000[±]

Building Restriction Line

EXISTING POND

Limit of Submission

Lot 15
119,400[±]

Building Restriction Line

EXISTING BRICK HOUSE & ACCESSORY BUILDINGS TO BE MAINTAINED UNLESS OTHERWISE NOTED

Lot 16
53,000[±]

Non-buildable until approved by the Planning Department
loose bid rip-rap
Min. 50" Stone over
Poly Litter

1/2 Story Brick House

Sheds

Sheds

Building

Barn

Restriction

EXISTING BARN TO BE RAISED

Prop. 15" D.I.

Remove exist. tee turn-around & dead end barricade

Bituminous Mountable Curb

Building Restriction

I-1

I-2

12/16/97 * Wet season testing to be performed prior to well permit issuance - see perc results & perc. cert for SEPTIC SPECIFICATIONS WORK-SHEET explanation * AM

SUBDIVISION: Henrietta Heights Sec II A 20645

STREET NAME: Barnsburg Rd LOT NUMBER: 14

AVERAGE PERCOLATION RATE: _____ SQUARE FEET PER BEDROOM: _____

NUMBER OF BEDROOMS: _____ LINEAR FEET OF TRENCH PER BEDROOM: _____

TOTAL LINEAR FEET OF TRENCH: _____ SEPTIC TANK CAPACITY: _____

TOP SEAMED TANK REQUIRED? YES NO

COMPARTMENTED TANK REQUIRED? YES NO

TRENCH DIMENSIONS: Trench to be 3.0 feet wide. Inlet 3.0 feet below original grade. Bottom maximum depth 5.0 feet below original grade. Effective area begins at 3.5 feet below original grade. 2.0 feet of stone below distribution pipe.

===== PUMPED SYSTEM PROPOSED: YES NO

PUMPED SEPTIC SYSTEM DETAIL: _____ gallon pump chamber.
YES NO Top seamed pump chamber required?

Note 1: Septic pump detail to be provided by installer prior to issuance of septic permit.

Note 2: Pump performance test is necessary prior to Health Department approval of pumped septic system.

===== LOCATION: _____

ADDITIONAL NOTES: _____

Reviewer: _____ Date: _____

Real Property Data Search (w1)

Search Result for HOWARD COUNTY

View Map		View GroundRent Redemption			View GroundRent Registration				
Tax Exempt:		Special Tax Recapture:							
Exempt Class:		NONE							
Account Identifier:		District - 03 Account Number - 303713							
Owner Information									
Owner Name:		PUNTE BRUCE L PUNTE ANDREA STEPHANIE			Use:		RESIDENTIAL		
Mailing Address:		1675A HENRYTON RD MARRIOTTSVILLE MD 21104-1417			Principal Residence:		YES		
					Deed Reference:		/16113/ 00149		
Location & Structure Information									
Premises Address:		1675A HENRYTON RD MARRIOTTSVILLE 21104-0000			Legal Description:		LOT 14 1.386 AR S 2 1675-A HENRYTON RD HENRYTON HEIGHTS		
Map:	Grid:	Parcel:	Sub District:	Subdivision:	Section:	Block:	Lot:	Assessment Year:	Plat No:
0010	0020	0278		0002			14	2019	Plat Ref:
Special Tax Areas:				Town:		NONE			
				Ad Valorem:		101			
				Tax Class:					
Primary Structure Built		Above Grade Living Area		Finished Basement Area		Property Land Area		County Use	
2016		2,820 SF				1.3800 AC			
Stories	Basement	Type	Exterior	Full/Half Bath	Garage	Last Major Renovation			
2	YES	STANDARD UNIT	SIDING	2 full/ 1 half	1 Attached				
Value Information									
		Base Value		Value		Phase-in Assessments			
				As of		As of		As of	
				01/01/2019		07/01/2018		07/01/2019	
Land:		160,000		208,800					
Improvements		502,100		419,500					
Total:		662,100		628,300		662,100		628,300	
Preferential Land:		0						0	
Transfer Information									
Seller: PUNTE BRUCE L				Date: 04/06/2015		Price: \$0			
Type: NON-ARMS LENGTH OTHER				Deed1: /16113/ 00149		Deed2:			
Seller: RAMSBURG ELIZABETH TURNER				Date: 03/01/2006		Price: \$120,000			
Type: NON-ARMS LENGTH OTHER				Deed1: /09849/ 00627		Deed2:			
Seller: RAMSBURG EVERETT L & WF				Date: 04/23/1999		Price: \$0			
Type: NON-ARMS LENGTH OTHER				Deed1: /04711/ 00401		Deed2:			
Exemption Information									
Partial Exempt Assessments:		Class			07/01/2018		07/01/2019		
County:		000			0.00				
State:		000			0.00				
Municipal:		000			0.00 0.00		0.00 0.00		
Tax Exempt:		Special Tax Recapture:							
Exempt Class:		NONE							