

Preliminary

APPLICATION

465-1633

A 10446
P _____

SEWAGE DISPOSAL TESTING

MARYLAND STATE DEPARTMENT OF HEALTH

HOWARD COUNTY

ELLICOTT CITY

3 bedrooms - 1000 gal. septic tank.

DISTRICT 6

DATE 6/30/65

Tile field with 360 sq. ft. of bottom area located in area 10 ft. to 50 ft. from the right side property line and 25 ft. to 95 ft. from the rear property line as seen when facing the lot from Gracelock road. Maint. at a depth of 5 1/2 feet on all tile trenches.

TO: THE COUNTY HEALTH OFFICER
ELLICOTT CITY, MARYLAND

4 bedroom - 1250 gal septic tank, Tile field with 480 sq. ft. of bottom area with location and other specifications the same as for 3 bedrooms. 12 in. stone under pipe

I, HEREBY, APPLY FOR THE NECESSARY TESTS IN ORDER TO CONSTRUCT (OR RECONSTRUCT) A SEWAGE DISPOSAL SYSTEM.

PROPERTY OWNER Martellini & Brown

Hold need septic tank result tile result ok. J.H. - on system 1st. must see operation before anything installed in system

ADDRESS RFD #1 - Montgomery Rd., E. C.

PHONE PA 5-8888

PROPERTY LOCATION:

SUBDIVISION Wallington Estates

LOT NO. 1, Blk. E

ROAD AND DESCRIPTION Gracelock Rd. & Marston Rd.

OCCUPANT _____ PHONE _____

PERSON TO CONSTRUCT SYSTEM THE SYSTEM UNDER THIS PERMIT IS ACCEPTABLE ONLY UNTIL PUBLIC FACILITIES BECOME AVAILABLE.

ADDRESS _____ PHONE _____

SIZE OF LOT 11,000 sq. ft. TYPE BLDG. 1 or 2
NUMBER OF BEDROOMS

IF NOT SINGLE RESIDENCE DESCRIBE _____

SIGNATURE OF APPLICANT J. Joseph Martellini


APPROVED BY J. Hennigan FOR Tile field DATE May 5, 1967
(KIND OF SYSTEM)

REJECTED BY _____ FOR _____ DATE _____

HOLD PENDING FURTHER TESTS _____ DATE _____

REASONS FOR REJECTION OR HOLDING 7-30-65. Lot prev's sat inspect only for tile field. But need profile on ground, house and septic system showing elevation. System cannot be deeper than 4 ft. from original grade. J.H.

THIS IS NOT A PERMIT

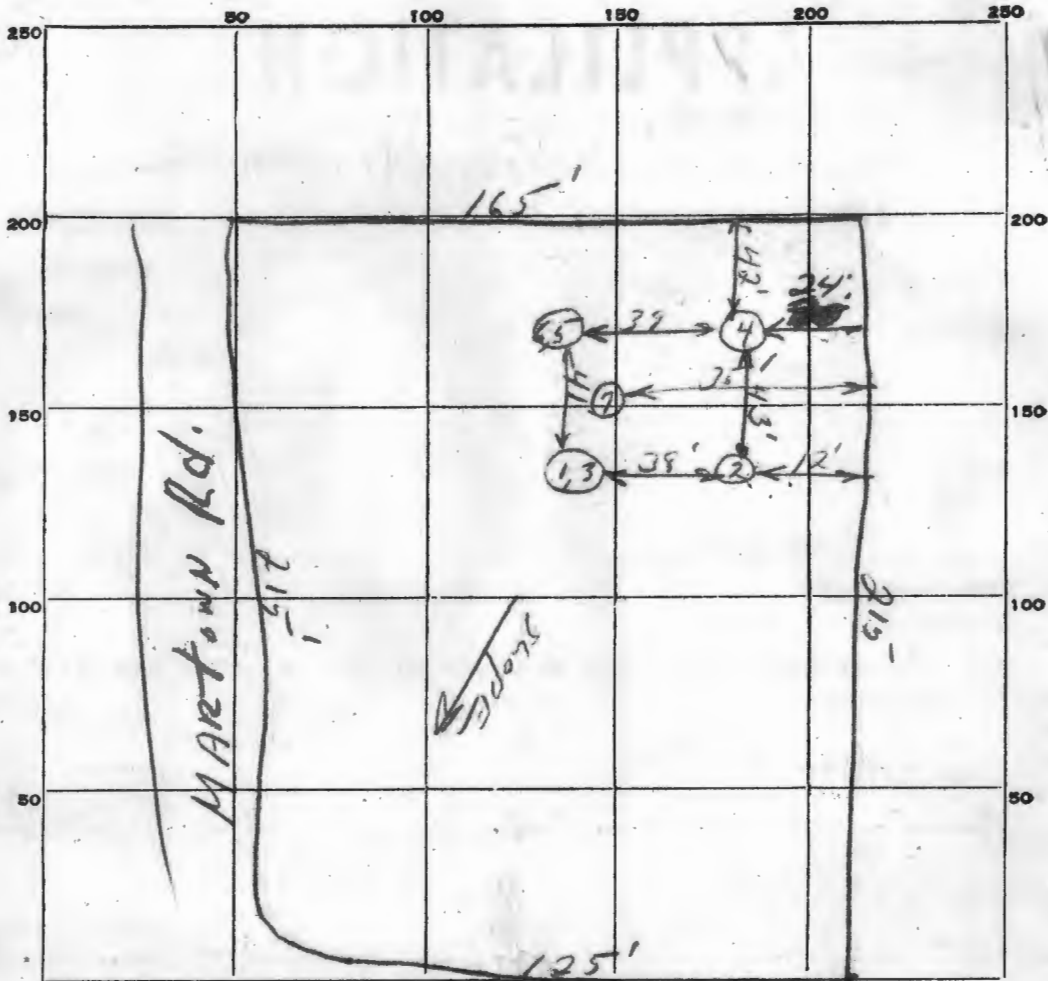

INDICATE NORTH. - NAME ADJOINING ROADWAY AS BASE LINE.

GRAE Loch Road.

DATE	TEST NO.	DEPTH	PRE-WET		TEST - 1" DROP		TIME
			START	STOP	START	STOP	
7-30-65	1	4'	10:43	11:08	11:08	11:37	29 min
	2	4'	10:44	10:44	10:44	10:45	11 min
	3	8'	10:45	11:10	11:10	11:40	30 min
	4	4'	10:52	10:54	10:54	10:57	3 min
	5	4'	10:53	10:58	10:58	11:08	10 min
	6	9 1/2'	10:57	slow			include all
	7	8'	11:24	11:28	11:28	11:35	7 min

arg-13

arg-17

arg-15

sw. spec.
Time 13 min

SOIL AUGER FINDING: about 7 FT. of fill to be placed on front of lot in front of house

TESTED BY: J.H. + J.K.

REMARKS: Field should be 4 FT. deep from original grade

7-30-65 Joseph Martini

Well moved to center in front of house
away from common lot line of lot 1 & 2

Lot must be retested or system installed
before building permit can be released,
system first means excavation inspected
before anything installed in excavation

Drainfield system to be type of system used
180 sq. ft. per. bedroom

maximum depth ~~to~~ $5\frac{1}{2}$ ft., bottom of
trenches to (over) be $5\frac{1}{2}$ ft below original
grade with 1 ft gravel under pipe
visual hole ~~96~~ $\pm 3\frac{1}{2}$ - 4' perc.

location:

1st trench to run parallel ^{more or less} with
right side line approx. 15 ft. from
st. ^{side line} and in area ^{between} 25 ft to 100 ft
from rear line and ~~15 ft~~ in area
between 15 ft. and 50 ft. from
right side.

2nd trench to run parallel to 1st.



3rd also if needed.

Real Property Data Search (w3)

Search Result for HOWARD COUNTY

View Map		View GroundRent Redemption			View GroundRent Registration				
Tax Exempt:		Special Tax Recapture:							
Exempt Class:		NONE							
Account Identifier:		District - 06 Account Number - 407633							
Owner Information									
Owner Name:		SWING DONALD EDWARD SWING MICHELE FJM			Use:		RESIDENTIAL		
Mailing Address:		10503 GRAELOCH RD LAUREL MD 20723-1118			Principal Residence:		YES		
					Deed Reference:		/03318/ 00052		
Location & Structure Information									
Premises Address:		10503 SW GRAELOCH RD LAUREL 20723-0000			Legal Description:		LOT 1 BL E S 3 10503 GRAELOCH RD WELLINGTON ESTS		
Map:	Grid:	Parcel:	Sub District:	Subdivision:	Section:	Block:	Lot:	Assessment Year:	Plat No:
0046	0006	0283		0000			1	2017	Plat Ref:
Special Tax Areas:					Town:		NONE		
					Ad Valorem:		104		
					Tax Class:				
Primary Structure Built		Above Grade Living Area		Finished Basement Area		Property Land Area		County Use	
1976		3,734 SF		1000 SF		31,145 SF			
Stories	Basement	Type		Exterior	Full/Half Bath	Garage	Last Major Renovation		
2	YES	STANDARD UNIT		FRAME	3 full/ 4 half	1 Attached			
Value Information									
		Base Value		Value		Phase-in Assessments			
				As of		As of		As of	
				01/01/2017		07/01/2018		07/01/2019	
Land:		175,400		157,000					
Improvements		384,600		388,500					
Total:		560,000		545,500		545,500		545,500	
Preferential Land:		0						0	
Transfer Information									
Seller: SCOVILLE JOSEPH H & WIFE				Date: 08/10/1994			Price: \$224,900		
Type: ARMS LENGTH IMPROVED				Deed1: /03318/ 00052			Deed2:		
Seller:				Date:			Price:		
Type:				Deed1:			Deed2:		
Seller:				Date:			Price:		
Type:				Deed1:			Deed2:		
Exemption Information									
Partial Exempt Assessments:		Class		07/01/2018		07/01/2019			
County:		000		0.00					
State:		000		0.00					
Municipal:		000		0.00 0.00		0.00 0.00			
Tax Exempt:		Special Tax Recapture:							
Exempt Class:		NONE							


LOT PROFILE FOR SEWAGE SYSTEM
 LOT 1, BLOCK "E"
 "WELLINGTON ESTATES"

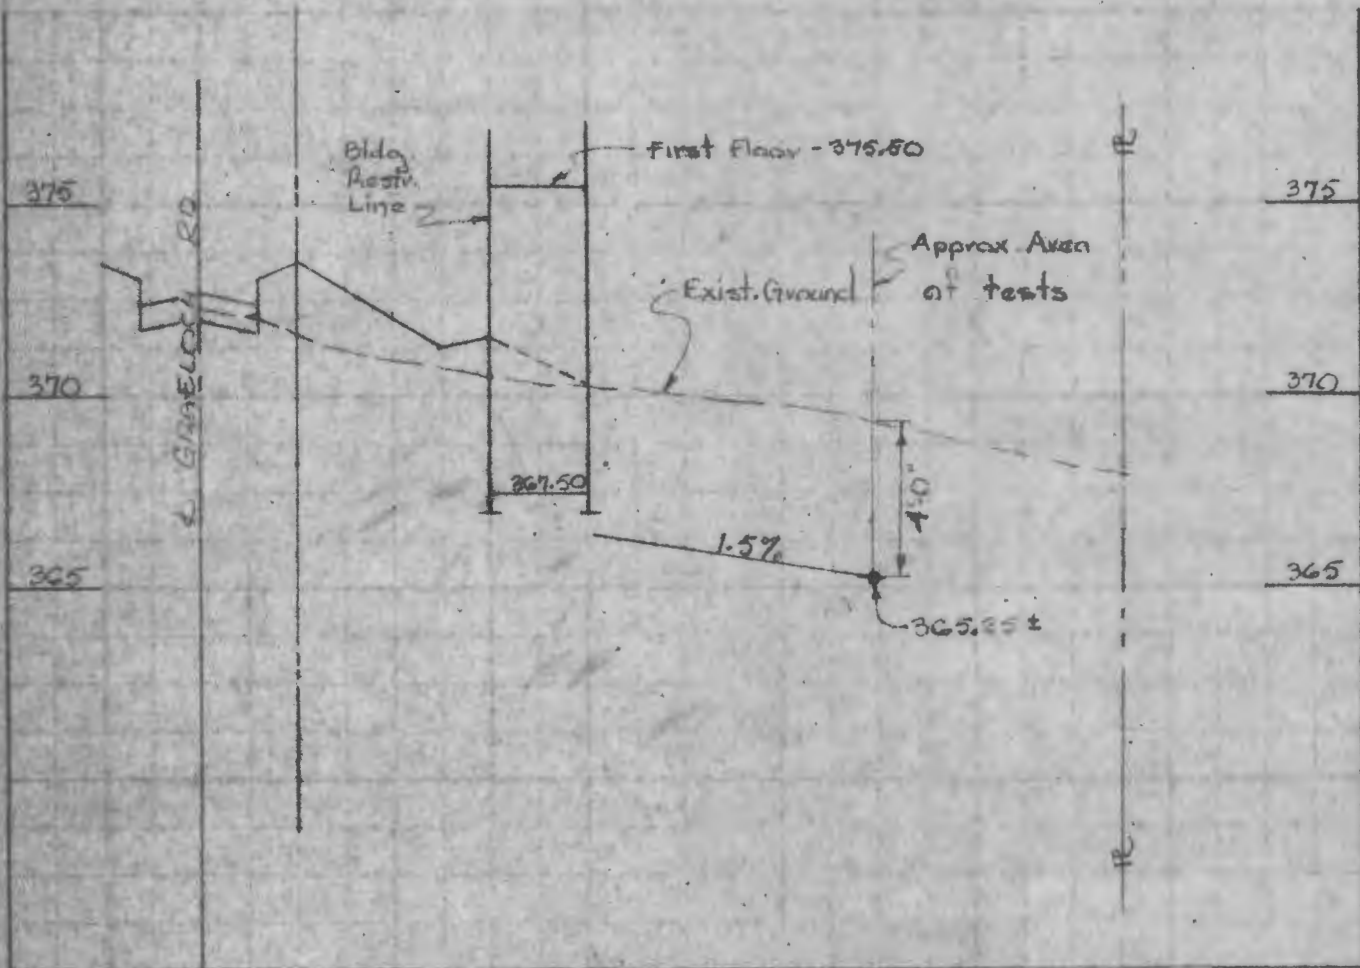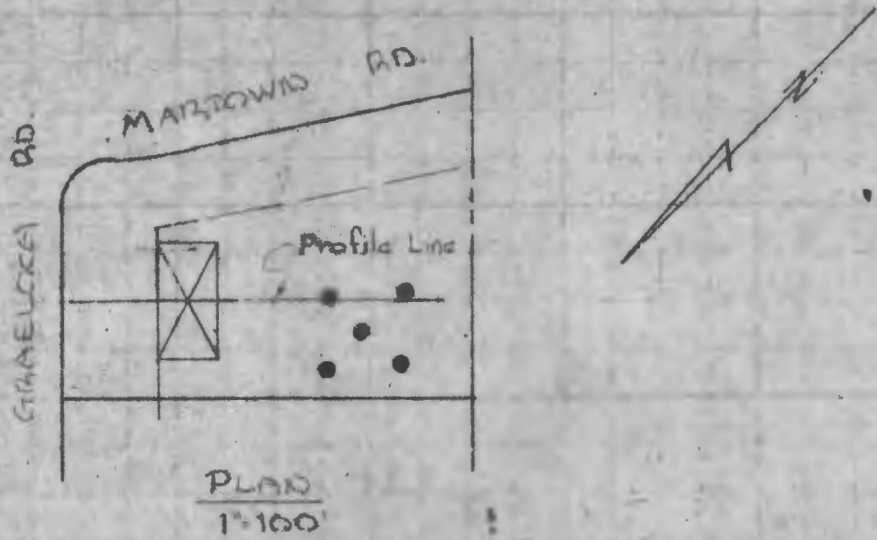

PURDOM & JESCHKE
 24 PARK AVE
 ELLICOTT CITY, MD.

PROFILE
 HOR: 1"=50'
 VERT: 1"=5'-0"

PRELIMINARY HOUSE LAYOUT
LOT 1-E

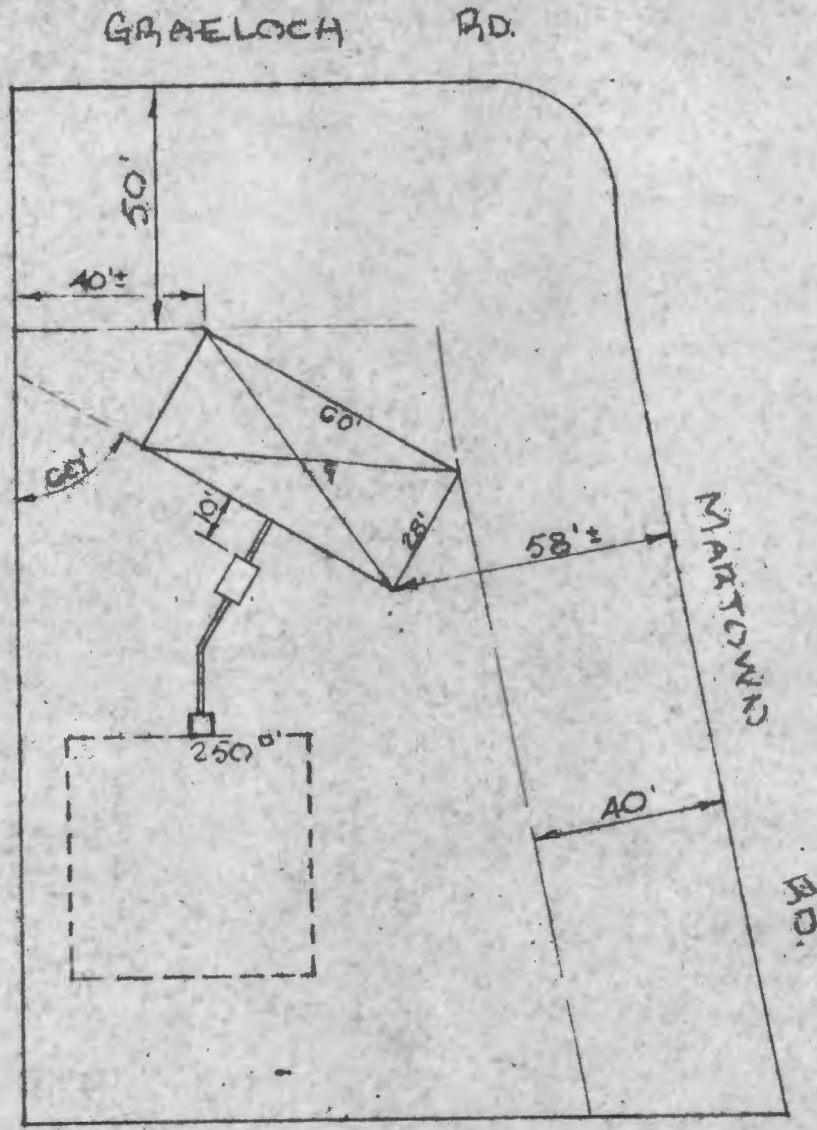

SCALE: 1"=40'


3 SEPT. 65

PURDUM & JESCHKE

ENGINEERS

1000 W. 10th St.
Burlington, Iowa

#17200 Wellington Homes 5/1/73

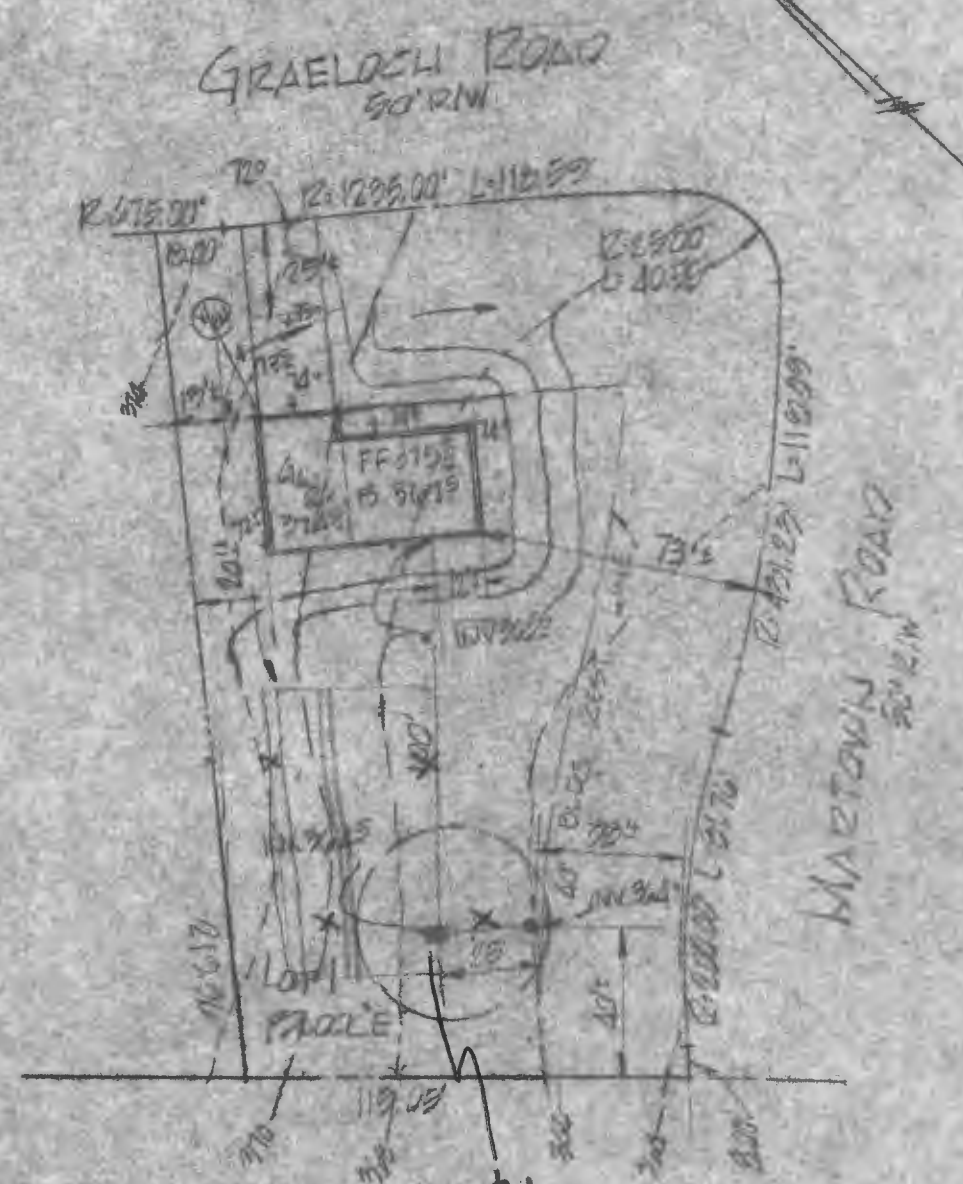

I CERTIFY THE ABOVE MEASUREMENTS & ELEVATIONS ARE ACTUAL & CORRECT FOR THIS PROPERTY.

John B. Bay
5/1/72

grade
56.7.5

GARY AND ASSOC.
5391 CARRIAGE CT.
BALTIMORE MD 21229

GRADING PLAN
LOT 1 BLOCK "E"
SECTION 3
WELLINGTON ESTATES
SHELDON DIST. HO. COMD
1"=50'
3-16-72