

# APPLICATION

SEWAGE DISPOSAL TESTING

STATE OF MARYLAND - DEPARTMENT OF HEALTH AND MENTAL HYGIENE

HOWARD COUNTY HEALTH DEPARTMENT  
ENVIRONMENTAL HEALTH SERVICES

P. O. BOX 476 ELLICOTT CITY, MARYLAND 21043  
TELEPHONE: 992-2330

A 35691

P \_\_\_\_\_

DISTRICT 3

DATE 6/20/85

TO: THE COUNTY HEALTH OFFICER  
ELLICOTT CITY, MARYLAND

I, HEREBY, APPLY FOR THE NECESSARY TEST IN ORDER TO CONSTRUCT (OR RECONSTRUCT) A SEWAGE DISPOSAL SYSTEM.

owner: Phillip Dorsch  
Purchaser: Patrick Mc Cuan  
PROPERTY OWNER

ADDRESS 1000 Equitable Bank Dr. Columbia, MD 21044 PHONE 730-9091

PROPERTY LOCATION:

SUBDIVISION Gaither Farm LOT NO. 76 NEW 15

ROAD AND DESCRIPTION Homewood Rdr and Rte. 108

SIZE OF LOT 3 acres TYPE BLDG. 3-5  
(NUMBER OF BEDROOMS)

THE SYSTEM INSTALLED UNDER THIS APPLICATION IS ACCEPTABLE ONLY UNTIL PUBLIC FACILITIES BECOME AVAILABLE. I FULLY UNDERSTAND THE FEE CONNECTED WITH THE FILING OF THIS PERC TEST APPLICATION IS NON-REFUNDABLE UNDER ANY CIRCUMSTANCES. I ALSO AGREE TO COMPLY WITH ALL M.O.S.H.A. REQUIREMENTS IN TESTING THIS LOT.

Christine Richards  
(SIGNATURE OF APPLICANT)

APPROVED BY \_\_\_\_\_ FOR \_\_\_\_\_ DATE \_\_\_\_\_

REJECTED BY \_\_\_\_\_ FOR \_\_\_\_\_ DATE \_\_\_\_\_

HOLD PENDING FURTHER TESTS \_\_\_\_\_ DATE \_\_\_\_\_

REASONS FOR REJECTION OR HOLDING 6/26/85 - Dig more slow perc & water  
7-16-85 Perc Satisfactory - Hold for certified Subdivision Plat sale

# THIS IS NOT A PERMIT

SOIL PROFILE

0


INDICATE NORTH - NAME ADJOINING ROADWAY AS BASE LINE.

DATE	TEST NO.	DEPTH	PRE-WET		TEST - 1" DROP		TIME
			START	STOP	START	STOP	
7/16/85	6 S (12)	4 8	1:05 1:05	1:08 1:09	1:08 1:09	1:13 1:15	5 min 6 min
	7 S (13)	5 9	1:12 1:12	1:13 1:13	1:13 1:13	1:20 1:19	7 min 6 min
	8 S (13)	5 9	1:15 1:16	1:17 1:17	1:17 1:17	1:19 1:19	2 min 2 min

Her  
 6203  
 av time  
 7 min  
 6 min  
 2 min  
 2 min  
 max  
 Depth  
 4.5

REMARKS \_\_\_\_\_

TYPE OF SOIL \_\_\_\_\_

TESTED BY S. Abel ALSO PRESENT same

# APPLICATION

SEWAGE DISPOSAL TESTING

STATE OF MARYLAND - DEPARTMENT OF HEALTH AND MENTAL HYGIENE

A 35691

P \_\_\_\_\_

HOWARD COUNTY HEALTH DEPARTMENT  
ENVIRONMENTAL HEALTH SERVICES

P. O. BOX 476 ELLICOTT CITY, MARYLAND 21043  
TELEPHONE: 992-2330

DISTRICT 3

DATE 4/20/85

TO: THE COUNTY HEALTH OFFICER  
ELLICOTT CITY, MARYLAND

I, HEREBY, APPLY FOR THE NECESSARY TEST IN ORDER TO CONSTRUCT (OR RECONSTRUCT) A SEWAGE DISPOSAL SYSTEM.

*Philip [unclear]*  
*Richard [unclear]*  
PROPERTY OWNER Richard [unclear]  
ADDRESS 100 Equitable Bank Bldg PHONE 730-9091  
Chesapeake, MD 21044

PROPERTY LOCATION:  
SUBDIVISION Gaither Farm LOT NO. 16  
ROAD AND DESCRIPTION Homewood Rd. and Rte. 108  
SIZE OF LOT 3 acres TYPE BLDG. 3-5  
(NUMBER OF BEDROOMS)

THE SYSTEM INSTALLED UNDER THIS APPLICATION IS ACCEPTABLE ONLY UNTIL PUBLIC FACILITIES BECOME AVAILABLE. I FULLY UNDERSTAND THE FEE CONNECTED WITH THE FILING OF THIS PERC TEST APPLICATION IS NON-REFUNDABLE UNDER ANY CIRCUMSTANCES. I ALSO AGREE TO COMPLY WITH ALL M.O.S.H.A. REQUIREMENTS IN TESTING THIS LOT.

Christine Richards  
(SIGNATURE OF APPLICANT)

APPROVED BY \_\_\_\_\_ FOR \_\_\_\_\_ DATE \_\_\_\_\_




REJECTED BY \_\_\_\_\_ FOR \_\_\_\_\_ DATE \_\_\_\_\_

HOLD PENDING FURTHER TESTS \_\_\_\_\_ DATE \_\_\_\_\_

REASONS FOR REJECTION OR HOLDING \_\_\_\_\_

# THIS IS NOT A PERMIT

SEE P

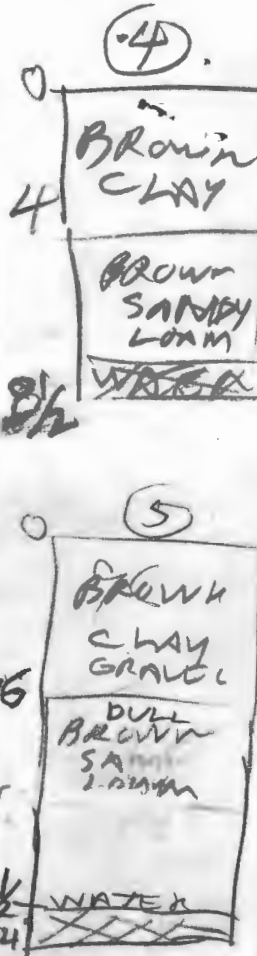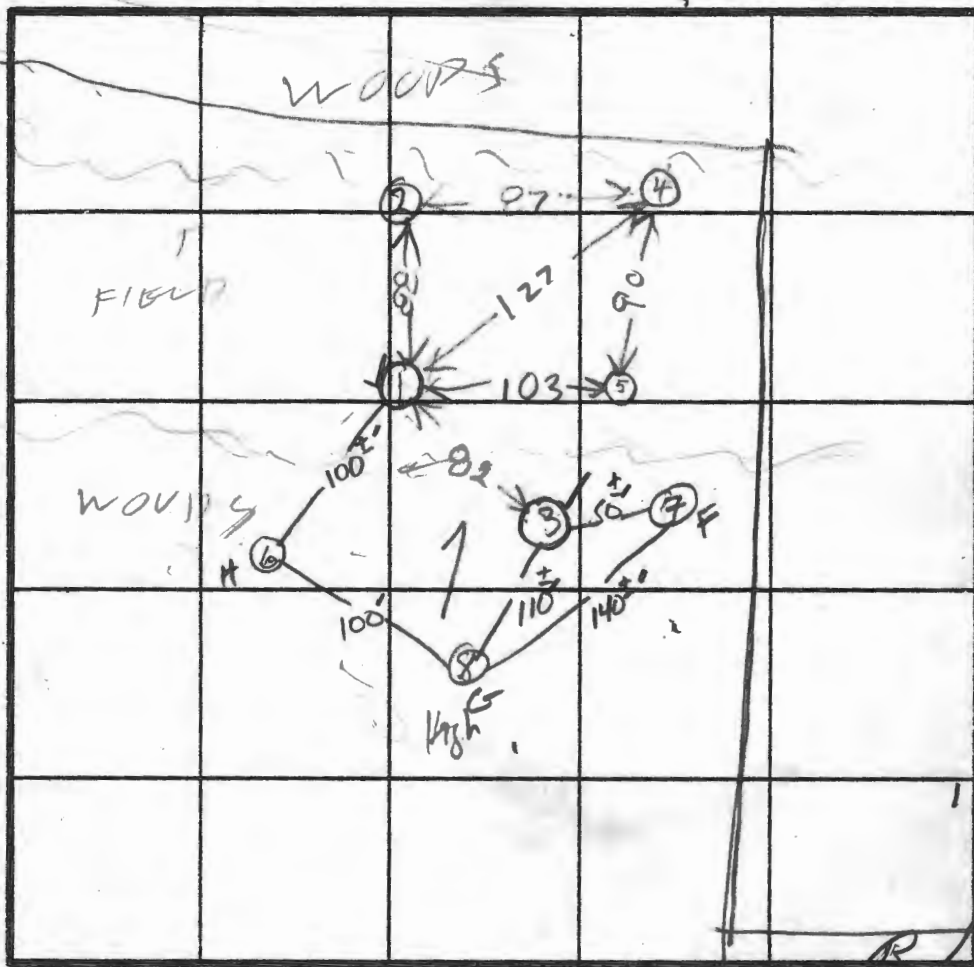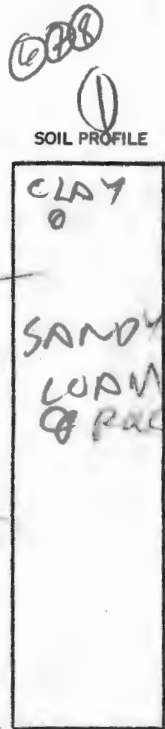

INDICATE NORTH - NAME ADJOINING ROADWAY AS BASE LINE

RH# SURVEYOR


1	D
2	A
3	E
4	B
5	C

DATE	TEST NO.	DEPTH	PRE-WET		TEST - 1" DROP		TIME
			START	STOP	START	STOP	
6/24/85	✓ 1D	9	310	313	313	318	5
	✓ 1S	3 1/2	318	320	320	322	2
	✓ 1V	12	LOOKS OK				
	2V	5	ROCK BOTTOM				
	✓ 3D	9	335	345	345	355	10
	✓ 3S	4	342	413	little per		
	✓ 3V	13 1/2	OK DEEP				
	4V	8 1/2	WATER		8 1/2 FT UNSAT		
	5S	4	426	455	little per		
	5D	9	420	422	422	425	3
6/26/85	✓ 3M	5	112	1136	1136	1203	27
	5M	5 1/2	1121	4150	little per		

HOLE ELEVATION

(4) LOWEST

(2) NEXT LOWEST

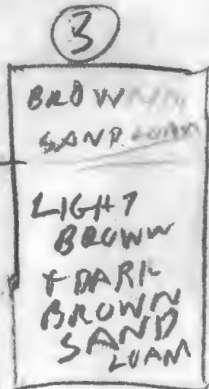

HOLE 3 (2)(4)(5) DIG PER SURVEYOR PLAN

REMARKS (3) = EXTRA HOLE NOT PER SURVEYOR PLAN

TYPE OF SOIL

TESTED BY RHODGES

ALSO PRESENT

MCCLEN  
J. PAPERH  
C. RICHARIS  
J. MADEN

PROPERTY OF  
JINA R. CARROLL  
1104/535

MARYLAND STATE  
GRID MERIDIAN

101

OF

E 828000

N 513000

PROPERTY OF

N 89° 11' 03" E

410.00'

479.12'

LOT 15

4.2463 AC.

LOT 16

3.3041 AC.

LOT 13

4.0346 AC.

LOT 14

4.3810 AC.

257

261

258

260

263

20' DRAINAGE & UTILITY  
EASEMENT

N 15° 05' 14" W  
352.00'

N 49° 36' 07" W  
203.42'

824.62'

S 15° 05' 14" E  
393.55'

610.00'

N 74° 54' 46" E

N 74° 54' 46" E

N 15° 05' 14" W

S 00° 48' 57" E  
250.00'

301.53'

301.53'

R=60.00'

L=89.41'

L=23.55'

L=23.55'

L=95.57'

75'

75'

75'

75'

30'

30'






30'

30'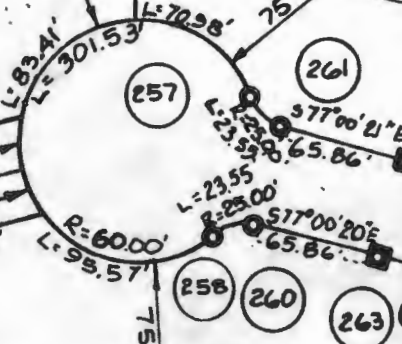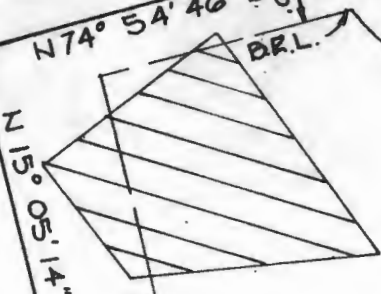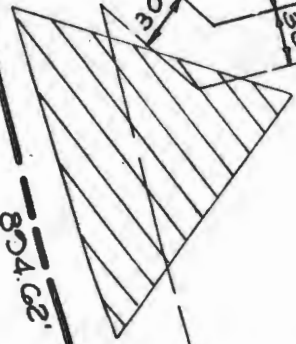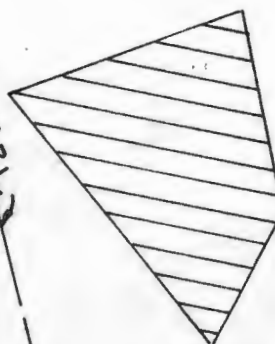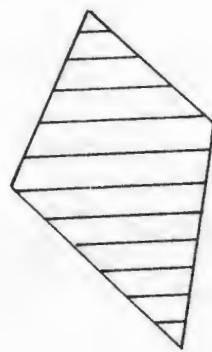

owner

prepared by

LOT NUMBER

307

Absorbant Area/bedroom

SEPTIC TANK

1000 gal

1250 gal

1500 gal

3 bdrms

4 bdrms

5 bdrms

DRY WELL

inlet

Max. depth

Abs. Area

Located

TRENCH

Inlet

Max. depth

# bedrooms

Length

Abs. Area

If dry well and trench are used leave a 5' earth buffer between them.

If septic tank is 3' or more below grade, use manhole type cleanout to grade.

If more than one trench is used space them parallel, twice their depth apart.

Call office for inspection of trench before placing stone in trench.

All pipe from house to disposal area cast iron.

Install standpipe (6" min.) on septic tank and dry well. Cast iron, concrete, terra

cotta ok. Trench distribution lines may be clay, asbestos cement, orangburg type,

open joint cast iron or heavy duty plastic. (Commercial standard Cs228-61).

# APPLICATION

A 26048

P \_\_\_\_\_

## SEWAGE DISPOSAL TESTING

STATE OF MARYLAND - DEPARTMENT OF HEALTH AND MENTAL HYGIENE

HOWARD COUNTY HEALTH DEPARTMENT  
ENVIRONMENTAL HEALTH SERVICES

DISTRICT 3rd

DATE 6/7/77

S.T. : 3BR - 1000 gal, 4BR - 1250 gal

DW & Trench

The system will contain no less than 125 # of absorbent sidewall area per bedroom. Locate the DW. \_\_\_\_\_ ft from

and \_\_\_\_\_ ft from below O.G. and the max depth of the D.W. will not exceed 10 ft below O.G. The inv. will enter the DW @ 3 ft.

Begin the trench 5 ft from the edge of the DW. and follow the contour of the land. The trench will be 2 ft wide, 10 ft deep, and contain 2 ft of stone.

2 Inspections

### DISPOSAL SYSTEM.

PROPERTY OWNER William B. Ridgely

ADDRESS Spring Meadow Farm Cooksville, Md. 21728 PHONE Carol Clark

531-5115

### PROPERTY LOCATION:

SUBDIVISION Ridgely Property (Friendship Manor) LOT NO. 25-30

ROAD AND DESCRIPTION Rte. 144 - Rte. 32

SIZE OF LOT ? TYPE BLDG. 3 or 4 bedroom  
NUMBER OF BEDROOMS

IF NOT SINGLE RESIDENCE DESCRIBE \_\_\_\_\_

THE SYSTEM INSTALLED UNDER THIS APPLICATION IS ACCEPTABLE ONLY UNTIL PUBLIC FACILITIES BECOME AVAILABLE.

SIGNATURE OF APPLICANT /s/ Albert Scheel

APPROVED BY \_\_\_\_\_ FOR \_\_\_\_\_ DATE \_\_\_\_\_  
(KIND OF SYSTEM)


REJECTED BY \_\_\_\_\_ FOR \_\_\_\_\_ DATE \_\_\_\_\_  
(KIND OF SYSTEM)

HOLD PENDING FURTHER TESTS \_\_\_\_\_ DATE \_\_\_\_\_

REASONS FOR REJECTION OR HOLDING \_\_\_\_\_

# THIS IS NOT A PERMIT

← R+32 →

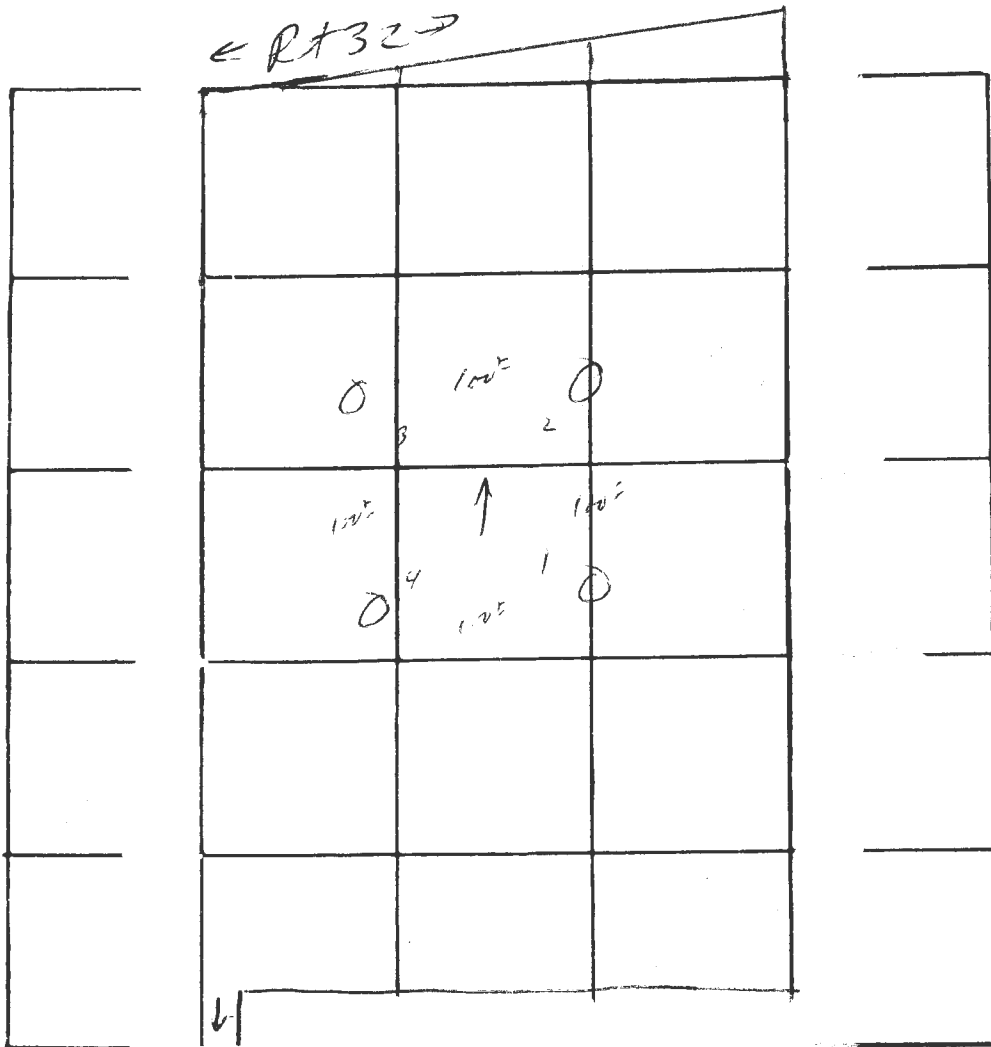

Lot 25

← R<sub>w</sub> →

DATE	TEST NO.	DEPTH	PRE-WET		TEST - 1" DROP		TIME
			START	STOP	START	STOP	
6 July 77	1	2	2 <sup>01</sup>	2 <sup>04</sup>	2 <sup>04</sup>	2 <sup>09</sup>	5
		13	2 <sup>05</sup>	2 <sup>06</sup>	2 <sup>06</sup>	2 <sup>13</sup>	7
	2	2	2 <sup>02</sup>	2 <sup>05</sup>	2 <sup>05</sup>	2 <sup>11</sup>	6
		13	↓	2 <sup>07</sup>	2 <sup>07</sup>	2 <sup>16</sup>	9
	3	2		2 <sup>03</sup>	2 <sup>03</sup>	2 <sup>07</sup>	4
		13	↓	2 <sup>06</sup>	2 <sup>06</sup>	2 <sup>14</sup>	8
	4	12	5' S				

REMARKS \_\_\_\_\_

TYPE OF SOIL sandy loam

TESTED BY M ALSO PRESENT: Schub



Real Property Data Search ( w1)

Search Result for HOWARD COUNTY

View Map		View GroundRent Redemption				View GroundRent Registration				
<b>Tax Exempt:</b>		<b>Special Tax Recapture:</b>								
<b>Exempt Class:</b>		NONE								
<b>Account Identifier:</b>		<b>District - 03 Account Number - 310876</b>								
Owner Information										
<b>Owner Name:</b>	PARRAN JOEL L PARRAN JAY N				<b>Use:</b>	RESIDENTIAL				
<b>Mailing Address:</b>	5617 SUFFIELD CT COLUMBIA MD 21044-2775				<b>Principal Residence:</b>	NO				
					<b>Deed Reference:</b>	/01467/ 00445				
Location & Structure Information										
<b>Premises Address:</b>		GAITHER FARM RD ELLCOTT CITY 21042-0000				<b>Legal Description:</b>	LOT 15 4.2463 A GAITHER FARM RD GAITHER FARM			
<b>Map:</b>	<b>Grid:</b>	<b>Parcel:</b>	<b>Sub District:</b>	<b>Subdivision:</b>	<b>Section:</b>	<b>Block:</b>	<b>Lot:</b>	<b>Assessment Year:</b>	<b>Plat No:</b>	6611
0029	0010	0001		2004			15	2019	<b>Plat Ref:</b>	
<b>Special Tax Areas:</b>					<b>Town:</b>		NONE			
					<b>Ad Valorem:</b>		100			
					<b>Tax Class:</b>					
<b>Primary Structure Built</b>	<b>Above Grade Living Area</b>			<b>Finished Basement Area</b>		<b>Property Land Area</b>		<b>County Use</b>		
						4.2400 AC				
<b>Stories</b>	<b>Basement</b>	<b>Type</b>	<b>Exterior</b>	<b>Full/Half Bath</b>	<b>Garage</b>	<b>Last Major Renovation</b>				
Value Information										
			<b>Base Value</b>	<b>Value</b>	<b>Phase-in Assessments</b>					
				As of	As of		As of			
				01/01/2019	07/01/2018		07/01/2019			
<b>Land:</b>			305,300	244,300						
<b>Improvements</b>			0	0						
<b>Total:</b>			305,300	244,300	305,300		244,300			
<b>Preferential Land:</b>			0		0					
Transfer Information										
<b>Seller:</b> MCCUAN PATRICK				<b>Date:</b> 05/06/1986			<b>Price:</b> \$132,500			
<b>Type:</b> ARMS LENGTH IMPROVED				<b>Deed1:</b> /01467/ 00445			<b>Deed2:</b>			
<b>Seller:</b>				<b>Date:</b>			<b>Price:</b>			
<b>Type:</b>				<b>Deed1:</b>			<b>Deed2:</b>			
<b>Seller:</b>				<b>Date:</b>			<b>Price:</b>			
<b>Type:</b>				<b>Deed1:</b>			<b>Deed2:</b>			
Exemption Information										
<b>Partial Exempt Assessments:</b>		<b>Class</b>	07/01/2018				07/01/2019			
<b>County:</b>		000	0.00							
<b>State:</b>		000	0.00							
<b>Municipal:</b>		000	0.00 0.00				0.00 0.00			
<b>Tax Exempt:</b>		<b>Special Tax Recapture:</b>								
<b>Exempt Class:</b>		NONE								
Homestead Application Information										
<b>Homestead Application Status:</b> No Application										

SEPTIC SPECIFICATIONS WORK-SHEET

SUBDIVISION: Gaither Farm

A 35691

STREET NAME: \_\_\_\_\_

LOT NUMBER: 15

AVERAGE PERCOLATION RATE: \_\_\_\_\_

SQUARE FEET PER BEDROOM: 210

NUMBER OF BEDROOMS: \_\_\_\_\_

LINEAR FEET OF TRENCH PER BEDROOM: \_\_\_\_\_

TOTAL LINEAR FEET OF TRENCH: \_\_\_\_\_

SEPTIC TANK CAPACITY: \_\_\_\_\_

TOP SEAMED TANK REQUIRED? YES NO

COMPARTMENTED TANK REQUIRED? YES NO

TRENCH DIMENSIONS: Trench to be 3.0 feet wide. Inlet 2.5 feet below original grade. Bottom maximum depth 4.5 feet below original grade. Effective area begins at 3.0 feet below original grade. 2.0 feet of stone below distribution pipe.

=====
PUMPED SYSTEM PROPOSED: YES NO

PUMPED SEPTIC SYSTEM DETAIL: \_\_\_\_\_ gallon pump chamber.

YES NO Top seamed pump chamber required?

Note 1: Septic pump detail to be provided by installer prior to issuance of septic permit.

Note 2: Pump performance test is necessary prior to Health Department approval of pumped septic system.

=====

LOCATION: \_\_\_\_\_
\_\_\_\_\_
\_\_\_\_\_
\_\_\_\_\_

ADDITIONAL NOTES: \_\_\_\_\_
\_\_\_\_\_
\_\_\_\_\_
\_\_\_\_\_

Reviewer: \_\_\_\_\_

Date: \_\_\_\_\_