

# APPLICATION

A 22152

## SEWAGE DISPOSAL TESTING

P. \_\_\_\_\_

STATE OF MARYLAND - DEPARTMENT OF HEALTH AND MENTAL HYGIENE

HOWARD COUNTY HEALTH DEPARTMENT  
ENVIRONMENTAL HEALTH SERVICES  
P. O. BOX 476, ELLICOTT CITY, MARYLAND 21043  
TELEPHONE: 465-5000, EXT. 356

DISTRICT 2DATE 9/22/75

TO: THE COUNTY HEALTH OFFICER  
ELLICOTT CITY, MARYLAND

I, HEREBY, APPLY FOR THE NECESSARY TEST IN ORDER TO CONSTRUCT (OR RECONSTRUCT) A SEWAGE DISPOSAL SYSTEM.

PROPERTY OWNER Howard International, Inc.ADDRESS 4609 Edmondson Avenue, Baltimore, Md. 21229 PHONE \_\_\_\_\_

PROPERTY LOCATION:

SUBDIVISION North Farm LOT NO. 4, Sec. 3ROAD AND DESCRIPTION North Farm RoadSIZE OF LOT approx. 1 acre TYPE BLDG. 3 or 4IF NOT SINGLE RESIDENCE DESCRIBE \_\_\_\_\_  
NUMBER OF BEDROOMS  
(Single Fmly. Dwlg.)

THE SYSTEM INSTALLED UNDER THIS APPLICATION IS ACCEPTABLE ONLY UNTIL PUBLIC FACILITIES BECOME AVAILABLE.

SIGNATURE OF APPLICANT /s/ John SchneiderAPPROVED BY \_\_\_\_\_ FOR \_\_\_\_\_ DATE \_\_\_\_\_  
(KIND OF SYSTEM)REJECTED BY \_\_\_\_\_ FOR \_\_\_\_\_ DATE \_\_\_\_\_  
(KIND OF SYSTEM)

HOLD PENDING FURTHER TESTS \_\_\_\_\_ DATE \_\_\_\_\_

REASONS FOR REJECTION OR HOLDING \_\_\_\_\_

# THIS IS NOT A PERMIT


INDICATE NORTH. - NAME ADJOINING ROADWAY AS BASE LINE.

DATE	TEST NO.	DEPTH	PRE-WET		TEST - 1" DROP		TIME
			START	STOP	START	STOP	

REMARKS \_\_\_\_\_

TYPE OF SOIL \_\_\_\_\_

TESTED BY \_\_\_\_\_ ALSO PRESENT: \_\_\_\_\_

April 8, 1983

Mr. Robert Barnhardt  
c/o Re/Max  
9200 Baltimore National Pike  
Ellicott City, Maryland 21043

RE: E. Sherman Owens property  
Parcel 2, North Farm

Dear Mr. Barnhardt:

This is to advise that the above referenced property was approved for a private sewage disposal system on December 16, 1975, and is considered a buildable lot.

Very truly yours,



Frank A. Skinner, Director  
Water and Sewerage Program

FAS:hs

4-13' holes  
at 10,000 ft.

# APPLICATION

A 22152

*Preliminary*

## SEWAGE DISPOSAL TESTING

P \_\_\_\_\_

STATE OF MARYLAND - DEPARTMENT OF HEALTH AND MENTAL HYGIENE

HOWARD COUNTY HEALTH DEPARTMENT  
ENVIRONMENTAL HEALTH SERVICES

DISTRICT 2

P. O. BOX 476, ELLICOTT CITY, MARYLAND 21043  
TELEPHONE: 465-5000, EXT. 356

DATE 9/22/75

TO: THE COUNTY HEALTH OFFICER  
ELLICOTT CITY, MARYLAND

I, HEREBY, APPLY FOR THE NECESSARY TEST IN ORDER TO CONSTRUCT (OR RECONSTRUCT) A SEWAGE DISPOSAL SYSTEM.

PROPERTY OWNER Howard International, Inc.

ADDRESS 4609 Edmondson Avenue, Baltimore, Md. 21229 PHONE \_\_\_\_\_

PROPERTY LOCATION:

SUBDIVISION North Farm LOT NO. 4, Sec. 3

ROAD AND DESCRIPTION North Farm Road

SIZE OF LOT approx. 1 acre TYPE BLDG. 3 or 4

IF NOT SINGLE RESIDENCE DESCRIBE \_\_\_\_\_  
NUMBER OF BEDROOMS  
(Single Fmly. Dwllg.)

THE SYSTEM INSTALLED UNDER THIS APPLICATION IS ACCEPTABLE ONLY UNTIL PUBLIC FACILITIES BECOME AVAILABLE.

SIGNATURE OF APPLICANT /s/ John Schneider

APPROVED BY \_\_\_\_\_ FOR \_\_\_\_\_ DATE \_\_\_\_\_  
(KIND OF SYSTEM)

REJECTED BY \_\_\_\_\_ FOR \_\_\_\_\_ DATE \_\_\_\_\_  
(KIND OF SYSTEM)

HOLD PENDING FURTHER TESTS \_\_\_\_\_ DATE \_\_\_\_\_

REASONS FOR REJECTION OR HOLDING \_\_\_\_\_

# THIS IS NOT A PERMIT


INDICATE NORTH. - NAME ADJOINING ROADWAY AS BASE LINE.

DATE	TEST NO.	DEPTH	PRE-WET		TEST - 1" DROP		TIME
			START	STOP	START	STOP	

REMARKS \_\_\_\_\_

TYPE OF SOIL \_\_\_\_\_

TESTED BY \_\_\_\_\_ ALSO PRESENT: \_\_\_\_\_

4-13' Lotes  
or 10,000 sq. ft.

# APPLICATION

A 22150

*Preliminary*

## SEWAGE DISPOSAL TESTING

P \_\_\_\_\_

STATE OF MARYLAND - DEPARTMENT OF HEALTH AND MENTAL HYGIENE

HOWARD COUNTY HEALTH DEPARTMENT  
ENVIRONMENTAL HEALTH SERVICES  
P. O. BOX 476, ELLICOTT CITY, MARYLAND 21043  
TELEPHONE: 465-5000, EXT. 356

DISTRICT 2

DATE 9/22/75

TO: THE COUNTY HEALTH OFFICER  
ELLICOTT CITY, MARYLAND

I, HEREBY, APPLY FOR THE NECESSARY TEST IN ORDER TO CONSTRUCT (OR RECONSTRUCT) A SEWAGE DISPOSAL SYSTEM.

PROPERTY OWNER Howard International, Inc.

ADDRESS 4609 Edmondson Avenue, Baltimore, Md. PHONE \_\_\_\_\_

PROPERTY LOCATION:

SUBDIVISION North Farm LOT NO. 2, Sec. 3

ROAD AND DESCRIPTION North Farm Road

SIZE OF LOT approx. 1 acre TYPE BLDG. 3 or 4

IF NOT SINGLE RESIDENCE DESCRIBE \_\_\_\_\_  
NUMBER OF BEDROOMS  
(Single Fmly. Dwllg.)

THE SYSTEM INSTALLED UNDER THIS APPLICATION IS ACCEPTABLE ONLY UNTIL PUBLIC FACILITIES BECOME AVAILABLE.

SIGNATURE OF APPLICANT /s/ John Schneider

APPROVED BY \_\_\_\_\_ FOR \_\_\_\_\_ DATE \_\_\_\_\_  
(KIND OF SYSTEM)

REJECTED BY \_\_\_\_\_ FOR \_\_\_\_\_ DATE \_\_\_\_\_  
(KIND OF SYSTEM)

HOLD PENDING FURTHER TESTS \_\_\_\_\_ DATE \_\_\_\_\_

REASONS FOR REJECTION OR HOLDING \_\_\_\_\_

# THIS IS NOT A PERMIT


INDICATE NORTH. - NAME ADJOINING ROADWAY AS BASE LINE.

DATE	TEST NO.	DEPTH	PRE-WET		TEST - 1" DROP		TIME
			START	STOP	START	STOP	

REMARKS \_\_\_\_\_

TYPE OF SOIL \_\_\_\_\_

TESTED BY \_\_\_\_\_ ALSO PRESENT: \_\_\_\_\_

PRELIMINARY

# APPLICATION

A 22161

SEWAGE DISPOSAL TESTING

P. \_\_\_\_\_

STATE OF MARYLAND - DEPARTMENT OF HEALTH AND MENTAL HYGIENE

HOWARD COUNTY HEALTH DEPARTMENT  
ENVIRONMENTAL HEALTH SERVICES

DISTRICT 2nd

P. O. BOX 476, ELLICOTT CITY, MARYLAND 21043  
TELEPHONE: 465-5000, EXT. 356

DATE 9/22/75

TO: THE COUNTY HEALTH OFFICER  
ELLICOTT CITY, MARYLAND

I, HEREBY, APPLY FOR THE NECESSARY TEST IN ORDER TO CONSTRUCT (OR RECONSTRUCT) A SEWAGE DISPOSAL SYSTEM.

PROPERTY OWNER Howard International, Inc.

ADDRESS 4609 Edmondson Avenue, Balto., Md. 21229 PHONE 465-7777

PROPERTY LOCATION:

SUBDIVISION North Farm LOT NO. 12, Sec. 3  
*New Parcel 2  
clotchs 14, 15 and 19*

ROAD AND DESCRIPTION North Farm Road

SIZE OF LOT approx. 1 acre TYPE BLDG. 3 or 4 bedrooms  
NUMBER OF BEDROOMS

IF NOT SINGLE RESIDENCE DESCRIBE \_\_\_\_\_

THE SYSTEM INSTALLED UNDER THIS APPLICATION IS ACCEPTABLE ONLY UNTIL PUBLIC FACILITIES BECOME AVAILABLE.

SIGNATURE OF APPLICANT /s/ John Schneider

✓ APPROVED BY *Dwight O. Hill* FOR *Day Well and Tanks, 3 1/2 - 10'* DATE 12-16-75  
(KIND OF SYSTEM)

REJECTED BY \_\_\_\_\_ FOR \_\_\_\_\_ DATE \_\_\_\_\_  
(KIND OF SYSTEM)

HOLD PENDING FURTHER TESTS \_\_\_\_\_ DATE \_\_\_\_\_

REASONS FOR REJECTION OR HOLDING \_\_\_\_\_

# THIS IS NOT A PERMIT


INDICATE NORTH. - NAME ADJOINING ROADWAY AS BASE LINE.

DATE	TEST NO.	DEPTH	PRE-WET		TEST - 1" DROP		TIME
			START	STOP	START	STOP	

REMARKS \_\_\_\_\_

TYPE OF SOIL \_\_\_\_\_

TESTED BY \_\_\_\_\_ ALSO PRESENT: \_\_\_\_\_

GEORGE HOLMES

~~795 3101~~

North Farm

E. Sherman Owens - Edwards

(owner's Name)

O'Neill 111412e

LOT NUMBER Parcel 2

Absorbant Area/bedroom 135

SEPTIC TANK 1000 gal 1250 gal 1500 gal  
3 bdrms 4 bdrms 5 bdrms

DRY WELL 3 1/2' 8 1/2' 250  
inlet Max. depth Abs. Area


Located 425' From 348' (North) lot line, 110' From 736' (East) lot line.

TRENCH 3 1/2' 8 1/2' # bedrooms Length Abs. Area  
Inlet Max. depth

3 40 160  
4 (2) 30+50 320  
5 (3) 30+40+50 480

Trench (5) to run with contour, across slope 20' below dry well. Approximately South East to North West  
See Back

If dry well and trench are used leave a 5' earth buffer between them.  
If septic tank is 3' or more below grade, use manhole type cleanout to grade.  
If more than one trench is used space them parallel, twice their depth apart.  
Call office for inspection of trench before placing stone in trench.  
All pipe from house to disposal area cast iron.  
Install standpipe (6" min.) on septic tank and dry well. Cast iron, concrete, terra cotta ok. Trench distribution lines may be clay, asbestos cement, orangburg type, open joint cast iron or heavy duty plastic. (Commercial standard Cs228-61).

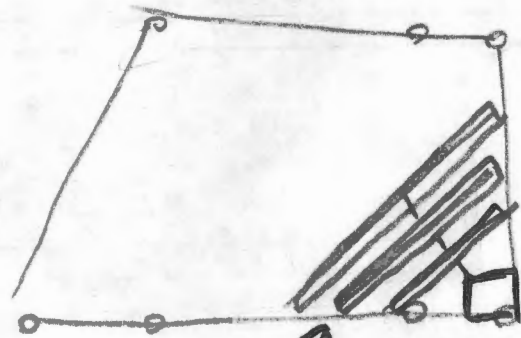

←  
Dry will  
←  
←



Dad/DM  
12/12/75

145/bedroom.

3 bedroom 1000 sq ft

4 bedroom 1250 sq ft

---

Dry well to be located:

10' from left property line  
85' From corner of proposed  
of way line (52' from center of Rt 99)  
300 sq ft, below the first C of our grade

Trench to run parallel to Left property  
line 10' from property line, in lot 6'  
max depth 12'; 30' long (3 bedroom)  
4 bedroom (60' long)

Proposed lot 1.

ok for  
 4/1/16  
 01/04/16-2/15

THE LOT SHOWN HEREON IS 10' WIDE WITH THE MINIMUM  
 REQUIREMENTS AS REQUIRED BY THE MARYLAND  
 DEPARTMENT OF TRANSPORTATION

APPROVED: \_\_\_\_\_ PRIVATE  
 ASWAGH SYSTEMS

DATE \_\_\_\_\_



- TRENCH  
 12' IN 218.3
- Driveway  
 12' IN 224.3
- SEPTIC TANK  
 12' IN 218.3
- HOUSE  
 12' IN 222.5



TITLE	PLAT PLAN
PROJECT	E. S. ...
LOCATION	...

ENGINEERING  
 PLANNING  
 SURVEYING  
 BY  
**BOENDER  
 ASSOCIATES  
 INC.**

1000 ...  
 ...  
 ...