

APPLICATION

PERCOLATION TESTING

A 38899

P _____

HOWARD COUNTY HEALTH DEPARTMENT
BUREAU OF ENVIRONMENTAL HEALTH
P.O. BOX 476 ELLICOTT CITY, MARYLAND 21043
TELEPHONE: 461-9933

DISTRICT 2

DATE 3/10/87

TO: THE COUNTY HEALTH OFFICER
ELLICOTT CITY, MARYLAND

I HEREBY, APPLY FOR THE NECESSARY TEST IN ORDER TO CONSTRUCT (OR RECONSTRUCT) A SEWAGE DISPOSAL SYSTEM.

PROPERTY OWNER EARNEST & BONNIE JACQUES

ADDRESS 560 RIVER RD., SYKESVILLE, MD. PHONE 465-0639

PROSPECTIVE BUYER _____

ADDRESS _____ PHONE _____

PROPERTY LOCATION:

SUBDIVISION CRICKET ESTATES LOT NO. 2

ROAD AND DESCRIPTION W. SIDE ROGERS AVE. (RTE. 99), S. OF I-70

TAX MAP 17 PARCEL # 558

SIZE OF LOT 1.4 AC. TYPE BLDG. SINGLE-FAMILY DWLG.
(SINGLE FAMILY DWELLING OR COMMERCIAL)

THE SYSTEM INSTALLED UNDER THIS APPLICATION IS ACCEPTABLE ONLY UNTIL PUBLIC FACILITIES BECOME AVAILABLE. I FULLY UNDERSTAND THE FEE CONNECTED WITH THE FILING OF THIS PERC TEST APPLICATION IS NON-REFUNDABLE UNDER ANY CIRCUMSTANCES. I ALSO AGREE TO COMPLY WITH ALL M.O.S.H.A. REQUIREMENTS IN TESTING THIS LOT.

C. Gottlieb (SIGNATURE OF APPLICANT) (SUNESTOR)

APPROVED BY _____ FOR _____ DATE _____


REJECTED BY _____ FOR _____ DATE _____

HOLD PENDING FURTHER TESTS _____ DATE _____

REASONS FOR REJECTION OR HOLDING 4-10-87 PERC UNSATISFACTORY DEEP CLAY - IMPROVING SOIL, NO OPPORTUNITY TO HOLD UPHILL. SAME

THIS IS NOT A PERMIT

- 0' ① ②
- DARK BR Silt LOAM
- 12" RED BROWN CLAY LOAM FEW BLACK FRAGS + QUARTZITE 15-20%
- 3' BR. Yell LOAM SOME mica FLAKES + ROCK FRAGS black (diabase) clayey
- 6' Lt yellow BR. SANDY LOAM MANY ROCKY FRAGS @ 5-8890, STICKY
- 13'

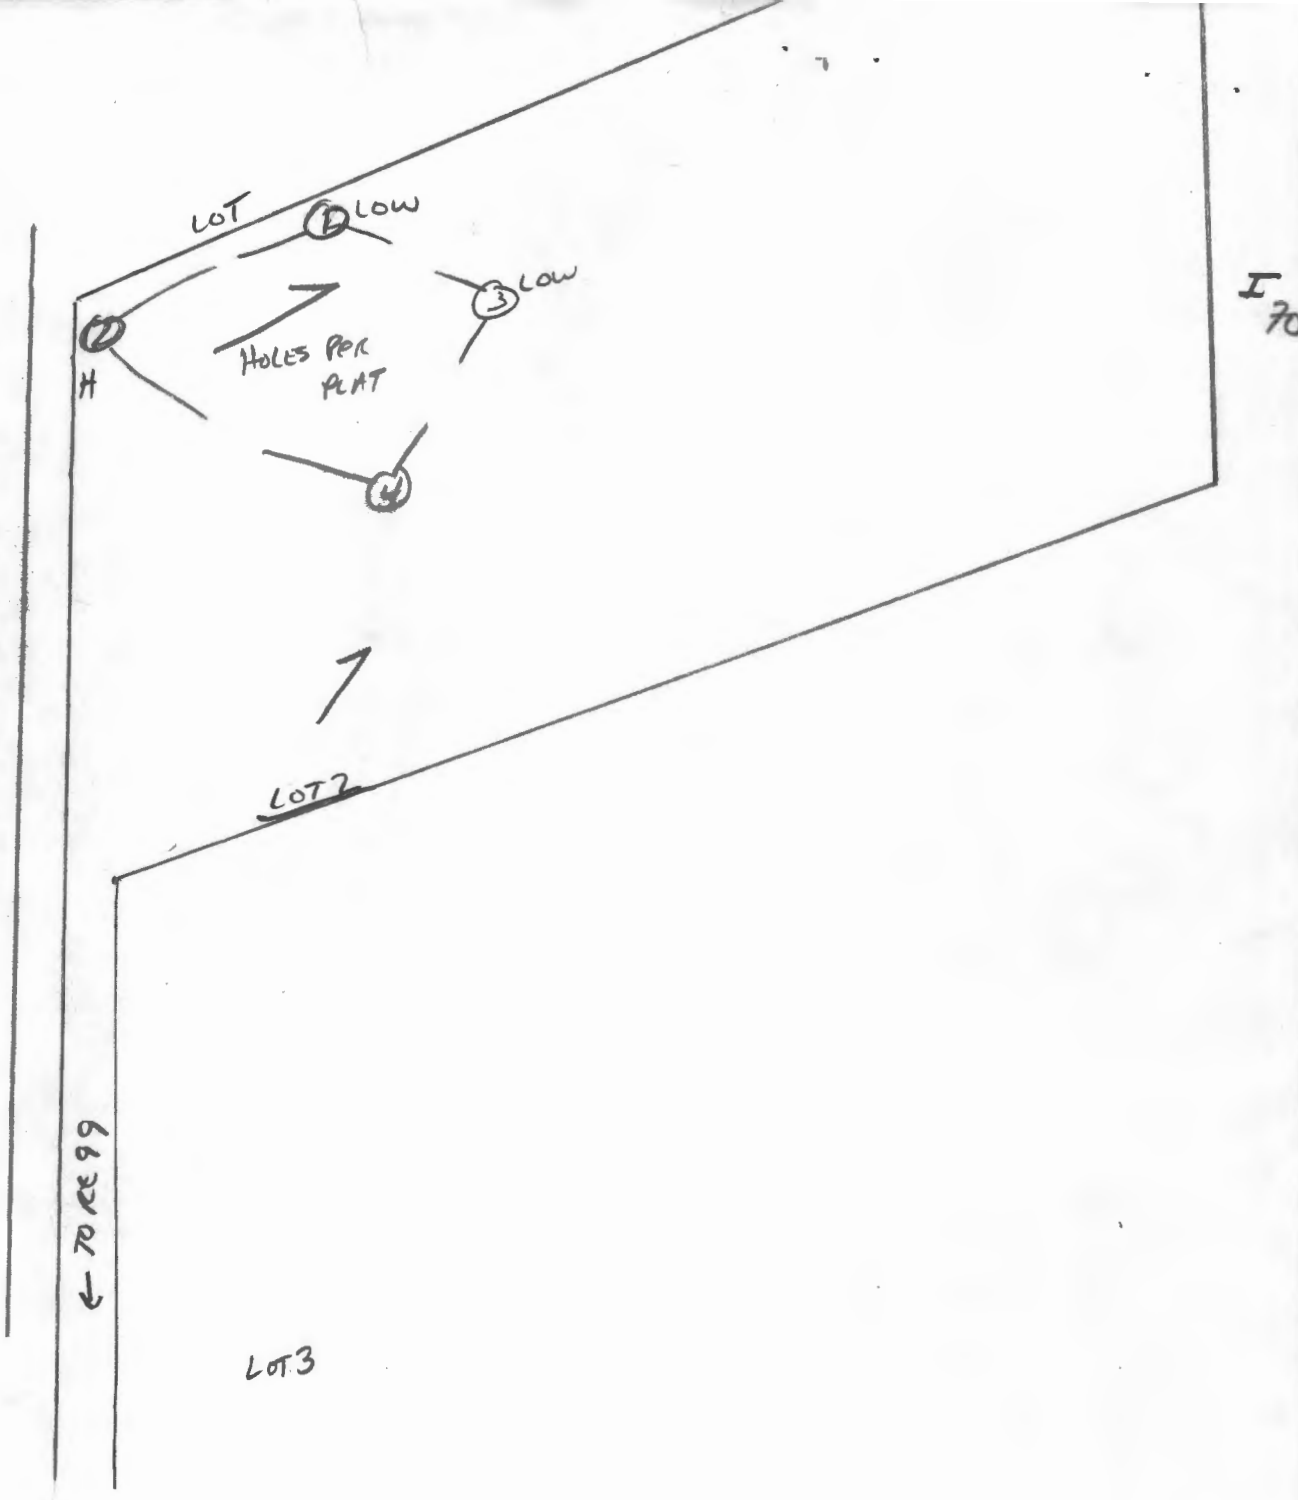

Lg/we

66 TO RE 99

HOLE	DEPTH	START	STOP
4/14/87 1 S	6'	10:26 -	11:01 → NO MOVEMENT.
1 V	13'		
2 S	5'	10:30 -	11:07 → NO MOVEMENT.
2 V	12.5'		

S. Abel (D. KETTERMAN + SCOTT SCHUMBERGER)

APPLICATION

*Prelim
4-10-87
9:30am*

PERCOLATION TESTING

A 38898

P _____

HOWARD COUNTY HEALTH DEPARTMENT
BUREAU OF ENVIRONMENTAL HEALTH
P.O. BOX 476 ELLICOTT CITY, MARYLAND 21043
TELEPHONE: 461-9933

DISTRICT 2

DATE 3/10/87

*3/10/87
OK to process 8A
date given to Scott 3-17-87*

TO: THE COUNTY HEALTH OFFICER
ELLICOTT CITY, MARYLAND

I, HEREBY, APPLY FOR THE NECESSARY TEST IN ORDER TO CONSTRUCT (OR RECONSTRUCT) A SEWAGE DISPOSAL SYSTEM.

PROPERTY OWNER EARNEST & BONNIE JACQUES

ADDRESS 560 RIVER RD, SYKESVILLE, MD. 21784 PHONE 465-0639

PROSPECTIVE BUYER _____

ADDRESS _____ PHONE _____

PROPERTY LOCATION:

SUBDIVISION CRICKET ESTATES LOT NO. 1

ROAD AND DESCRIPTION W. SIDE ROGERS AVE. (RTE. 99), S. OF I-70

TAX MAP 17 PARCEL # 558

SIZE OF LOT 2.3 AC. TYPE BLDG. SINGLE-FAMILY DWLG.
(SINGLE FAMILY DWELLING OR COMMERCIAL)

THE SYSTEM INSTALLED UNDER THIS APPLICATION IS ACCEPTABLE ONLY UNTIL PUBLIC FACILITIES BECOME AVAILABLE. I FULLY UNDERSTAND THE FEE CONNECTED WITH THE FILING OF THIS PERC TEST APPLICATION IS NON-REFUNDABLE UNDER ANY CIRCUMSTANCES. I ALSO AGREE TO COMPLY WITH ALL M.O.S.H.A. REQUIREMENTS IN TESTING THIS LOT.

Scott Shandberger (SURVEYOR)
(SIGNATURE OF APPLICANT)

APPROVED BY _____ FOR _____ DATE _____


REJECTED BY _____ FOR _____ DATE _____

HOLD PENDING FURTHER TESTS _____ DATE _____

REASONS FOR REJECTION OR HOLDING 4-10-87 Per. unsatisfactory; High water table

THIS IS NOT A PERMIT

Lg/MR

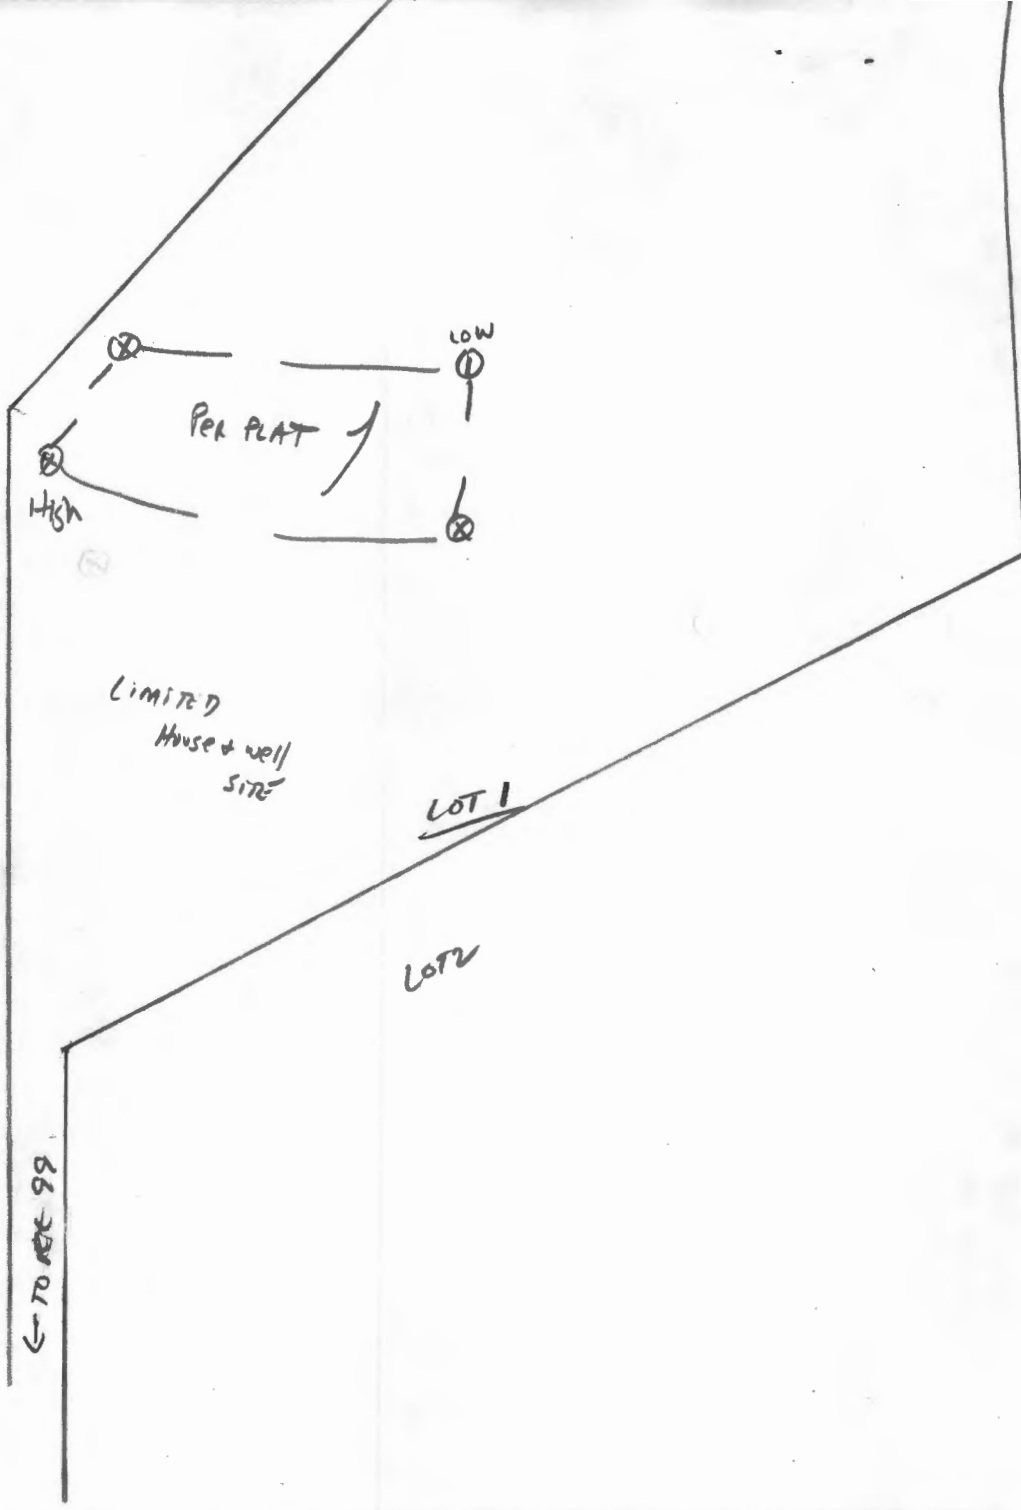

4/10/87 1V Soil MONTALTO - WATER - STREAM AT 8.5' WOT AT 5.5' CLAY TO 5.5'

HOWARD COUNTY HEALTH DEPARTMENT

JOYCE M. BOYD, M.D., M.P.H.
COUNTY HEALTH OFFICER



Bureau of Environmental Health
3525 Ellicott Mills Drive
Ellicott City, Maryland 21043

Director - 461-9956
Water & Sewerage, Permits - 461-9933
Community Environmental Health - 461-9944
Technical Services - 461-9955

April 23, 1987

Mr. Earnest Jacques
560 River Road
Sykesville, Maryland 21784


RE: Percolation Testing
Tax Map 17 Parcel 558
Cricket Estates

Dear Mr. Jacques:

Percolation testing conducted on April 10, 1987 on the above referenced property revealed unsatisfactory soil conditions. The presence of a high water table and impermeable soils result in the back two lots being considered unsuitable for private sewerage system. Lot 3 (existing house) has a currently functioning septic system with ample repair area.

If you should have any questions concerning this decision, please feel free to contact me at the above address.

Sincerely,

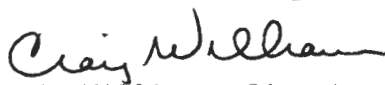
Craig Williams, Director
Water and Sewerage Program

CW:Jr

APPLICATION

REPAIR
PERCOLATION TESTING

A 38900

HOWARD COUNTY HEALTH DEPARTMENT
BUREAU OF ENVIRONMENTAL HEALTH
P.O. BOX 478 ELLICOTT CITY, MARYLAND 21043
TELEPHONE: 461-9933

P _____
DISTRICT 2
DATE 3/10/87

TO: THE COUNTY HEALTH OFFICER
ELLICOTT CITY, MARYLAND

I HEREBY, APPLY FOR THE NECESSARY TEST IN ORDER TO CONSTRUCT (OR RECONSTRUCT) A SEWAGE DISPOSAL SYSTEM.

PROPERTY OWNER EARNEST & BONNIE JACQUES

ADDRESS 560 RIVER RD, SYKESVILLE, MD PHONE 465-0639

PROSPECTIVE BUYER _____

ADDRESS _____ PHONE _____

PROPERTY LOCATION:

SUBDIVISION CRICKET ESTATES LOT NO. 3

ROAD AND DESCRIPTION W. SIDE ROGERS AVE. (RTE. 99), S. OF I-70

TAX MAP 17 PARCEL # 558

SIZE OF LOT 2.3 AC. TYPE BLDG. REPAIR PERC EXISTING SINGLE-FAMILY DWLG.
(SINGLE FAMILY DWELLING OR COMMERCIAL)

THE SYSTEM INSTALLED UNDER THIS APPLICATION IS ACCEPTABLE ONLY UNTIL PUBLIC FACILITIES BECOME AVAILABLE. I FULLY UNDERSTAND THE FEE CONNECTED WITH THE FILING OF THIS PERC TEST APPLICATION IS NON-REFUNDABLE UNDER ANY CIRCUMSTANCES. I ALSO AGREE TO COMPLY WITH ALL M.O.S.H.A. REQUIREMENTS IN TESTING THIS LOT.

Robert Shanderson (SURVEYOR)
(SIGNATURE OF APPLICANT)



APPROVED BY _____ FOR _____ DATE _____

REJECTED BY _____ FOR _____ DATE _____

HOLD PENDING FURTHER TESTS _____ DATE _____

REASONS FOR REJECTION OR HOLDING 4-10-87 EXISTING HOUSE NOT REJECTED SAG

THIS IS NOT A PERMIT

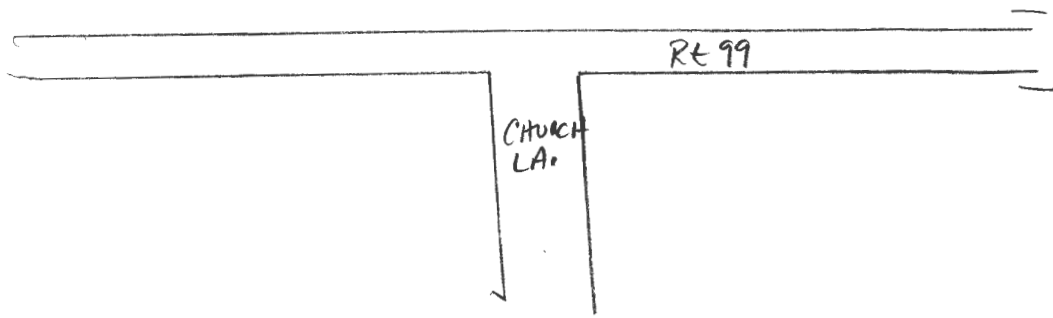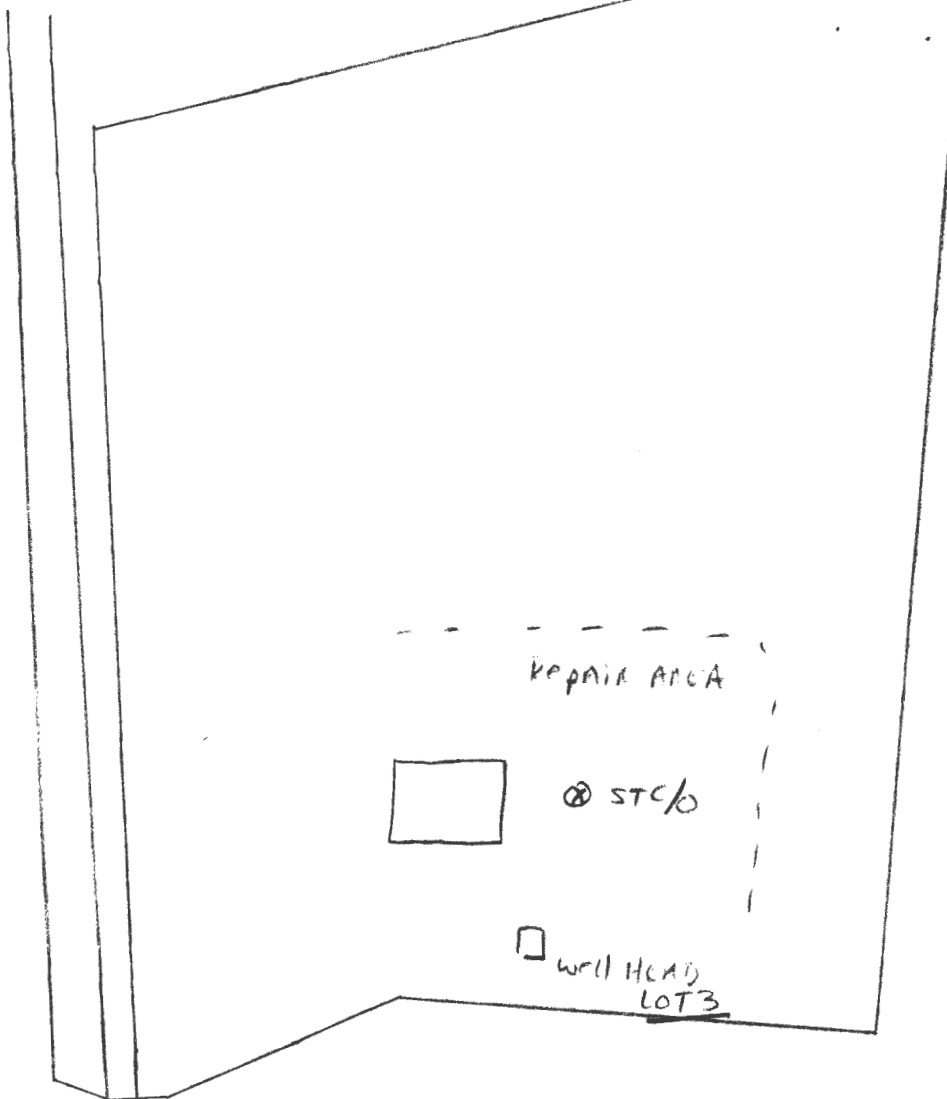

Hole	DEPTH	START	STOP	START	STOP	Time

⊗ Sewer TRUNK LINE AVAILABLE ON GRAVITY ?

