

2-12' holes  
50ft. apart

9/26/73  
j: 3"

# APPLICATION

A 19018

P \_\_\_\_\_

## SEWAGE DISPOSAL TESTING

STATE OF MARYLAND - DEPARTMENT OF HEALTH AND MENTAL HYGIENE

HOWARD COUNTY HEALTH DEPARTMENT  
ENVIRONMENTAL HEALTH SERVICES  
P. O. BOX 476, ELLICOTT CITY, MARYLAND 21043  
TELEPHONE: 465-5000, EXT. 356

DISTRICT 2

DATE 9/26/73

TO: THE COUNTY HEALTH OFFICER  
ELLICOTT CITY, MARYLAND

I, HEREBY, APPLY FOR THE NECESSARY TEST IN ORDER TO CONSTRUCT (OR RECONSTRUCT) A SEWAGE DISPOSAL SYSTEM.

PROPERTY OWNER Ferdinand Kelly Harvey B. Goss

ADDRESS 2640 Bethany Lane, Ellicott City, Md PHONE 465-8436

PROPERTY LOCATION:

SUBDIVISION \_\_\_\_\_ LOT NO. \_\_\_\_\_

ROAD AND DESCRIPTION Route 99 \* Bethany Lane - West side corner nr. water tower

SIZE OF LOT 2 m/1 TYPE BLDG. Existing house  
NUMBER OF BEDROOMS 3?

IF NOT SINGLE RESIDENCE DESCRIBE \_\_\_\_\_

THE SYSTEM INSTALLED UNDER THIS APPLICATION IS ACCEPTABLE ONLY UNTIL PUBLIC FACILITIES BECOME AVAILABLE.

SIGNATURE OF APPLICANT /s/ Roland Barth

APPROVED BY R. Macfarlane FOR Regrain P. Ws. DATE 9/26/73  
(KIND OF SYSTEM)

REJECTED BY \_\_\_\_\_ FOR \_\_\_\_\_ DATE \_\_\_\_\_  
(KIND OF SYSTEM)

HOLD PENDING FURTHER TESTS \_\_\_\_\_ DATE \_\_\_\_\_

REASONS FOR REJECTION OR HOLDING \_\_\_\_\_

BLDG. PERMIT SIGNED AND RETURNED 11/1/73

Serial # 56239 SFD.  
Addition - Bed room + family room

465-1560 - Reginald L. Malloy

# THIS IS NOT A PERMIT


INDICATE NORTH. - NAME ADJOINING ROADWAY AS BASE LINE.

DATE	TEST NO.	DEPTH	PRE-WET		TEST - 1" DROP		TIME
			START	STOP	START	STOP	

REMARKS \_\_\_\_\_

TYPE OF SOIL \_\_\_\_\_

# APPLICATION

A 19018

## SEWAGE DISPOSAL TESTING

P \_\_\_\_\_

STATE OF MARYLAND - DEPARTMENT OF HEALTH AND MENTAL HYGIENE

HOWARD COUNTY HEALTH DEPARTMENT  
ENVIRONMENTAL HEALTH SERVICES  
P. O. BOX 476, ELLICOTT CITY, MARYLAND 21043  
TELEPHONE: 465-8000, EXT. 386

DISTRICT 2

DATE 9/26/73

TO: THE COUNTY HEALTH OFFICER  
ELLICOTT CITY, MARYLAND

I, HEREBY, APPLY FOR THE NECESSARY TEST IN ORDER TO CONSTRUCT (OR RECONSTRUCT) A SEWAGE DISPOSAL SYSTEM.

PROPERTY OWNER Ferdinand Kelly

ADDRESS \_\_\_\_\_ PHONE \_\_\_\_\_

PROPERTY LOCATION:

SUBDIVISION 2640 LOT NO. \_\_\_\_\_

ROAD AND DESCRIPTION Route 99 \* Bethany Lane - West side corner nr. water tower

SIZE OF LOT 2 m/l TYPE BLDG. Existing house  
37  
NUMBER OF BEDROOMS

IF NOT SINGLE RESIDENCE DESCRIBE \_\_\_\_\_

THE SYSTEM INSTALLED UNDER THIS APPLICATION IS ACCEPTABLE ONLY UNTIL PUBLIC FACILITIES BECOME AVAILABLE.

SIGNATURE OF APPLICANT /s/ Roland Barth


APPROVED BY \_\_\_\_\_ FOR \_\_\_\_\_ DATE \_\_\_\_\_  
(KIND OF SYSTEM)

REJECTED BY \_\_\_\_\_ FOR \_\_\_\_\_ DATE \_\_\_\_\_  
(KIND OF SYSTEM)

HOLD PENDING FURTHER TESTS \_\_\_\_\_ DATE \_\_\_\_\_

REASONS FOR REJECTION OR HOLDING \_\_\_\_\_

# THIS IS NOT A PERMIT

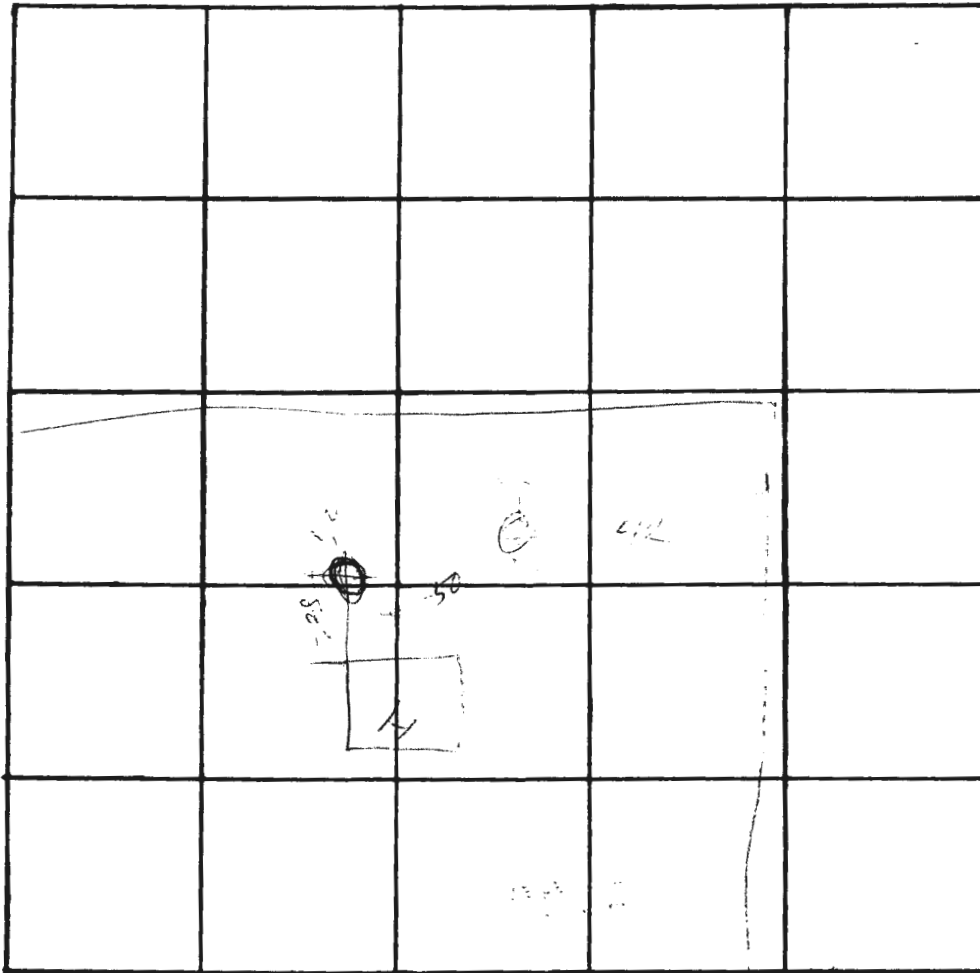

56 40  
 PN

INDICATE NORTH. - NAME ADJOINING ROADWAY AS BASE LINE.

Bethany Ln

DATE	TEST NO.	DEPTH	PRE-WET		TEST - 1" DROP		TIME
			START	STOP	START	STOP	
9/26/73	1	3'	1 <sup>41</sup>	1 <sup>44</sup>	1 <sup>44</sup>	1 <sup>51</sup>	7
	2	12	1 <sup>47</sup>	1 <sup>51</sup>	1 <sup>51</sup>	1 <sup>56</sup>	5
	3	11	2 <sup>15</sup>	2 <sup>3</sup>	2 <sup>17</sup>	2 <sup>20</sup>	3
	4	3	2 <sup>15</sup>	2 <sup>16</sup>	2 <sup>15</sup>	2 <sup>25</sup>	9
	5		2 <sup>1</sup>				

REMARKS \_\_\_\_\_ RM

TYPE OF SOIL \_\_\_\_\_



