

PERMIT

SEWAGE DISPOSAL SYSTEM

MARYLAND STATE DEPARTMENT OF HEALTH

HOWARD COUNTY

ELLICOTT CITY

INDEXED

DISTRICT 2

DATE 8/4/69

P 14688

A _____

file 1-74

Joseph P. Neubauer, Jr.

IS PERMITTED TO INSTALL _____ ALTER

ADDRESS 5333 Karger Road, Ellicott City, Md.

PHONE 465-3605

A SEWAGE DISPOSAL-SYSTEM LOCATED AT _____

SUBDIVISION _____ ROAD Montgomery Rd. LOT _____

PROPERTY OWNER Howard County Board of Education--Ellicott City Middle School

ADDRESS _____

SPECIFICATIONS

DRAIN FIELD _____ DEPTH _____ FEET, BOTTOM AREA _____ SQ. FT.

SEEPAGE PITS _____ ABSORBENT SIDE-WALL AREA _____ SQ. FT.

SEPTIC TANK CAPACITY _____ GALLONS

FOR GARBAGE GRINDER, INCREASE DISPOSAL AREA 22% & TANK CAPACITY 50%.

OTHER REPAIR - Recommendations will be given at site when inspection is made.

PLANS APPROVED BY Fred Frennelt


DATE 8/4/69

FILL SEPTIC TANK AND DISTRIBUTION BOX WITH WATER BEFORE CALLING FOR AN INSPECTION. COVER NO WORK UNTIL INSPECTED AND APPROVED.

NEITHER THE HOWARD COUNTY COMMISSIONERS NOR THE HEALTH DEPARTMENT IS RESPONSIBLE FOR THE SUCCESSFUL OPERATION OF ANY SYSTEM.

NOTIFY THE HEALTH DEPARTMENT 48 HOURS BEFORE EXCAVATIONS ARE TO BE BACK FILLED.

889712

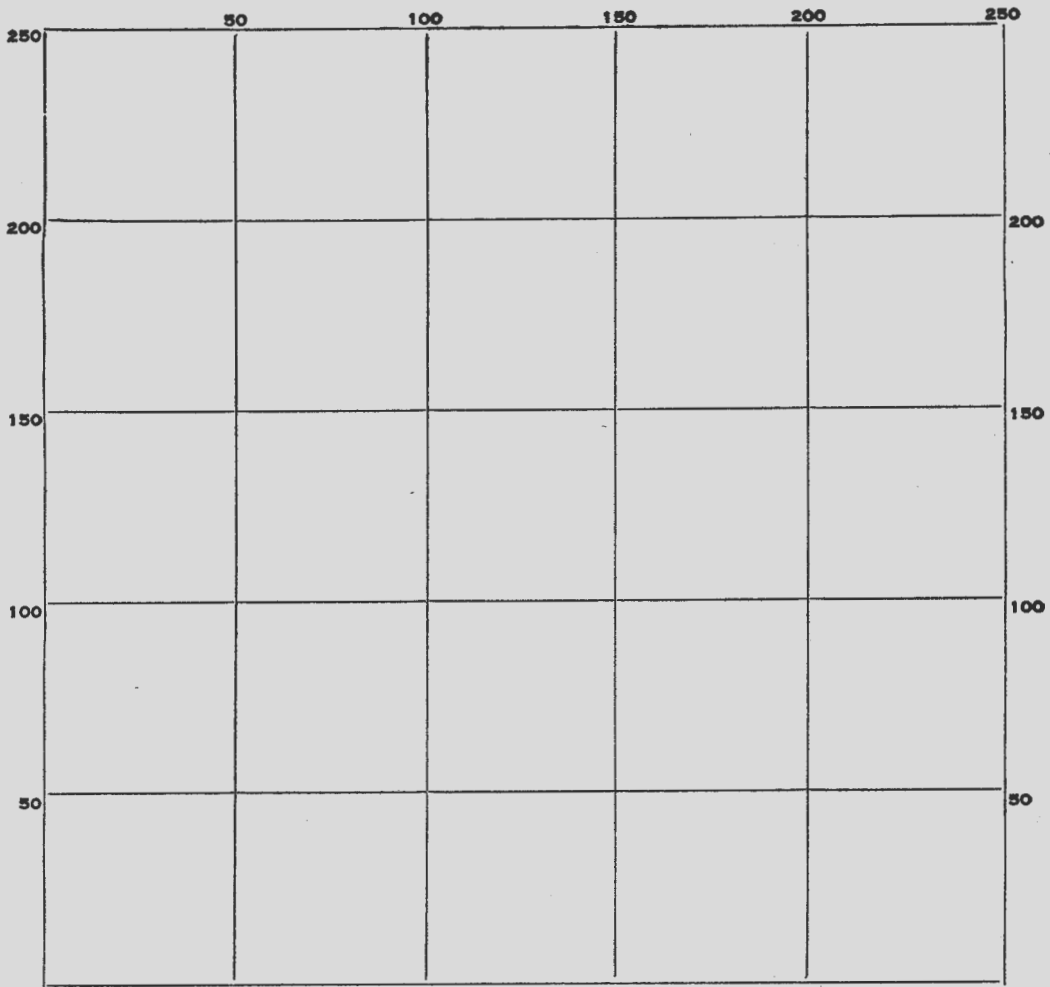

INDICATE NORTH. - NAME ADJOINING ROADWAY AS BASE LINE.

PERMIT CARD _____

SEPTIC TANK, LEVEL _____ CLEANOUTS _____

DISTRIBUTION BOX, LEVEL _____

TILE FIELD, DEPTH _____ FT. TRENCH WIDTH _____ FT.

GRAVEL DEPTH _____ IN. TOTAL LENGTH _____ FT.

NUMBER OF TRENCHES _____ TOTAL BOTTOM AREA _____

SEEPAGE PITS, INSIDE DIAMETER _____ FT. DEPTH BELOW INLET _____ FT.

ABSORBENT AREA _____ SQ. FT.

REMARKS ¹⁻⁷⁴ *Sketch in office on this school - several deep trenches were installed in conjunction with existing drywells - 2 drywell were backfilled because were constantly overflowing*

DATE SYSTEM APPROVED _____ INSPECTOR *Lionel [Signature]*

2:40

VV

51B
BH

FILE Sewage Complaint DATE REPORTED 3/12/79

PROPERTY OWNER Ellicott City Middle School

P.O. ADDRESS Montgomery Road, Ellicott City, Md. TELEPHONE _____

DIRECTIONS TO PROPERTY _____

INFORMANT Mrs. John Lane
4403 Montgomery Road
Ellicott City, Maryland
F 465-6189

Mrs. Lane stated that four times the sewage has backed up inside the school! She did not report it the first three times but wanted to go down on record as reporting it this time. She feels that something should be done about it. She stated that if the school would ask they would bring public sewer up to the school for them. I do not know where she got this information from.

CONDITION FOUND *Principal informed me that boys bathroom had problem last week - toilet stopped up & overflowed in bathroom & science room. Said problem was corrected the same day. Custodian ^{Mrs. [unclear]} System backs up about every 3 months. Pump sewage 2000 yds to dry wells; sometimes a problem. Fan in pump house disseminates odor.*

ACTION TAKEN *Line has most trouble - worked on in full. Walked out over area of drain field - no evidence of sewage or odor.*

Memo to Walt Budman Bd of Ed.

A sewage overflow was reported

3/20/79 TC from Budman problem was internal.

No further overflow, file. M07 10/24/79

FINAL DISPOSITION _____

File

4076

FILE Overflowing Septic System DATE REPORTED April 6, 1984

PROPERTY OWNER Ellicott City Middle School 465-4433

P. O. ADDRESS 4445 Rt. 103 Montgomery Road E.C., Maryland

DIRECTIONS TO PROPERTY Stonecrest development to Brittany Drive - second left to 4225
Brittany Circle to Hesse's House - right behind their house on the school property.

INFORMANT Mrs. Gale Heuer PHONE: 465-6204
4409 Brittany Drive
Ellicott City, Maryland 21043


There is a terrible raw sewage odor coming from the woods located on the school property. Maybe one of the drywells is overflowing.

For C.B.D. + Hesse

CONDITION FOUND: 4/9/84 ✓ of area no definite signs of sewage however, saturated area behind 4226 and Hesse's house
Note no one answered door at Hesse's home also ✓ on what is discharged from their rear-house small black pipe present C.B.D. + B. Hesse; Pump pump
4/19/84 ✓ site ✓ noted - no sewage odor noted - water clear - no water weenies noted. C.B.D. Storm water apparently

ACTION TAKEN: 4/9/84 on P.S.R.V. - ✓ on Tak Maps + our system records.
e. spoke on 4/19/84 Karen Jeffries of 4226. Hold for a call if odor or weenies develop from Ms. Jeffries; Re-call 4/30/84

FINAL DISPOSITION: 5/2/84 Site check found no odor or steady water. File no immediate health hazard this date C.B.D.

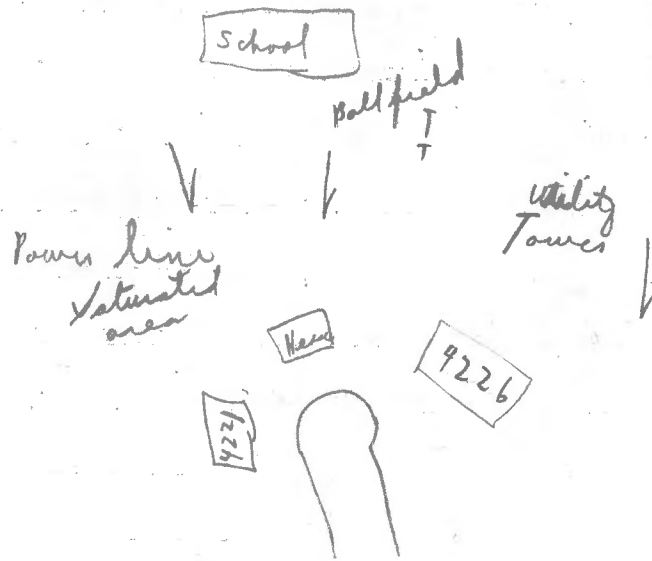

Field comment

4/9/84 (1) C. B. & B. Hesse
 inspected - no
 sewage odor +/o
 raw effluent noted
 this date.

(2) i of office
 about school's
 septic system
 +/o Recall 4/19/84.
 B. Hesse C. B. &

Rec'd 4/11/84 #9076

Ellicott City Middle School
Ellicott City Maryland

(name of person(s) and address as listed in the tax records of the County)

Map # 24; Grid 31; Parcel 494

Dear _____
name(s)

On April 1984, while investigating a complaint concerning a condition allegedly hazardous to health, _____ inspected your property known as parcel # _____ located at _____
name of inspector parcel # and tax map on tax map street address

During that inspection he observed _____
name, he, she, or I detailed description of the health problem observed.

At that time _____ met with _____ and discussed the problem. _____ informed that the Health Department had observed the problem, and that _____
name, he, she or I name(s) or you He was, She was, You were brief description of correction required would be necessary.

As the _____ creates a condition which is, or may be hazardous to the public health, you are hereby ordered to _____
brief description of condition detailed description of the correction required within 10-30 days of receipt of this letter.

yes Paragraph explaining that an extension may be granted in cases of public sewer connection. Check one.
 no

If you believe that the condition(s) described above (is not/are not) and could not be a hazard to health.... hearing etc.

Eng X-2411 ✓ Public Sewer
Grid 24 Map 24
Parcel 494
9 P 579
Map 31
Grid #1

As the _____ creates a condition which
(brief description of condition)
is, or may be hazardous to the public health, you are hereby ordered to _____

(detailed description of the correction required)
within _____ days of receipt of this letter. (As completion of sewer con-
(10-30)

nections may reasonably need more time than the thirty (30) days allotted, you may be granted an extension of up to thirty (30) additional days upon presentation to this office of substantial evidence of your intention to comply with this order, such as a copy of the cash receipt for the payment submitted with a sewer connection application.)

If you believe that the condition(s) described above is not
(is not/are not)

and could not be a hazard to health, or that the Health Department is not acting in compliance with pertinent laws and regulations, you may request a formal hearing before the Board of Health within ten (10) days of receipt of this letter. If you wish to discuss the evidence, the regulations, or your individual circumstances, you are encouraged to request a meeting with us by calling 902-2330 and scheduling an appointment.

See revised bill "33"
If you fail to respond to or comply with this order, we will, through due process, secure a summons for you to appear at District Court for trial. Failure to appear for trial will result in a warrant being issued for your arrest.

The investigation of this complaint and the enforcement powers of the Health Department are set forth in Section 12 of the Howard County Code, a copy of which is available for your inspection at this office.

The policy of the Health Department is to cooperate with the citizens of the County in seeking solutions to public and environmental health problems. If voluntary compliance is not successful, we are required to take necessary action to protect the health and safety of our citizens. We hope you will agree that the corrective actions are reasonable, prudent, and in the best interests of all concerned.

In closing, may I restate our willingness to discuss the problem. Please feel free to contact us.

Very truly yours,
Charles B. Steady, Director
Community Hygiene Co.

✓ Tat Mayo

✓ x2411