

*Pre*

# APPLICATION

A 29413

SEWAGE DISPOSAL TESTING

STATE OF MARYLAND - DEPARTMENT OF HEALTH AND MENTAL HYGIENE

P \_\_\_\_\_

HOWARD COUNTY HEALTH DEPARTMENT  
ENVIRONMENTAL HEALTH SERVICES  
P.O. BOX 476 ELLICOTT, MARYLAND 21043  
TELEPHONE: 992-2330

DISTRICT 4th

DATE 1/17/79

TO: THE COUNTY HEALTH OFFICER  
ELLICOTT CITY, MARYLAND

I, HEREBY, APPLY FOR THE NECESSARY TEST IN ORDER TO CONSTRUCT (OR RECONSTRUCT) A SEWAGE DISPOSAL SYSTEM.

PROPERTY OWNER H.B.L. Properties, Inc.

ADDRESS \_\_\_\_\_ PHONE Boender - 465-7777

PROPERTY LOCATION: \_\_\_\_\_  
SUBDIVISION BED LION ESTATES LOT NO. 14

*Now #8 10/80 PLAT*

ROAD AND DESCRIPTION Old Frederick Road

SIZE OF LOT 6.7 acres TYPE BLDG. 3 or 4 bedrooms

THE SYSTEM INSTALLED UNDER THIS APPLICATION IS ACCEPTABLE ONLY UNTIL PUBLIC FACILITIES BECOME AVAILABLE.

I FULLY UNDERSTAND THE FEE CONNECTED WITH THE FILING OF THIS PERC TEST APPLICATION IS NON-REFUNDABLE UNDER

ANY CIRCUMSTANCES.

SIGNATURE OF APPLICANT /s/ Jack Boender for E. Brooke Lee

APPROVED BY Raymond Boeger FOR Trench & Myrland DATE 7/23/84

REJECTED BY \_\_\_\_\_ FOR \_\_\_\_\_ DATE \_\_\_\_\_

HOLD PENDING FURTHER TESTS \_\_\_\_\_ DATE \_\_\_\_\_

REASONS FOR REJECTION OR HOLDING hold. sewage between plat & field in measurements

7/23/84 Spec written BH

BLDG. PERMIT SIGNED AND RETURNED 10/31/84  
S. Hill


*BP# 8626*

# THIS IS NOT A PERMIT

NOW #8

SOIL PROFILE

0

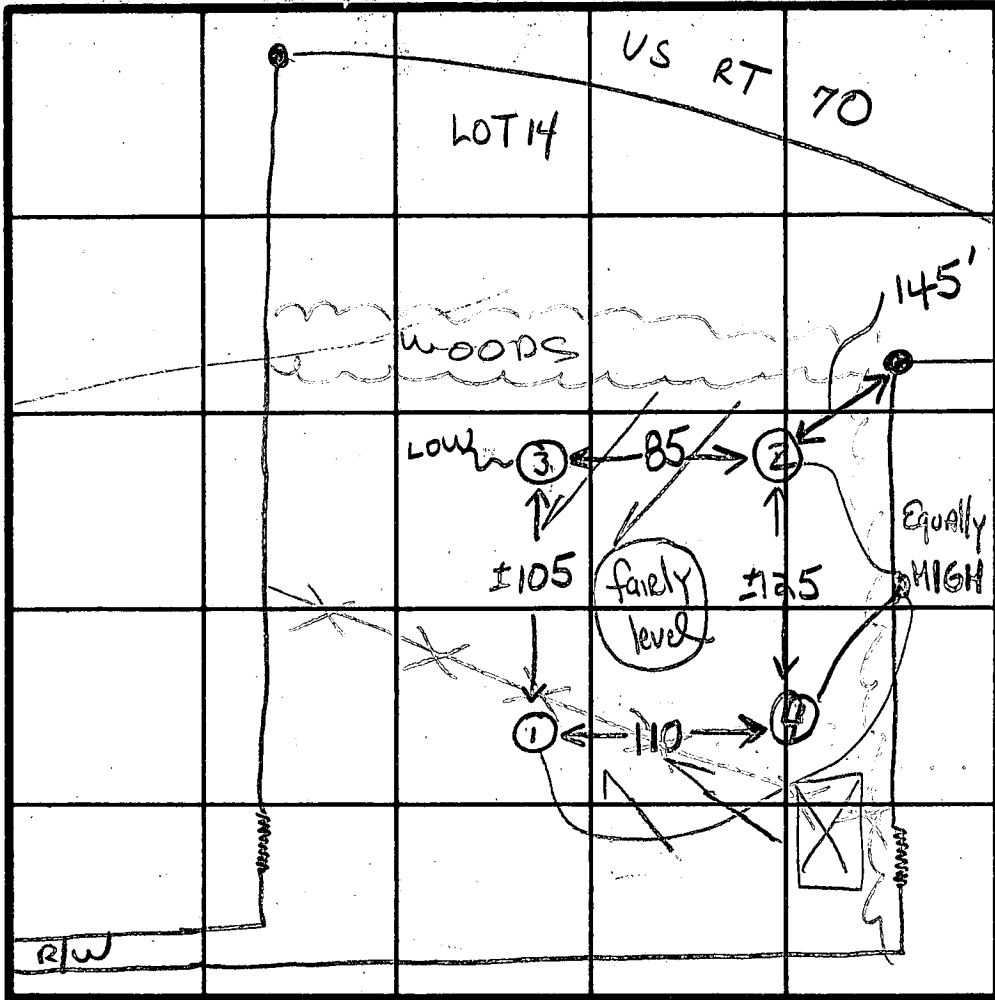

INDICATE NORTH - NAME ADJOINING ROADWAY AS BASE LINE.

A29413

DATE	TEST NO.	DEPTH	PRE-WET		TEST - 1" DROP		TIME
			START	STOP	START	STOP	
19 MAR 77	25	4	250	258	258	310	12
	20	13	250	304	304	325	21
	4S	4	256	300	300	308	8
	4D	12'	256	304	304	311	7
	1S	4 1/2					16
	1D	13					9
	3S	13' VISUAL	(SANDY LOAM)				
	3D						

from perc sheet lot 13

DW


REMARKS open field Field check

TYPE OF SOIL SANDY LOAM - NO pronounced clay layer - SILTY LOAM

TESTED BY GLK ALSO PRESENT D:D

VEHICULAR INGRESS AND EGRESS  
IS RESTRICTED (PUBLIC)

JOHN H. MCCANN AND WIFE  
271/12  
EX. ZONING: R

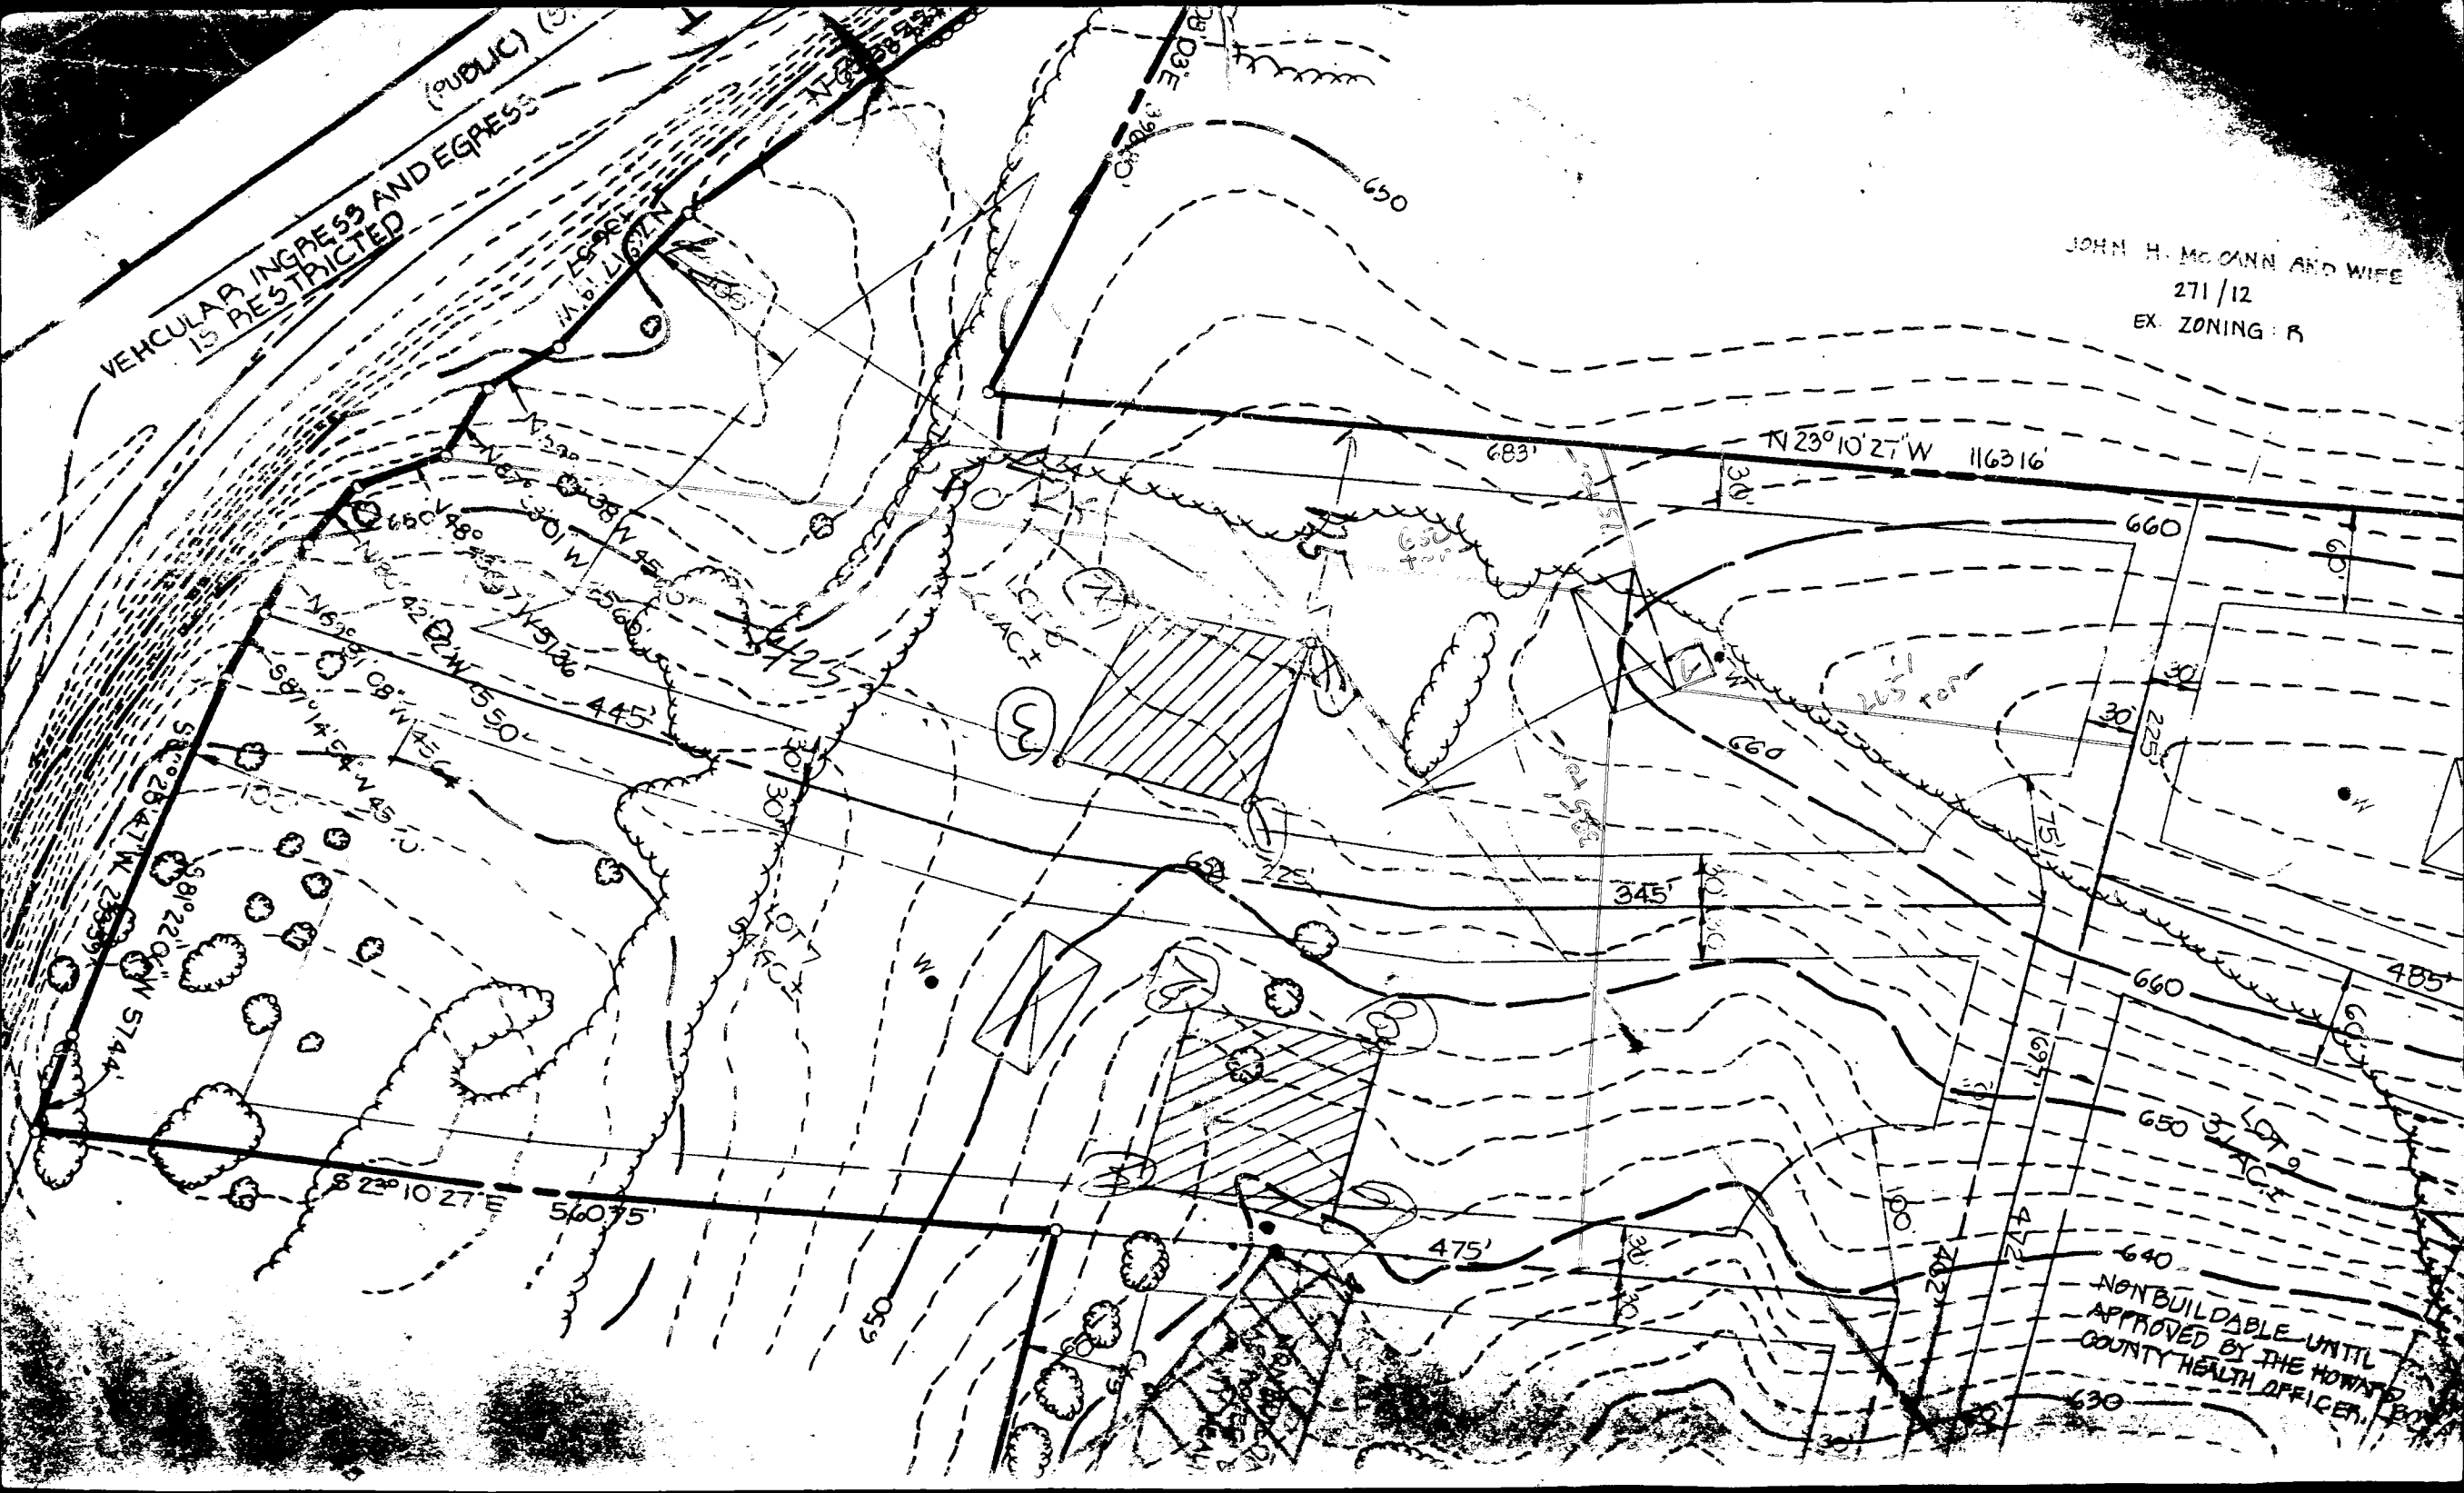

NON-BUILDABLE UNTIL  
APPROVED BY THE HOWARD  
COUNTY HEALTH OFFICER.