

5-81 Need 14'-15' deep riser hole before release F.F.

# APPLICATION

A 08676

SEWAGE DISPOSAL TESTING

P \_\_\_\_\_

MARYLAND STATE DEPARTMENT OF HEALTH

HOWARD COUNTY

ELLICOTT CITY

DISTRICT 5

DATE 6/30/64

1250

Septic Tank - 7000 gal.

Dry Well - 400<sup>480</sup> sq. ft. sidewall area below trench the inlet pipe.

Place Dry well 170 ft from front property line and 35 ft from right side line as seen when facing the lot from Green Bridge Rd. Inlet pipe to be 3 ft below surface of ground. eff. area starts at 4 ft total max. depth? (4 1/2-5 depending on wind results)

TO: THE COUNTY HEALTH OFFICER  
ELLICOTT CITY, MARYLAND

I, HEREBY, APPLY FOR THE NECESSARY TESTS IN ORDER TO CONSTRUCT (OR RECONSTRUCT) A SEWAGE DISPOSAL SYSTEM.

PROPERTY OWNER Roy E. Bateman

ADDRESS \_\_\_\_\_ PHONE \_\_\_\_\_

PROPERTY LOCATION:

SUBDIVISION Karinwood LOT NO. 6

ROAD AND DESCRIPTION Green Bridge Road

OCCUPANT \_\_\_\_\_ PHONE \_\_\_\_\_

PERSON TO CONSTRUCT SYSTEM \_\_\_\_\_

ADDRESS \_\_\_\_\_ PHONE \_\_\_\_\_

SIZE OF LOT 2.236 acres TYPE BLDG. 4 NUMBER OF BEDROOMS

IF NOT SINGLE RESIDENCE DESCRIBE \_\_\_\_\_

SIGNATURE OF APPLICANT Carol A. Scherzwell 7/28/64

APPROVED BY J. J. Brown FOR \_\_\_\_\_ DATE \_\_\_\_\_  
(KIND OF SYSTEM)


REJECTED BY \_\_\_\_\_ FOR \_\_\_\_\_ DATE \_\_\_\_\_  
(KIND OF SYSTEM)

HOLD PENDING FURTHER TESTS \_\_\_\_\_ DATE \_\_\_\_\_

REASONS FOR REJECTION OR HOLDING \_\_\_\_\_

# THIS IS NOT A PERMIT

2  
07/01

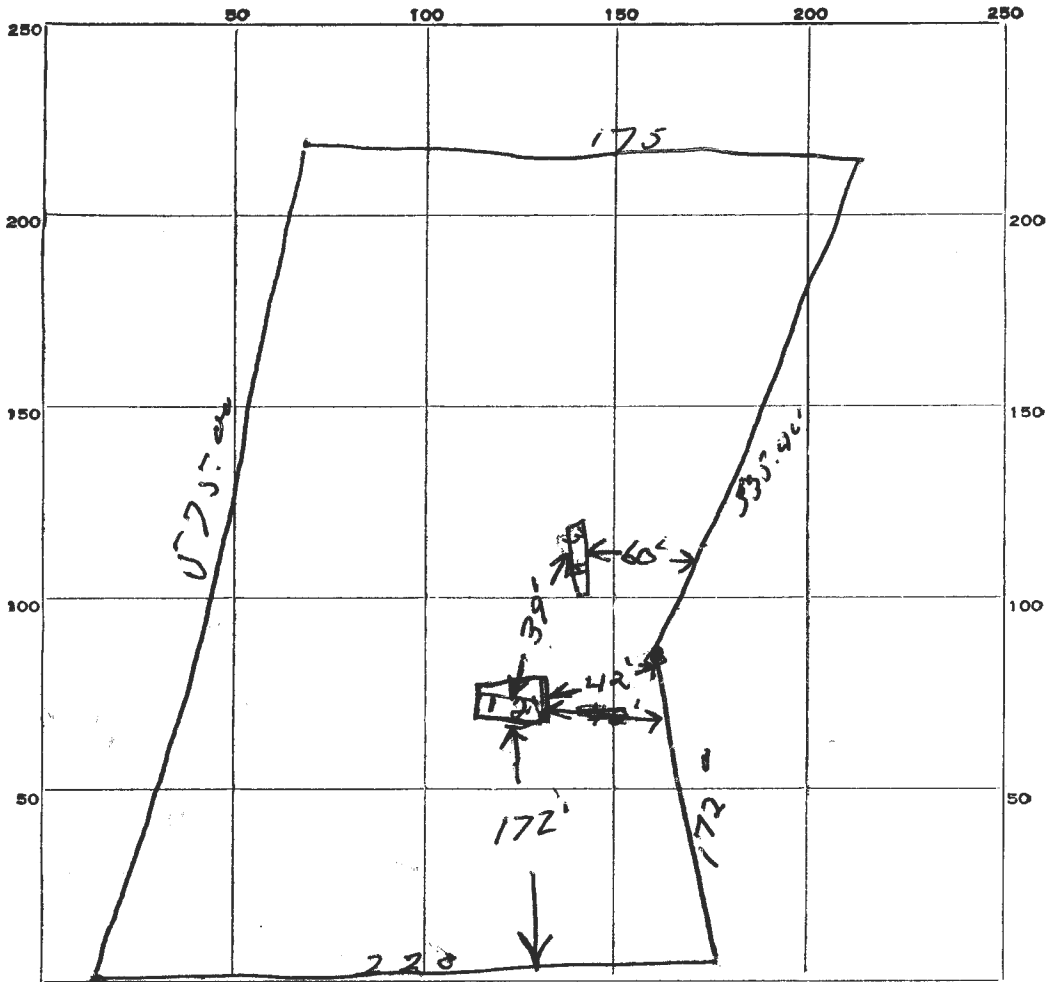

INDICATE NORTH. - NAME ADJOINING ROADWAY AS BASE LINE.

*Green Bridge Road*



DATE	TEST NO.	DEPTH	PRE-WET		TEST - 1" DROP		TIME
			START	STOP	START	STOP	
7/28/64	3	9'	10:17	10:19	10:29	10:26	7 MIN.
	4	4'	10:18	10:21	10:21	10:33	12 MIN.
	1	8½'	10:28	10:29	10:29	10:36	7 MIN.
	2	4'	10:29	10:30	10:30	10:30½	½ MIN.

SOIL AUGER FINDING \_\_\_\_\_

TESTED BY 7/28/64 S.J.G. P.M.

REMARKS \_\_\_\_\_

ALSO PRESENT Edward J. Jagg LOT NO. 6

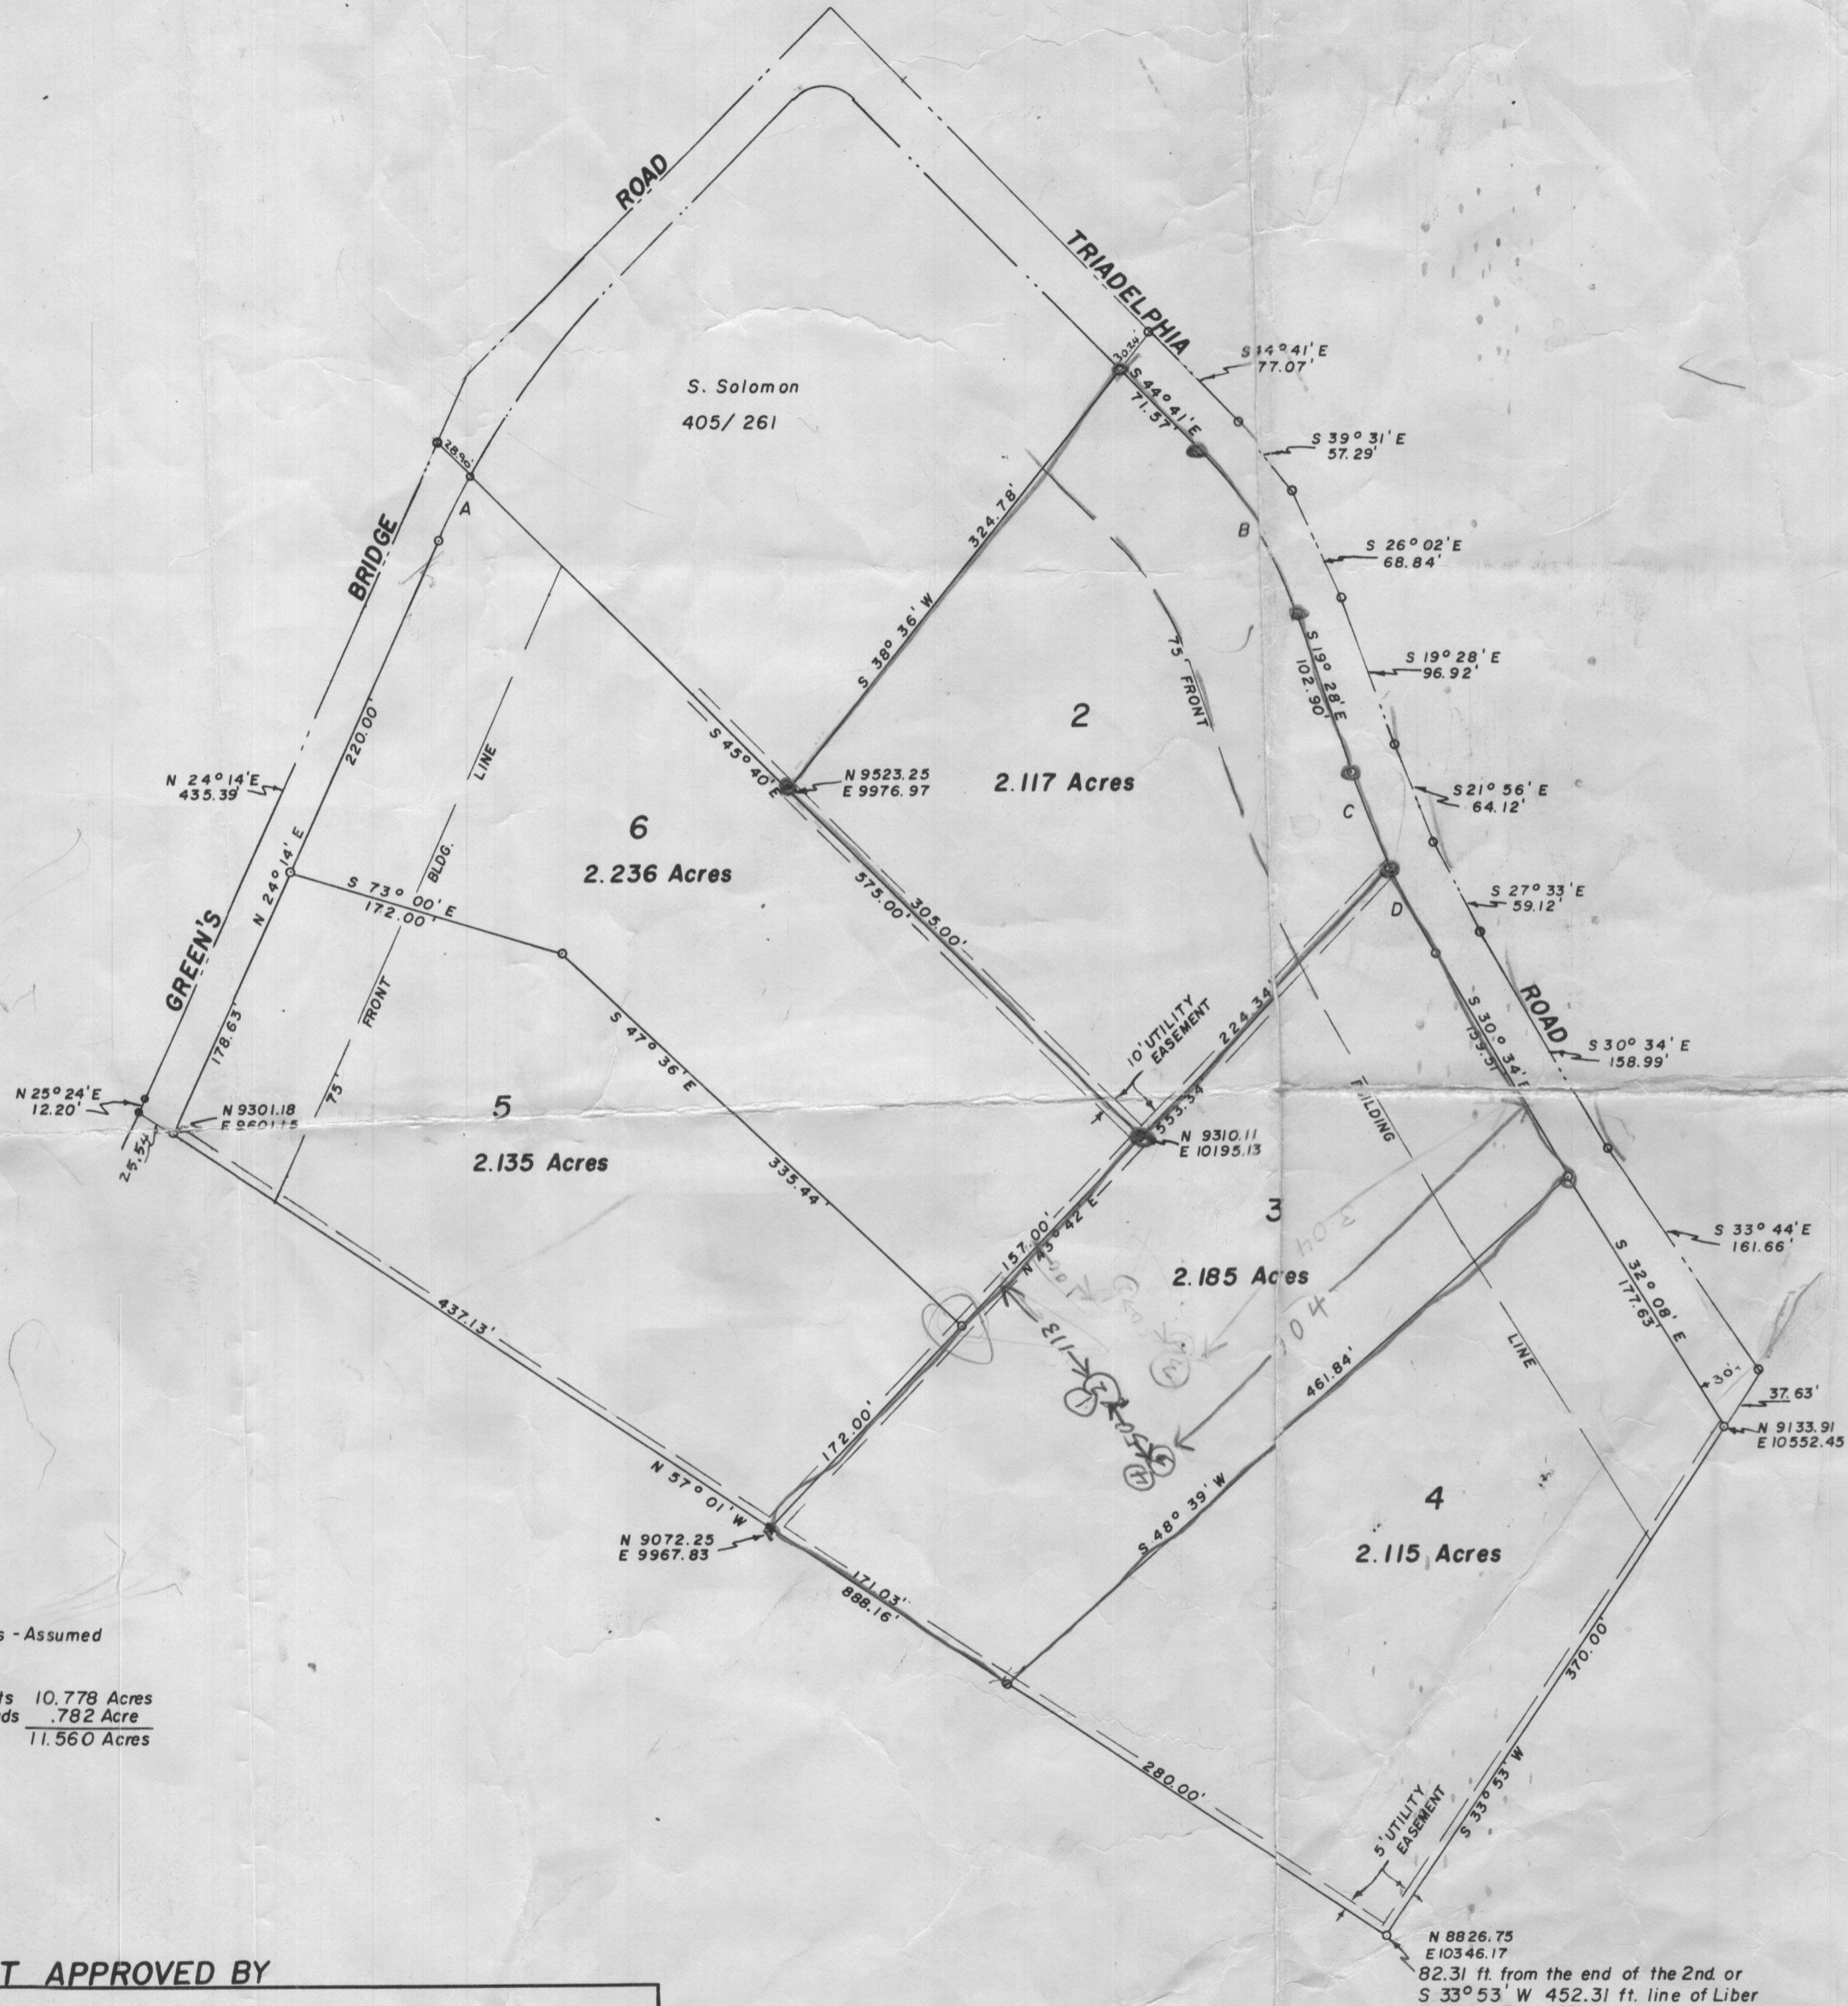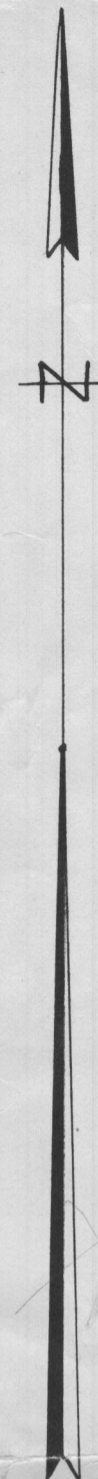

Coordinates - Assumed  
 Area in Lots 10.778 Acres  
 Area in roads .782 Acre  
 Total 11.560 Acres

**OWNERS DEDICATION**

We, Ray E. Bateman and Carolyn W. Bateman his wife, owners of the property shown and described hereon adopt this plan of subdivision and reserve the fee simple title to the beds of the streets and/or roads shown hereon, and in consideration of the approval of this plat by the Planning Commission of Howard County, we for ourselves, our heirs or assigns, do hereby give and grant unto the Board of County Commissioners of Howard County the right and option to acquire for the consideration of one dollar the fee simple title to the beds of the streets and/or roads as shown hereon, within the period of five years from the date of the recording of this plat among the Land Records of Howard County.

Witness our hands and seals this 20th day of February 1964

*Ray E. Bateman*  
 Ray E. Bateman  
 1056 Roston St.  
 Silver Springs, Md.

*Carolyn W. Bateman*  
 Carolyn W. Bateman

**ENGINEERS CERTIFICATE**

I hereby certify that the plan shown hereon is correct, that it is a subdivision of a part of the land which by deed dated June 1, 1962 and recorded among the Land Records of Howard County in Liber No. 384, folio 158 etc. was granted and conveyed by Manor Apartments Inc. to Ray E. Bateman and wife, and that iron pipes marked thus o and concrete monuments marked thus ■ are in place as shown hereon.  
 I further certify that the requirements of Section 72 A to 72 D of the Annotated Code of Maryland (Title Clerk of Court - Subtitle Clerk of Circuit Court) as far as they relate to the marking of this plat and setting of markers have been complied with.

*Claude M. Skinner Jr.*  
 Claude M. Skinner Jr. Reg. Engineer & Land Surveyor No. 2237  
 11 Court Place  
 Ellicott City, Md.

**MAP OF  
 "KARINWOOD"  
 FIFTH ELECTION DISTRICT OF HOWARD COUNTY  
 DAYTON, MARYLAND  
 SCALE: 1 IN.=100 FT. FEBRUARY 20, 1964**

**PLAT APPROVED BY**

2-26-64  
 Date *Wilmer M. Sanner*  
 Wilmer M. Sanner, Chairman of Planning Commission

2-26-64  
 Date *Thomas G. Harris Jr.*  
 Thomas G. Harris Jr. Planning Director

2-26-64  
 Date *Herman O'Neill*  
 Herman O'Neill, County Roads Supervisor

3-3-64  
 Date *Carl W. Meyer*  
 Carl Meyer, Chief Engineer of the Metropolitan Commission

**CURVE DATA**

Curve	Radius	Angle	Arc	Tangent	Chord
A	542.19'	04° 31'	42.74'	21.38'	N 26° 29' 30" E 42.72'
B	268.24'	25° 13'	118.06'	60.00'	S 32° 04' 30" E 117.10'
C	617.47'	05° 47'	62.33'	31.19'	S 22° 21' 30" E 62.30'
D	617.47'	05° 19'	57.30'	28.67'	S 27° 54' 30" E 57.28'

RECORDED PLAT BOOK 9 FOLIO 72  
 ON March 5, 1964 AMONG THE LAND RECORDS OF  
 HOWARD COUNTY, MD.

*Karinwood* C-2262

Real Property Data Search ( w2)

Search Result for HOWARD COUNTY

View Map		View GroundRent Redemption				View GroundRent Registration			
<b>Tax Exempt:</b>		<b>Special Tax Recapture:</b>							
<b>Exempt Class:</b>		NONE							
<b>Account Identifier:</b>		<b>District - 05 Account Number - 365775</b>							
Owner Information									
<b>Owner Name:</b>		SCHOLZ JOSEPH T SCHOLZ NANCY C				<b>Use:</b>		RESIDENTIAL	
<b>Mailing Address:</b>		5475 GREEN BRIDGE RD DAYTON MD 21036-				<b>Principal Residence:</b>		NO	
						<b>Deed Reference:</b>		/17273/ 00213	
Location & Structure Information									
<b>Premises Address:</b>		GREEN BRIDGE RD DAYTON 21036-0000				<b>Legal Description:</b>		LOT 6 GREEN BRIDGE RD KARINWOOD	
<b>Map:</b>	<b>Grid:</b>	<b>Parcel:</b>	<b>Sub District:</b>	<b>Subdivision:</b>	<b>Section:</b>	<b>Block:</b>	<b>Lot:</b>	<b>Assessment Year:</b>	<b>Plat No:</b>
0027	0024	0076		0000			6	2017	Plat Ref:
<b>Special Tax Areas:</b>		<b>Town:</b>				NONE			
		<b>Ad Valorem:</b>				100			
		<b>Tax Class:</b>							
<b>Primary Structure Built</b>		<b>Above Grade Living Area</b>		<b>Finished Basement Area</b>		<b>Property Land Area</b>		<b>County Use</b>	
						2.2400 AC			
<b>Stories</b>	<b>Basement</b>	<b>Type</b>	<b>Exterior</b>	<b>Full/Half Bath</b>	<b>Garage</b>	<b>Last Major Renovation</b>			
Value Information									
		<b>Base Value</b>		<b>Value</b>		<b>Phase-in Assessments</b>			
				As of		As of		As of	
				01/01/2017		07/01/2018		07/01/2019	
<b>Land:</b>		262,400		262,400					
<b>Improvements</b>		0		0					
<b>Total:</b>		262,400		262,400		262,400		262,400	
<b>Preferential Land:</b>		0						0	
Transfer Information									
<b>Seller:</b> SCHERER CAROL ANN REVOCABLE TRUST				<b>Date:</b> 11/22/2016			<b>Price:</b> \$245,000		
<b>Type:</b> ARMS LENGTH VACANT				<b>Deed1:</b> /17273/ 00213			<b>Deed2:</b>		
<b>Seller:</b> SCHERER J OTTO JR AND WF				<b>Date:</b> 11/08/2005			<b>Price:</b> \$0		
<b>Type:</b> NON-ARMS LENGTH OTHER				<b>Deed1:</b> /09622/ 00293			<b>Deed2:</b>		
<b>Seller:</b>				<b>Date:</b>			<b>Price:</b>		
<b>Type:</b>				<b>Deed1:</b>			<b>Deed2:</b>		
Exemption Information									
<b>Partial Exempt Assessments:</b>		<b>Class</b>		07/01/2018		07/01/2019			
<b>County:</b>		000		0.00					
<b>State:</b>		000		0.00					
<b>Municipal:</b>		000		0.00 0.00		0.00 0.00			
<b>Tax Exempt:</b>		<b>Special Tax Recapture:</b>							
<b>Exempt Class:</b>		NONE							
Homestead Application Information									