

APPLICATION

A 26968

P _____

SEWAGE DISPOSAL TESTING

STATE OF MARYLAND - DEPARTMENT OF HEALTH AND MENTAL HYGIENE 1000 gallons

HOWARD COUNTY HEALTH DEPARTMENT
ENVIRONMENTAL HEALTH SERVICES

P. O. BOX 476, ELLICOTT CITY, MARYLAND 21043
TELEPHONE: 465-5000, EXT. 356

Recorded
10/17/77
9:30 A.M.
10/20/77

Septic Tank { 1-3 Bedrooms }
 { 4 Bedrooms } 1250 gallons
DATE 10/28, 1977

Dry well to have 160 sq. ft. effective
absorbent sidewall area per bedroom below
first 5 1/2' of original soil. Cased in at 4' and maximum
depth 12'. Location per plat 100' from line
being 1462 feet in length. (Per hole 7+8)
and 300' from front property line when facing lot
from R/W in to lot.

TO: THE COUNTY HEALTH OFFICER
ELLICOTT CITY, MARYLAND

I, HEREBY, APPLY FOR THE NECESSARY TEST IN ORDER TO CONSTRUCT (OR RECONSTRUCT) A SEWAGE
DISPOSAL SYSTEM.

on if dry well + trench need
need: ① 5' earth
 buffer between
 dry well + trench

PROPERTY OWNER B. Duke Mitchell
ADDRESS 2185 Daisy Rd

PHONE _____

PROPERTY LOCATION:

SUBDIVISION no LOT NO. _____

ROAD AND DESCRIPTION direction Rt. 70 west to Bushon Pt. Right on 144 - left on DAISY
Road - about 1/2 mile on left -
and after stone
marked.

SIZE OF LOT 42 1/2 acres m/c TYPE BLDG. 300 4 bedrooms
NUMBER OF BEDROOMS

IF NOT SINGLE RESIDENCE DESCRIBE _____

THE SYSTEM INSTALLED UNDER THIS APPLICATION IS ACCEPTABLE ONLY UNTIL PUBLIC
FACILITIES BECOME AVAILABLE.

SIGNATURE OF APPLICANT [Signature]


APPROVED BY C. B. Streaker FOR Dry well; 4/00 DATE 11/8/77
(KIND OF SYSTEM) Dry well + trench

REJECTED BY _____ FOR _____ DATE _____
(KIND OF SYSTEM)

HOLD PENDING FURTHER TESTS _____ DATE _____

REASONS FOR REJECTION OR HOLDING for further tests.
10/20/77 Further tests ran - hold for C.B.S. - certified poles.
11/8/77 Plans ch. by F.F. C.B.S.

THIS IS NOT A PERMIT

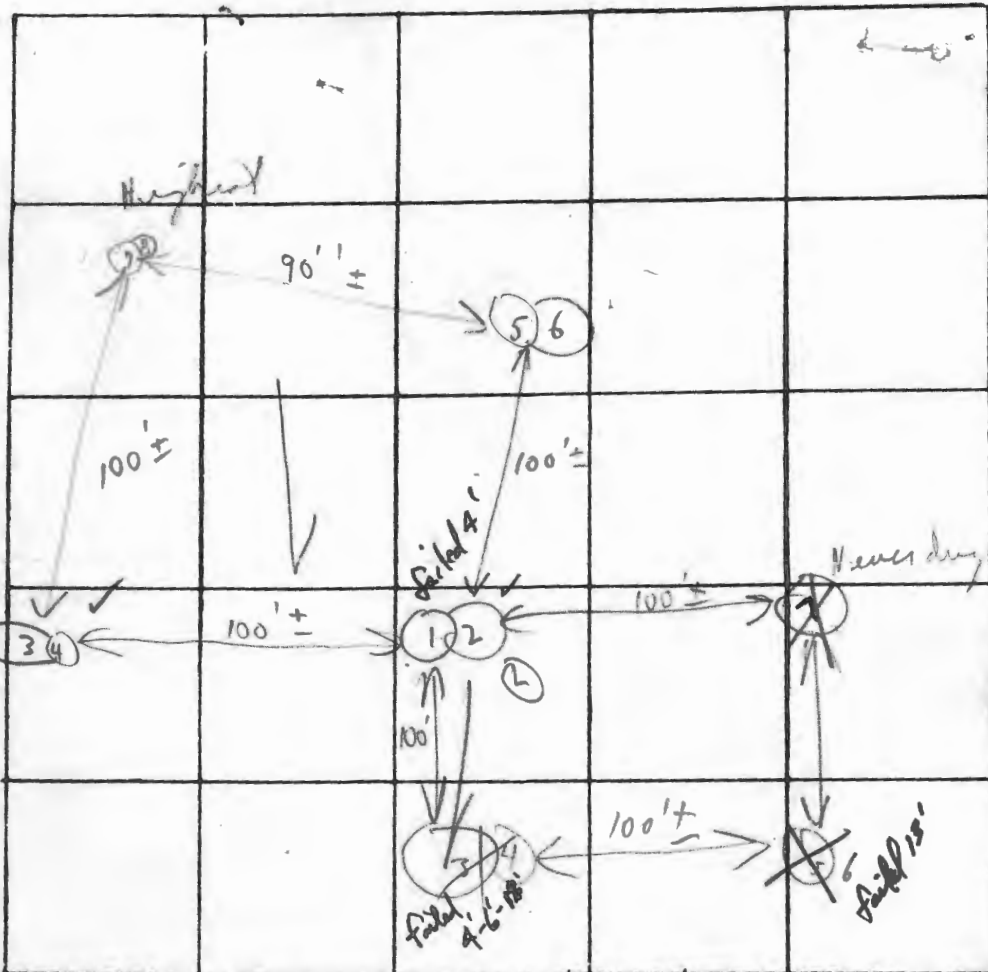

(160 sq ft.)

INDICATE NORTH. NAME ADJOINING ROADWAY AS BASE LINE
 12/20/77 4 s 13 1/2' 10:54 10:56 10:56 11:01 19m 312m
 8 x D 12' 10:54 10:56 10:56 11:01 5m

DATE	TEST NO.	DEPTH	PRE-WET		TEST - 1" DROP		TIME
			START	STOP	START	STOP	
10/20/77	1 A	4'	2:54	3:02	3:02	1.536 3/4"	
	2	12'	2:50	2:53	2:53	2:58	5m
	3 A	4'	3:02	3:09	3:09	3:12	7m
	4	4'	3:02	3:05	3:05	3:12	7m
	5	X	X	X	X	X	X
	6	X	X	X	X	X	X
	7	X	X	X	X	X	X
	8	X	X	X	X	X	X
	3 B	6'	4:02	4:13	4:13	4:46	3/p"
10/20	1 B	5 1/2'	10:25	10:31	10:31	10:43	12m
	2	4'	10:36	10:43	10:43	10:50	15m
	4	12'	10:37	10:39	10:39	10:42	3m
	5	4 1/2'	10:47	10:50	10:50	10:57	9m
	6	12 1/2'	10:46	10:49	10:49	10:51	9m

Possible lower shelf


3:55 little more

Soil Profile

Below clay

Test 10/20

REMARKS: 14' 10/20/77 (5+6) + (3+4) similar elevation between (N+L)
 TYPE OF SOIL: Heavy woods
 TESTED BY: C.A.D. ALSO PRESENT: Dickson

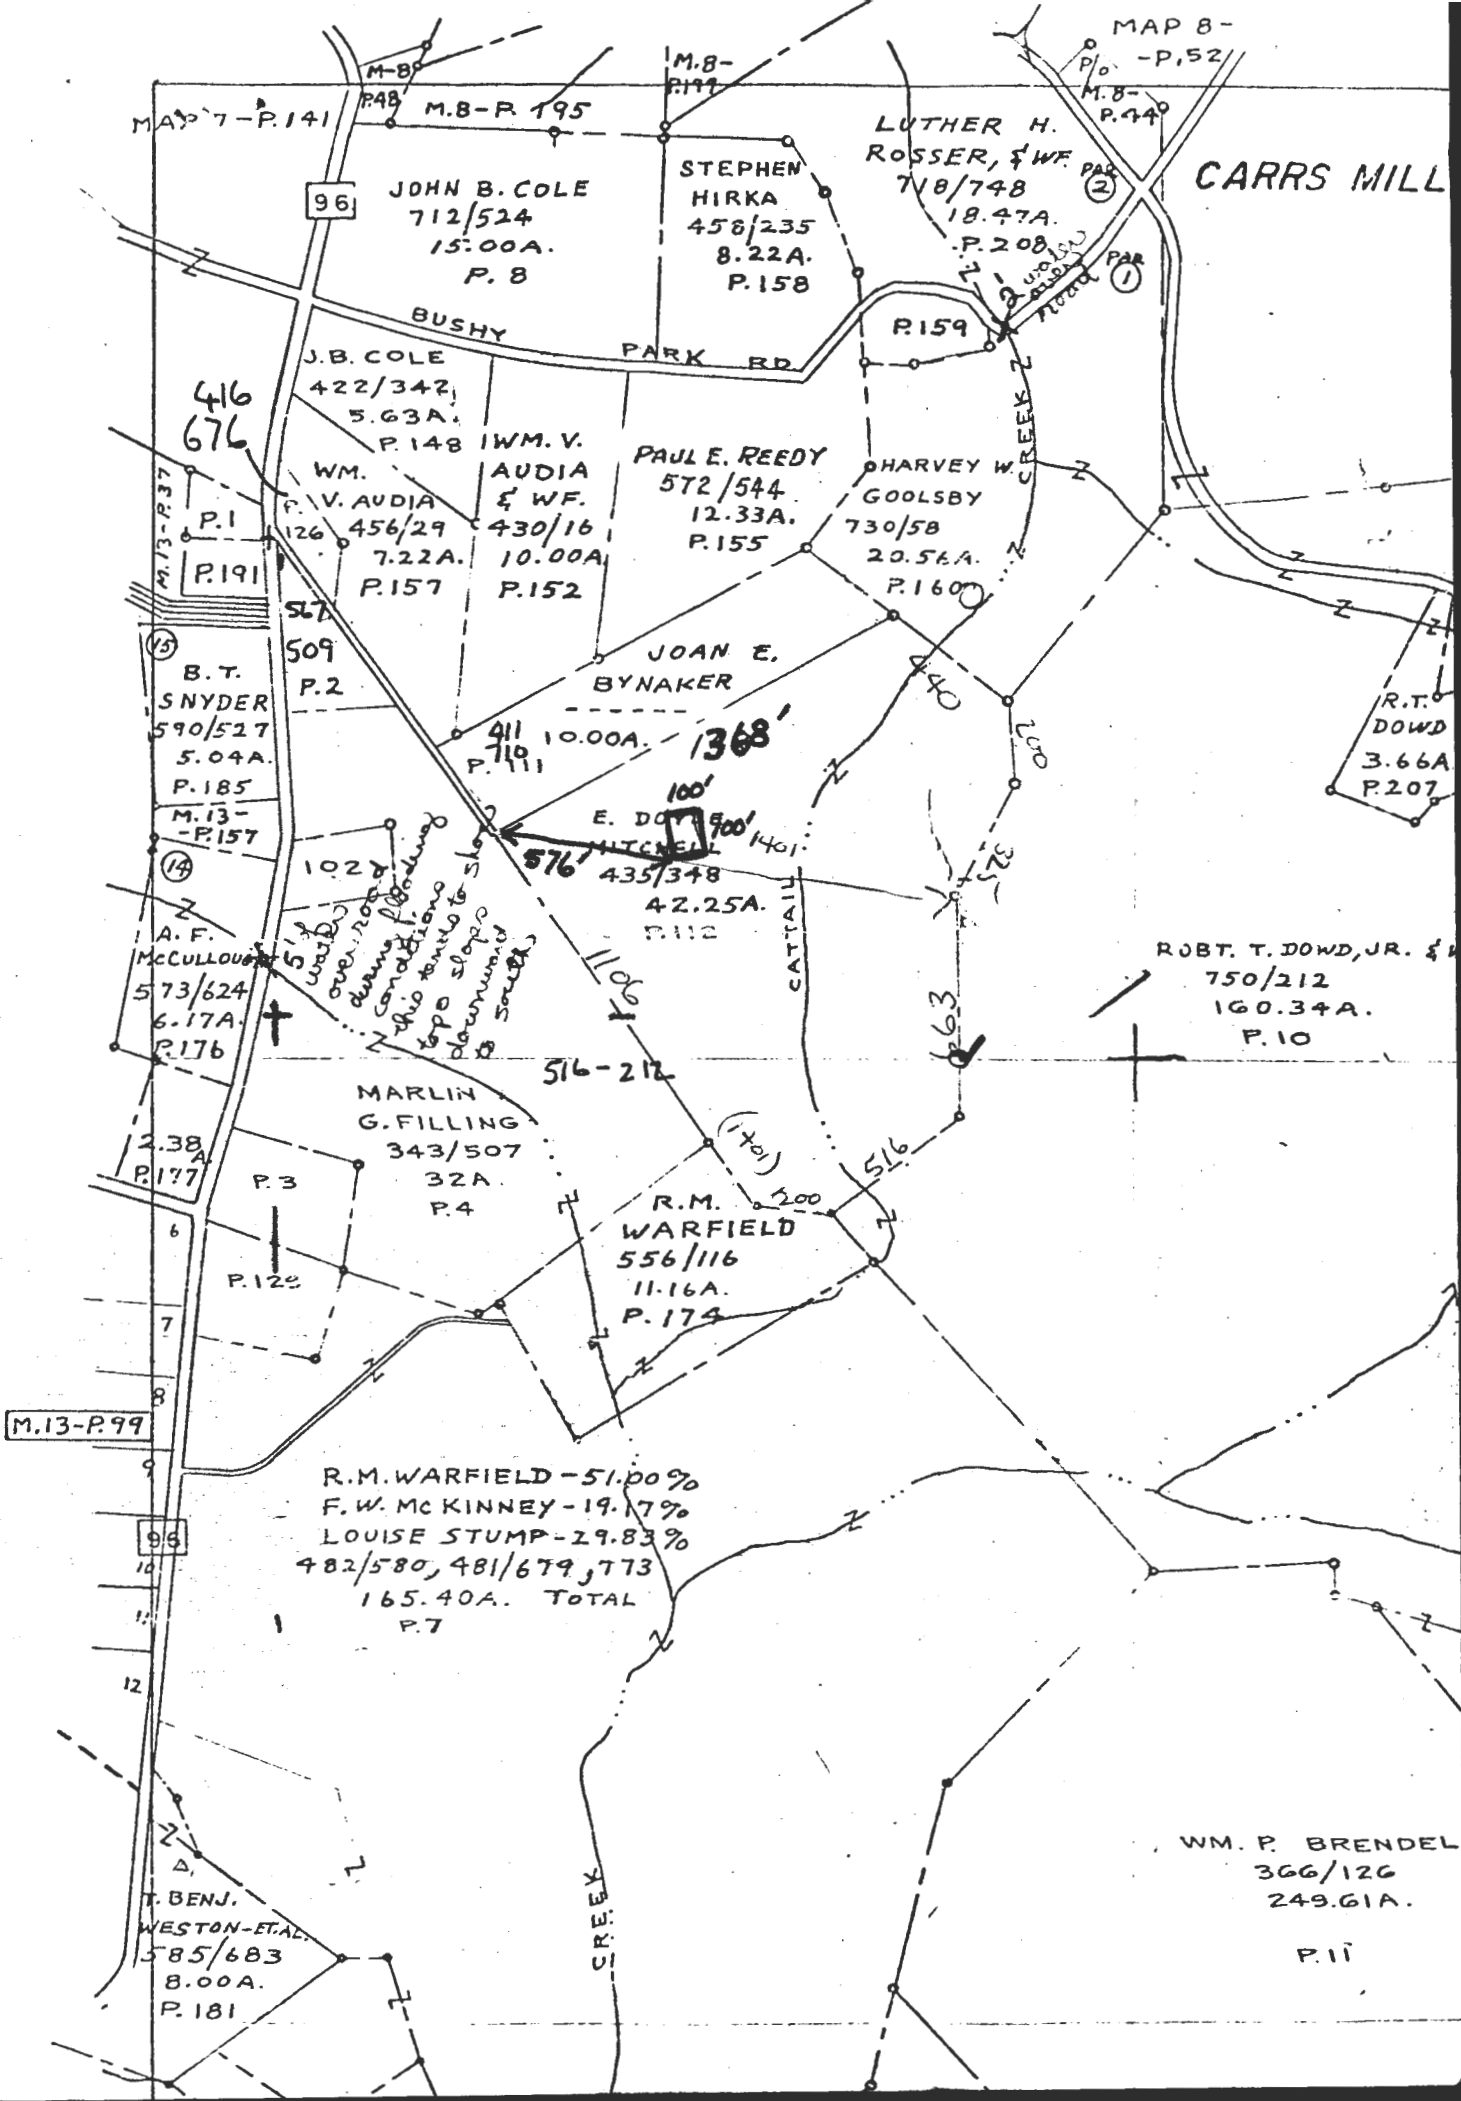

MAP 7 - P. 141

MAP 8 - P. 52

JOHN B. COLE
712/524
15.00A.
P. 8

STEPHEN HIRKA
458/235
8.22A.
P. 158

LUTHER H. ROSSER, & WF
718/748
18.47A.
P. 208

CARRS MILL

96

BUSHY PARK RD

P. 159

416
676

J.B. COLE
422/342
5.63A.
P. 148

WM. V. AUDIA
456/29
7.22A.
P. 157

PAUL E. REEDY
572/544
12.33A.
P. 155

HARVEY W. GOOLSBY
730/58
20.56A.
P. 160

P. 1

P. 191

B.T. SNYDER
590/527
5.09A.
P. 185

13

14

M. 13 - P. 157

A.F. McCULLOUGH
573/624
6.17A.
P. 176

2.38
P. 177

P. 3

P. 125

M. 13 - P. 99

96

R.M. WARFIELD - 51.00%
F.W. MCKINNEY - 19.17%
LOUISE STUMP - 29.83%
482/580, 481/679, 773
165.40A. TOTAL
P. 7

CREEK

T. BENJ. WESTON-ETAL
585/683
8.00A.
P. 181

WM. P. BRENDEL
366/126
249.61A.
P. 11

*new road
during flooding
conditions
topo slope to
be planned
south*

1368'

E. DON MITCHELL
435/348
42.25A.
P. 112

516-212

R.M. WARFIELD
556/116
11.16A.
P. 174

ROBT. T. DOWD, JR. & W
750/212
160.34A.
P. 10

R.T. DOWD
3.66A.
P. 207

10

11

12


249

250

251


252

253

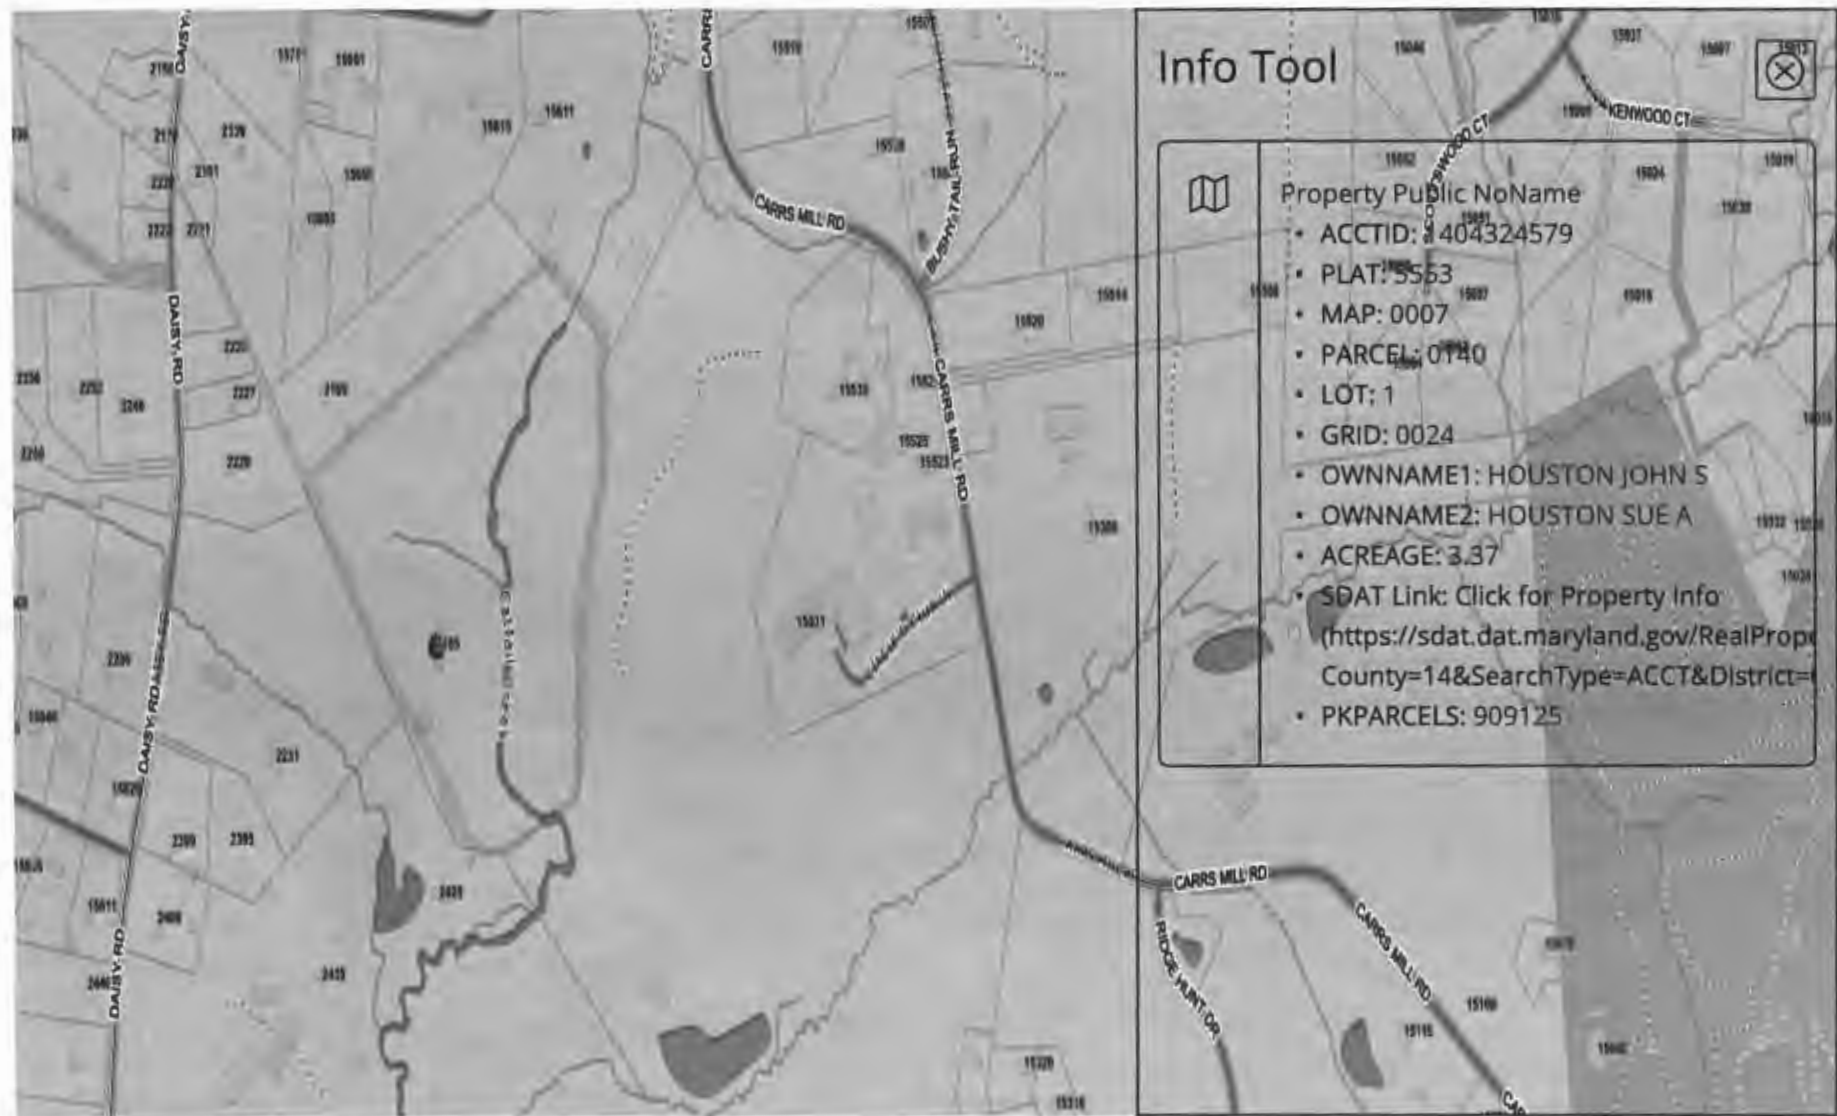


2185 DAISY RD

Info Tool



Property Public NoName


- ACCTID: 1404324579
- PLAT: 5553
- MAP: 0007
- PARCEL: 0140
- LOT: 1
- GRID: 0024
- OWNNAME1: HOUSTON JOHN S
- OWNNAME2: HOUSTON SUE A
- ACREAGE: 3.37
- SDAT Link: Click for Property Info
(<https://sdat.dat.maryland.gov/RealProp...>
County=14&SearchType=ACCT&District=
- PKPARCELS: 909125

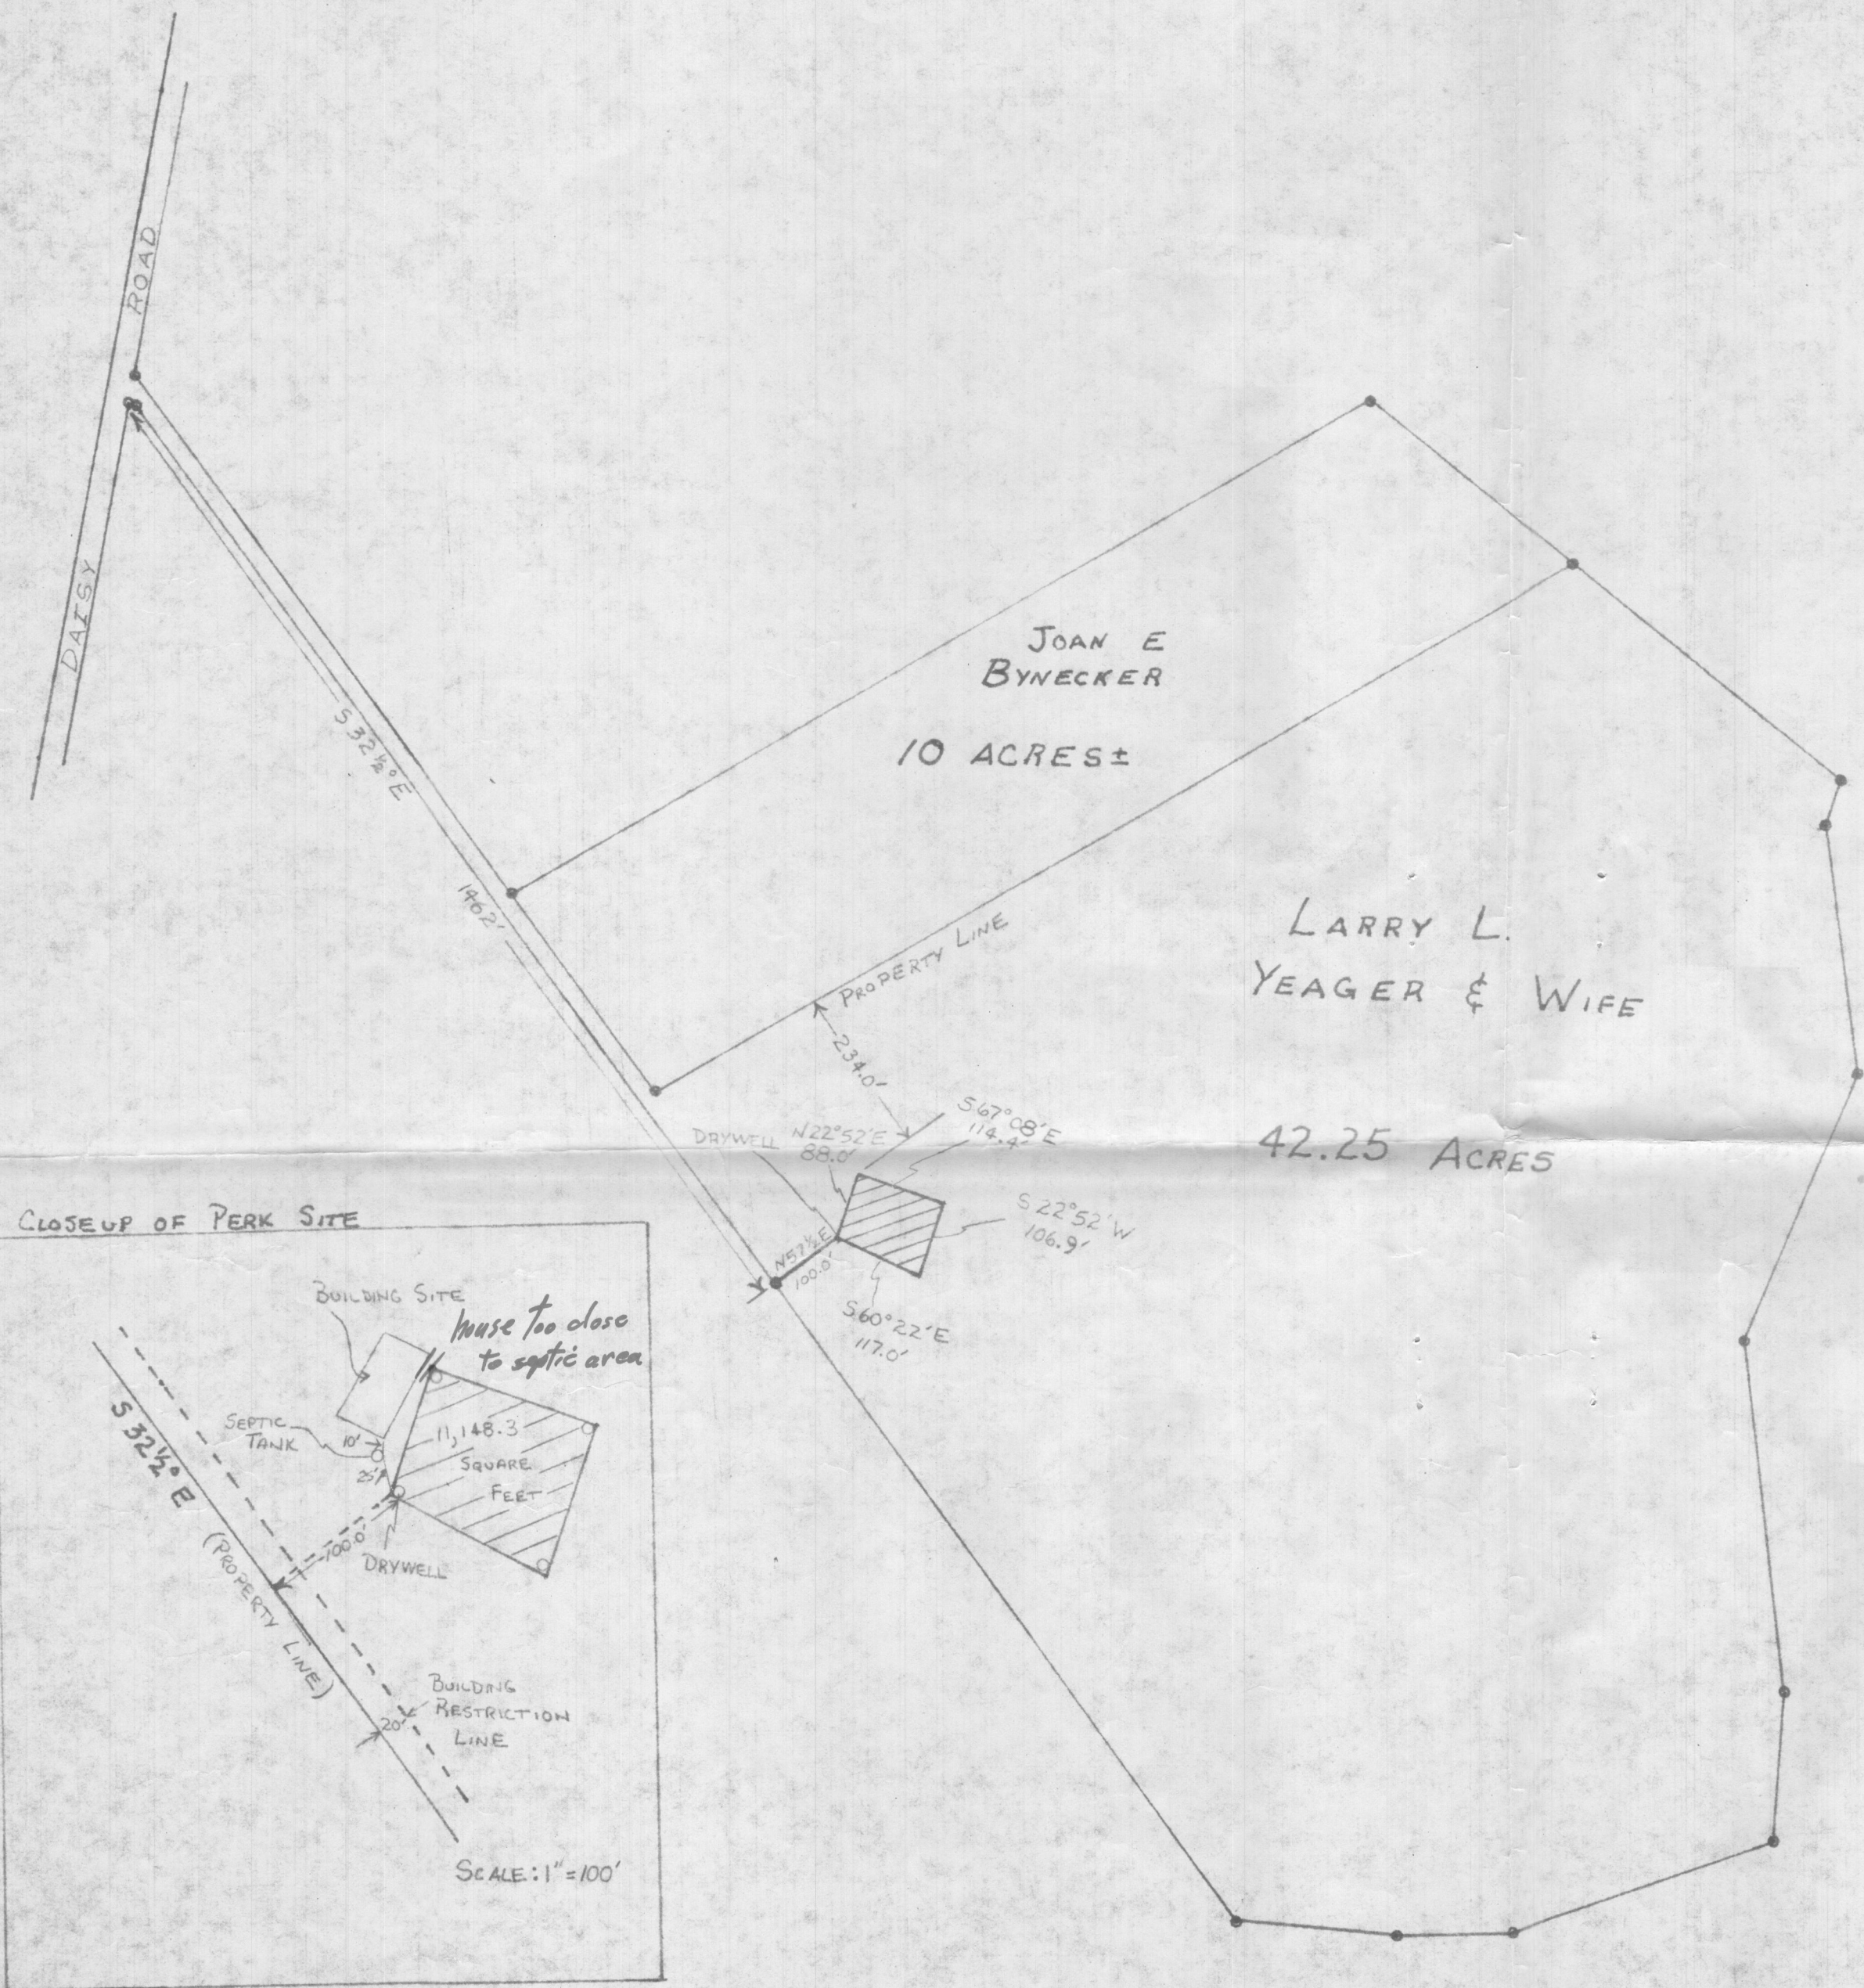

NOTES:

- 1) PERK HOLE FIELD LOCATED AS SHOWN. SHADED AREA COMPRISES 11,148.3 FT.² OF SEWAGE DISPOSAL AREA.
- 2) THIS LOT MEETS THE MINIMUM OWNERSHIP REQUIREMENTS OF THE MD. STATE DEPT. OF HEALTH & MENTAL HYGIENE IN REGARD TO PRIVATE WATER AND PRIVATE SEWAGE DISPOSAL.
- 3) INSET SCALE IS DIFFERENT FROM MAIN DRAWING.
- 4) PERK SITE MEETS ALL SETBACK REGULATIONS


SCALE: 1" = 200 FT.

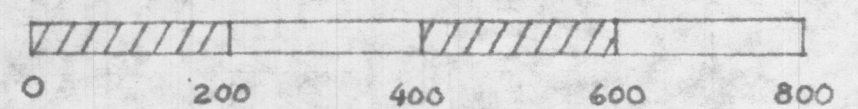

I CERTIFY THE ABOVE MEASUREMENTS AND ELEVATIONS ARE ACTUAL & CORRECT FOR THIS PROPERTY

SIGNED: Larry L. Yeager

442-2620

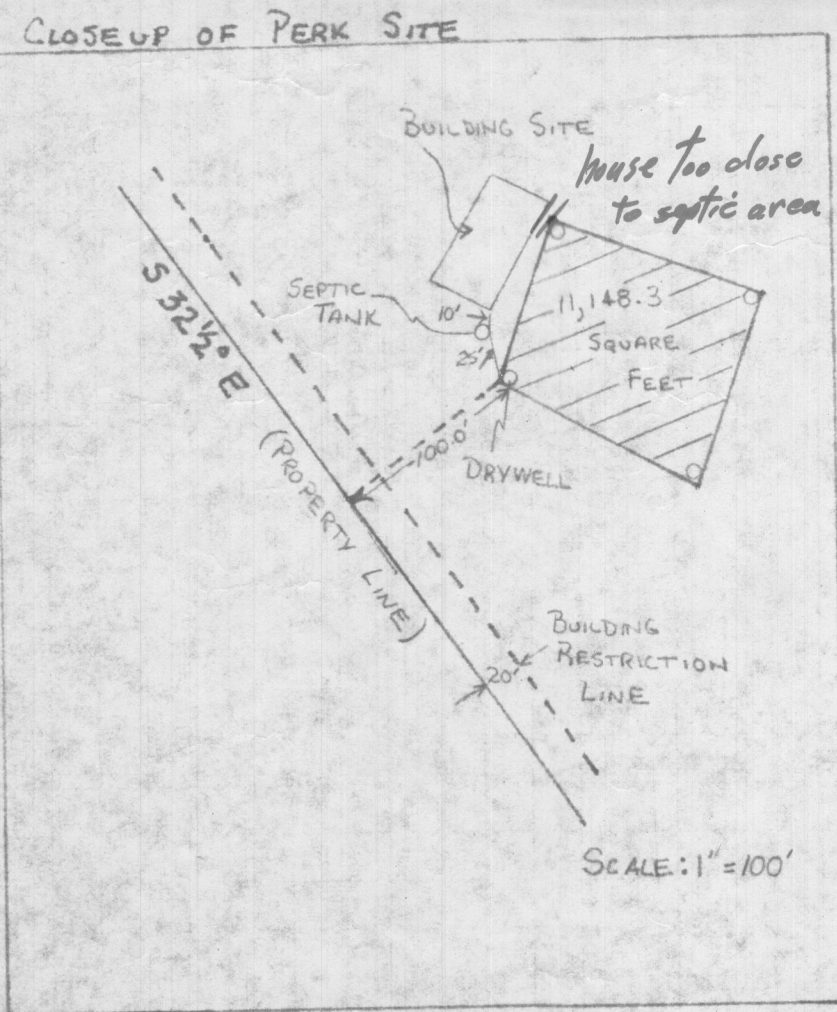

APPROVED BY: _____
 HEALTH OFFICER

Maryland Department of Assessments and Taxation Real Property Data Search (vw4.2A) HOWARD COUNTY	Go Back View Map New Search GroundRent Redemption GroundRent Registration
--	---

Account Identifier: District - 04 Account Number - 323114

Owner Information

Owner Name:	MATTINGLY BRIAN A MATTINGLY CONNIE S T/E	Use:	AGRICULTURAL
Mailing Address:	2185 DAISY RD WOODBINE MD 21797-8405	Principal Residence:	NO
		Deed Reference:	1)/07757/ 00294 2)

Location & Structure Information

Premises Address	Legal Description
2185 DAISY RD WOODBINE 21797-0000	37.6810 A 2185 DAISY ROAD MATTINGLY PROPERTY CEO

Map	Grid	Parcel	Sub District	Subdivision	Section	Block	Lot	Assessment Area	Plat No:	18219
0014	0001	0112		0000				2	Plat Ref:	

Special Tax Areas	Town	NONE
	Ad Valorem	100
	Tax Class	

Primary Structure Built	Enclosed Area	Property Land Area	County Use
2007	6,126 SF	37.6800 AC	

Stories	Basement	Type	Exterior
2.000000	YES	STANDARD UNIT FRAME	

Value Information

	Base Value	Value	Phase-in Assessments		
		As Of	As Of	As Of	PREFERENTIAL LAND VALUE
		01/01/2011	07/01/2011	07/01/2012	INCLUDED IN LAND VALUE
Land	319,370	219,300			
Improvements:	1,182,730	860,400			
Total:	1,502,100	1,079,700	1,079,700	1,079,700	
Preferential Land:	6,870			6,800	

Transfer Information

Seller:	SELFRIDGE BUILDERS INC	Date:	10/29/2003	Price:	\$625,000
Type:	ARMS LENGTH VACANT	Deed1:	/07757/ 00294	Deed2:	
Seller:	RIDGE VIEW LLC	Date:	09/30/2002	Price:	\$500,000
Type:	ARMS LENGTH VACANT	Deed1:	/06461/ 00379	Deed2:	
Seller:	YEAGER LARRY L	Date:	04/23/2002	Price:	\$500,000
Type:	NON-ARMS LENGTH OTHER	Deed1:	/06135/ 00400	Deed2:	

Exemption Information

Partial Exempt Assessments	Class	07/01/2011	07/01/2012
County	000	0.00	
State	000	0.00	
Municipal	000	0.00	0.00

Tax Exempt:	Special Tax Recapture:
Exempt Class:	AGRICULTURAL TRANSFER TAX FCMA PENALTY

Homestead Application Information

Homestead Application Status: No Application