

**Bureau of Environmental Health**  
 8930 Stanford Boulevard, Columbia, MD 21045  
 Main: 410-313-2640 | Fax: 410-313-2648  
 TDD 410-313-2323 | Toll Free 1-866-313-6300  
[www.hchealth.org](http://www.hchealth.org)  
 Facebook: [www.facebook.com/hocohealth](http://www.facebook.com/hocohealth)

Maura J. Rossman, M.D., Health Officer

RECEIPT DATE: 5/7/18

**ONSITE SEWAGE DISPOSAL SYSTEM**

P 562986

INSTALLATION APPROVAL DATE: 11/13/18 *(Kmw)*

**PERMIT**

A \_\_\_\_\_

**SEWER HOUSE CONNECTION**

PROPERTY ADDRESS: 5026 Crape Myrtle Court

SUBDIVISION: Walnut Creek LOT: 155 TAX ID: 05-598908

CONTRACTOR: Craftmark Homes EMAIL: jpavlik@craftmarkhomes.com

CONTRACTOR ADDRESS: 1355 Beverly Road Suite 300, McClean VA, 22101 PHONE: 703-932-0573

PROPERTY OWNER: NVR Inc. EMAIL: \_\_\_\_\_

OWNER ADDRESS: 9720 Patuxent Woods Road, Columbia, MD 21046 PHONE: 410-379-5956

NUMBER OF BEDROOMS: 5 CONNECTED TO PUBLIC WATER:  YES  NO

LOCATION:	INSTALL 4" SEWER LINE PER APPROVED SITE PLAN.
NOTES:	<i>Sleeve SAC under driveway. rB</i>


ISSUED BY: Dana Bernard ISSUE DATE: 5/7/18 EXPIRATION DATE: 5/7/19

- NOTE: HOWARD COUNTY BUREAU OF UTILITIES APPROVAL OF GRINDER PUMP INSTALLATION IS REQUIRED PRIOR TO SEPTIC PERMIT APPROVAL
- NOTE: CONTRACTOR MUST SCHEDULE AN INSPECTION AND GAIN APPROVAL OF ALL COMPONENTS PRIOR TO COVERING
- NOTE: AN ELECTRICAL PERMIT IS REQUIRED FOR INSTALLATION OF ANY ELECTRICAL COMPONENTS OF THE SYSTEM

**NEITHER THE HOWARD COUNTY COUNCIL NOR THE HEALTH DEPARTMENT IS RESPONSIBLE FOR THE SUCCESSFUL OPERATION OF ANY SYSTEM. PERMITTEE RESPONSIBLE FOR OBTAINING FINAL APPROVAL ON THIS PERMIT. CALL 410-313-1771 FOR INSPECTION OF SEPTIC SYSTEM.**

NOT TO SCALE

1" = 30'

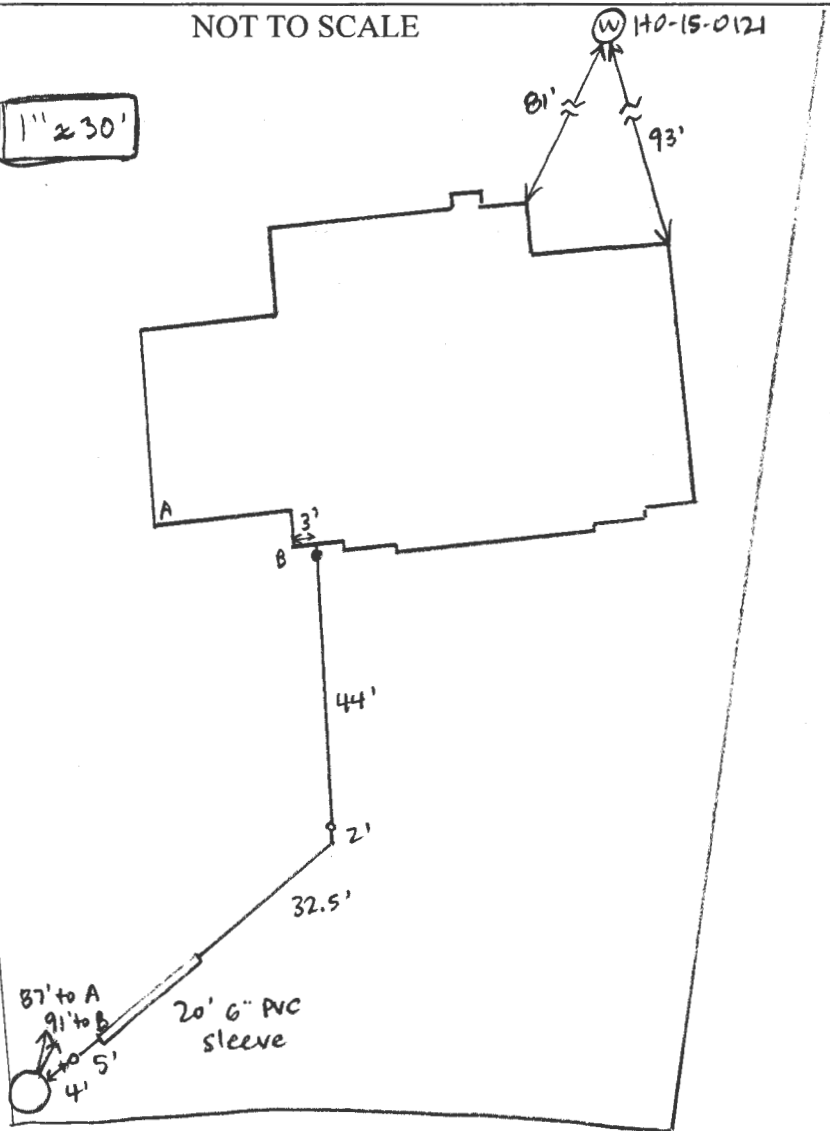

ROAD NAME

**TRENCH/DRAINFIELD DATA**

	WIDTH	INLET	BOTTOM
NUMBER OF TRENCHES	_____	_____	_____
TOTAL LENGTH	_____	_____	_____
ABSORPTION AREA	_____	_____	_____
DISTRIBUTION BOX LEVEL	_____	_____	_____
DISTRIBUTION BOX BAFFLE	_____	_____	_____
DISTRIBUTION BOX PORT	_____	_____	_____

**SEPTIC TANK DATA**

**SEPTIC TANK 1 LEVEL** \_\_\_\_\_

MANUFACTURER \_\_\_\_\_

CAPACITY \_\_\_\_\_ GAL

SEAM LOC \_\_\_\_\_

TANK LID DEPTH \_\_\_\_\_

BAFFLES \_\_\_\_\_

BAFFLE FILTER \_\_\_\_\_

MANHOLE LOC \_\_\_\_\_

6" PORT LOC \_\_\_\_\_

WATERTIGHT TEST \_\_\_\_\_

SLOTTED \_\_\_\_\_

DATE ON LID \_\_\_\_\_

**PUMP/SEPTIC TANK LEVEL** \_\_\_\_\_

MANUFACTURER \_\_\_\_\_

CAPACITY \_\_\_\_\_ GAL

SEAM LOC \_\_\_\_\_

TANK LID DEPTH \_\_\_\_\_

BAFFLES \_\_\_\_\_

BAFFLE FILTER \_\_\_\_\_

MANHOLE LOC \_\_\_\_\_

6" PORT LOC \_\_\_\_\_

WATERTIGHT TEST \_\_\_\_\_

SLOTTED \_\_\_\_\_

DATE ON LID \_\_\_\_\_

PRE-CONSTRUCTION:

\_\_\_\_\_


\_\_\_\_\_

\_\_\_\_\_

\_\_\_\_\_

INSTALLATION: 7/3/18 Connection to grinder pit complete. Line bedded w/ #57 stones tracer wire laid over pipe. Tull to add screw caps to clo's at final grading. 6" PVC sleeve installed under future driveway. Need approval from Bureau of Utilities for grinder pump startup. (SC) Startup certification rec'd from DPW. (Krow)

FINAL INSPECTOR

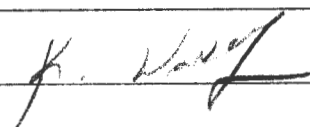

DATE OF APPROVAL

11/13/18

**Wolf, Kevin**

---

**From:** Bozzell, Duane  
**Sent:** Tuesday, November 13, 2018 8:31 AM  
**To:** Miscbilling  
**Cc:** Hart, Amy; Rocco, Anthony; Martin, Sharhonda; Williams, Jeffrey; Bozzell, Duane; Bernard, Dana; Wolf, Kevin; Collins, Sarah; John Pavlik  
**Subject:** U&O Release 5026 crape myrtle lot 155

On the morning of 11-17-2018 observed the start-up of a Sewage Grinder Pump at the Walnut Creek Shared Septic System:  
Contract#

Lot #155  
5026 Crape Myrtle ct.  
Ellicott City MD. 21042

The Sewage Grinder Pump test was successful; the Bureau of Utilities releases its hold on this property for U&O.

*Thank You.*

*Duane Bozzell*  
**J.N.C.COM**  
*DPW-Bureau of utilities*  
**Phone: (410)313-4900**  
**Fax: (410)313-4989**

WALNUT CREEK  
PHASE FOUR  
NON-BUILDABLE  
PARCELS  
REVISION TO  
PRESERVATION TO  
BUILDABLE BULK  
PARCELS  
PLAT NOS. 23611  
FIFTH ELECTION  
THRU  
HOWARD COUNTY

N 56° 10' 31" W  
10' B.R.L.  
270.00'

LOT 155  
SEE DETAIL  
10' B.R.L.  
263.47  
10' B.R.L.  
10.3'

30.0' ±

wall check  
'OK'

50' B.R.L.  
5/7/18

10'x10' Public Sewer  
& Utility Easement

R=460.00'  
L=103.73'

Crape Myr

Public Access  
Place


LOT 155  
WALNUT CREEK  
PHASE FOUR  
NON-BUILDABLE  
PARCELS 'W' AND  
PRESERVATION TO  
BUILDABLE BULK  
PARCELS 'L'  
PLAT NOS. 23611  
FIFTH ELECTION  
THRU  
HOWARD COUNTY




**GENERAL NOTES:**

- 1) THIS LOCATION DRAWING IS PREPARED FOR THE BENEFIT OF THE CLIENT SIGNING THE HOUSE LOCATION SURVEY APPROVAL FORM INSOFAR AS IT IS REQUIRED BY A LENDER OR TITLE INSURANCE COMPANY OR ITS AGENTS IN CONNECTION WITH THE CONTEMPLATED TRANSFER, FINANCING OR REFINANCING OF THE PROPERTY SHOWN HEREON. UNLESS INDICATED AS BEING A BOUNDARY SURVEY, THIS LOCATION DRAWING IS NOT INTENDED FOR USE IN THE ESTABLISHMENT OF PROPERTY LINES AND IS NOT TO BE RELIED UPON FOR THE ESTABLISHMENT OR LOCATIONS OF FENCES, GARAGES, BUILDINGS OR OTHER EXISTING OR FUTURE IMPROVEMENTS. AS A RESULT, THIS LOCATION DRAWING DOES NOT PROVIDE FOR ACCURATE IDENTIFICATION OF PROPERTY LINES, BUT SUCH IDENTIFICATION MAY NOT BE REQUIRED FOR THE TRANSFER OF TITLE OR SECURING FINANCING FOR RE-FINANCING.
- 2) SUBJECT PROPERTY IS SHOWN IN ZONE X ON THE NATIONAL FLOOD INSURANCE PROGRAM FLOOD INSURANCE RATE MAP OF HOWARD COUNTY, MARYLAND, COMMUNITY PANEL No. 24027C01300 EFFECTIVE NOV. 6, 2013.
- 3) THE OFFSETS FROM BUILDING LINE TO PROPERTY LINE AS SHOWN ON THE PLAT HEREON ARE TO AN ACCURACY OF PLUS OR MINUS 0.3'
- 4) NO TITLE REPORT FURNISHED. SUBJECT TO ALL EASEMENTS, RIGHTS OF WAY AND CONDITIONS OF RECORD.
- 5) THE EXISTING WELL(S) SHOWN ON THIS PLAN (IDENTIFIED WITH THE ATTACHED WELL TAG NUMBER HO-15-0121 HAS BEEN FIELD LOCATED BY FISHER, COLLINS AND CARTER, INC. PROFESSIONAL LAND SURVEYORS AND IS ACCURATELY SHOWN.
- 6) PROFESSIONAL CERTIFICATION: I HEREBY CERTIFY THAT THESE DOCUMENTS WERE PREPARED BY ME OR UNDER MY RESPONSIBLE CHARGE, AND THAT I AM A DULY LICENSED PROPERTY LINE SURVEYOR UNDER THE LAWS OF THE STATE OF MARYLAND, LICENSE NO. 339, EXPIRATION DATE 10/04/2018.
- 7) LOTS 115 THRU 159 WILL BE SERVED BY LOW PRESSURE SEWER SYSTEM WITH A LIMIT OF (5) FIVE BEDROOMS AT 150 GALLONS PER BEDROOM FOR A TOTAL DESIGN FLOW OF 33,750 GALLONS PER DAY.
- 8) LOTS 115 THRU 159 OF THIS SUBDIVISION ARE CONNECTED TO THE SHARED SEWAGE DISPOSAL FACILITY GOVERNED BY SECTIONS 18.1200 ET SEQ. OF THE HOWARD COUNTY CODE. THE DEVELOPER IS OBLIGATED TO CONSTRUCT THE FACILITY UNDER THE PROVISION OF THE DEVELOPER AGREEMENT NUMBER 50-4441-D DATED APRIL 8, 2009. A BUILDING PERMIT FOR LOTS 115 THRU 159 MAY NOT BE ISSUED UNTIL THE CONSTRUCTION OF THE FACILITY IS COMPLETED. ACTIVITY ON THESE LOTS IS RESTRICTED AND IS SUBJECT TO THE DECLARATION OF COVENANTS, CONDITIONS, RIGHT-OF-ENTRY, AND RESTRICTION FOR SHARED SEWAGE DISPOSAL FACILITY INTENDED TO BE RECORDED AMONG THE LAND RECORDS OF HOWARD COUNTY, MARYLAND. LOTS 115 THRU 159 SHALL BE ASSESSED SHARED SEWAGE DISPOSAL FACILITY CHARGES AND ASSESSMENTS PURSUANT TO SECTIONS 20.800 ET SEQ. OF THE HOWARD COUNTY CODE.
- 9) BUILDING PERMIT #B-17004406

**Legend**

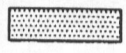 10' Public Tree Maintenance Easement

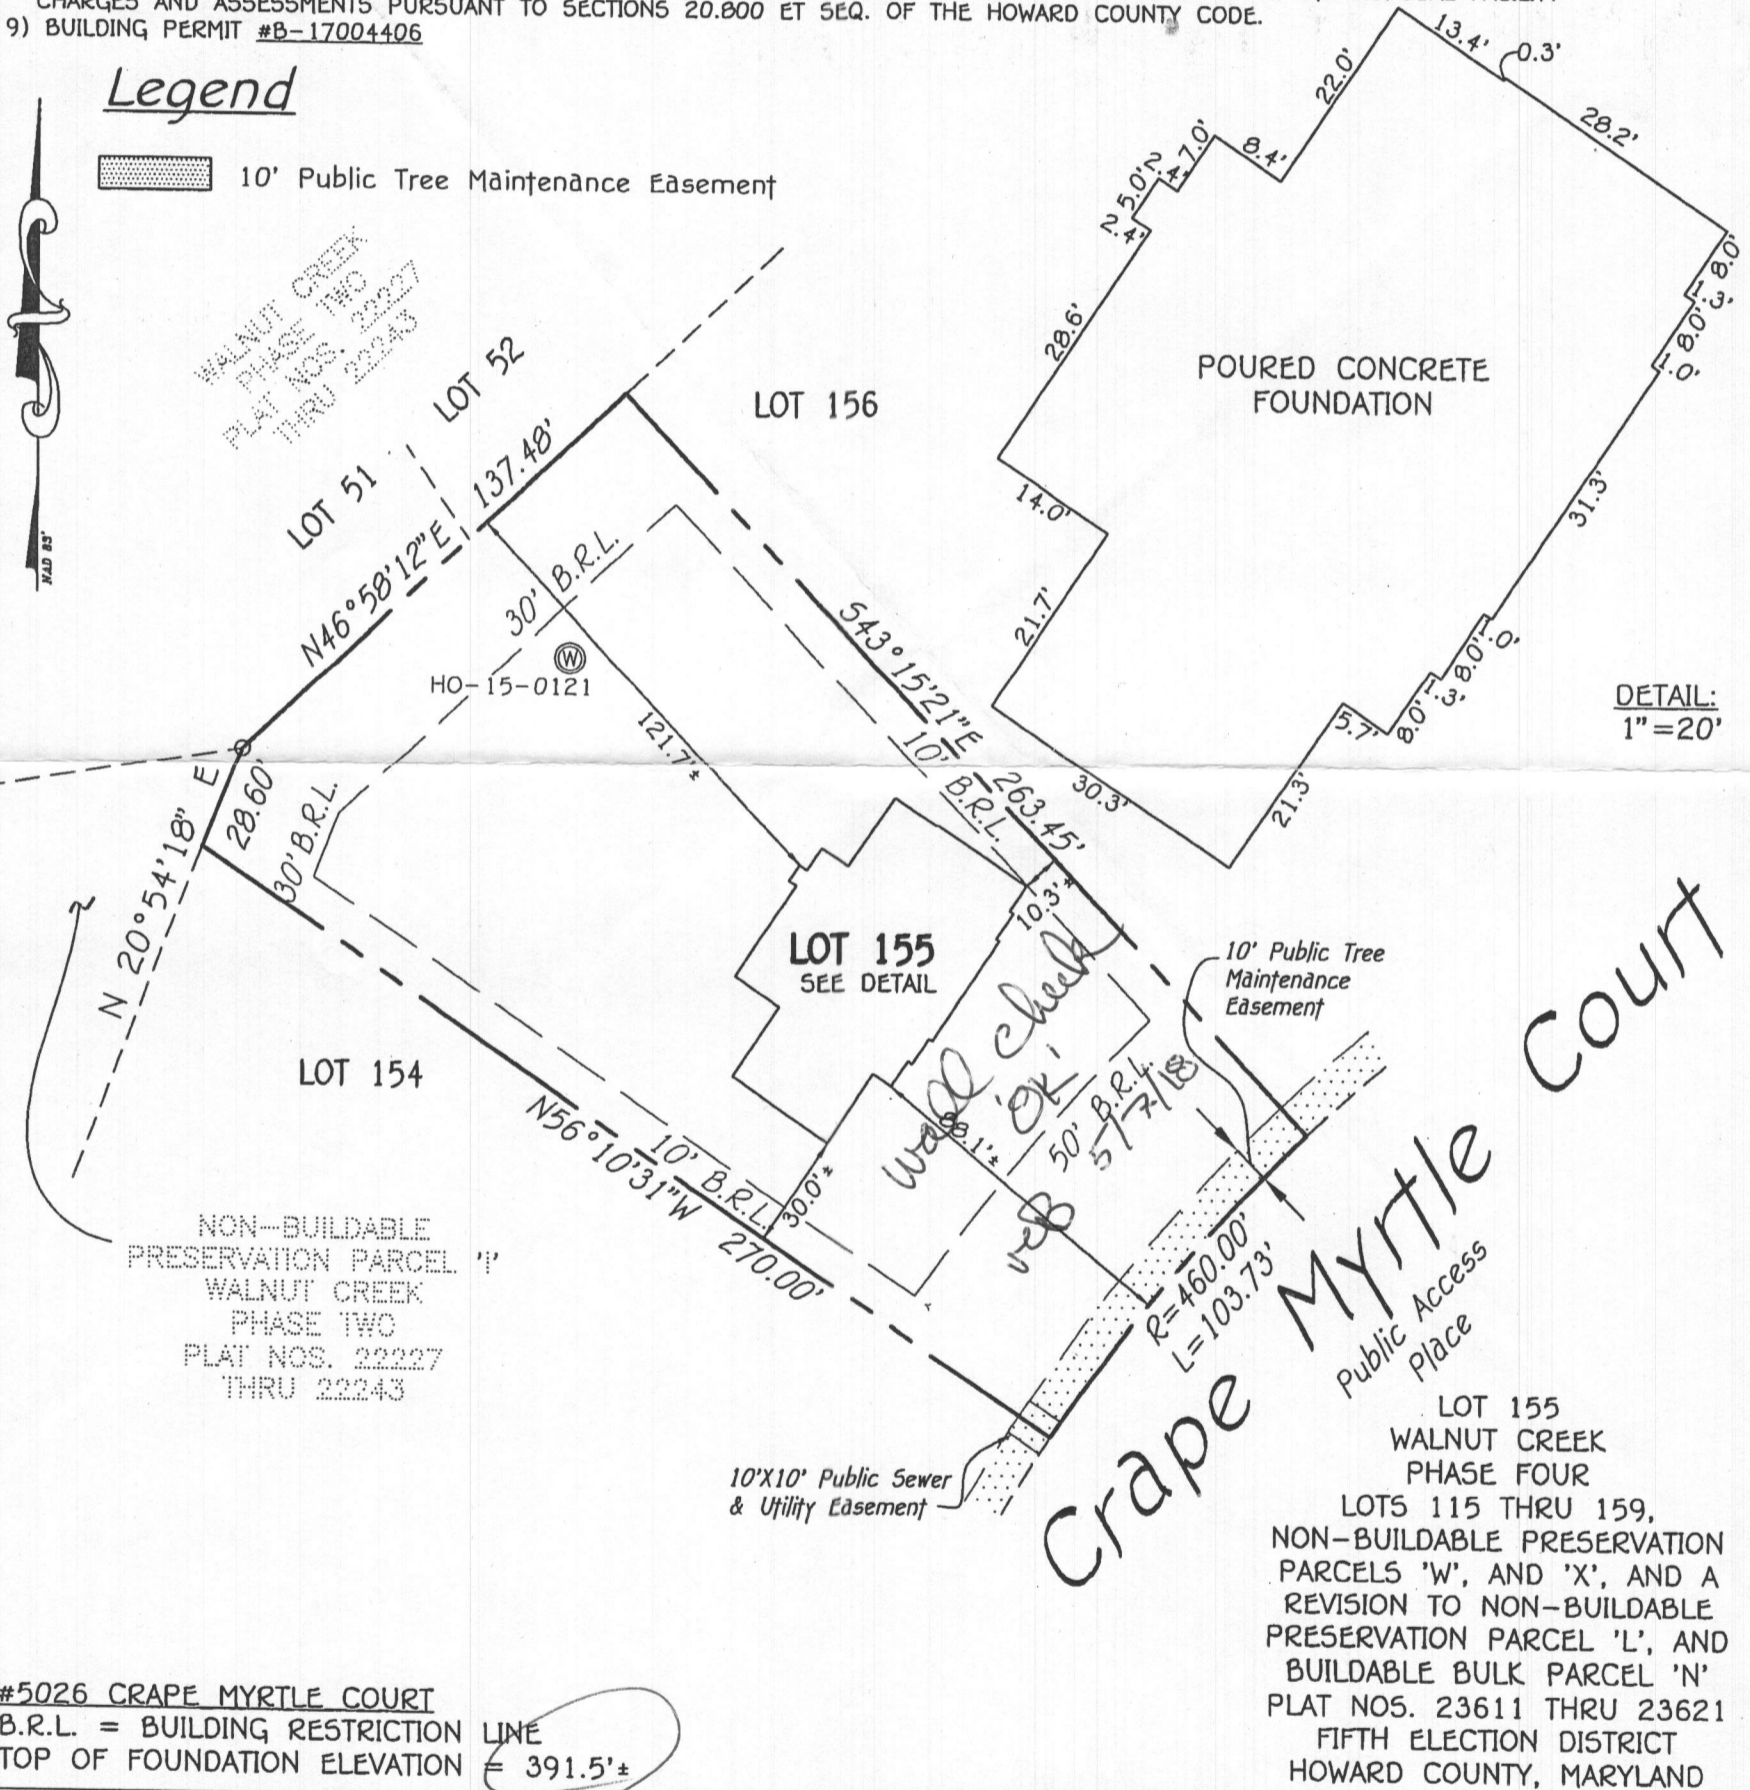

DETAIL:  
1"=20'

NON-BUILDABLE PRESERVATION PARCEL 'W'  
WALNUT CREEK  
PHASE TWO  
PLAT NOS. 22227  
THRU 22243

LOT 155  
WALNUT CREEK  
PHASE FOUR  
LOTS 115 THRU 159,  
NON-BUILDABLE PRESERVATION  
PARCELS 'W', AND 'X', AND A  
REVISION TO NON-BUILDABLE  
PRESERVATION PARCEL 'L', AND  
BUILDABLE BULK PARCEL 'N'  
PLAT NOS. 23611 THRU 23621  
FIFTH ELECTION DISTRICT  
HOWARD COUNTY, MARYLAND

#5026 CRAPE MYRTLE COURT  
B.R.L. = BUILDING RESTRICTION LINE  
TOP OF FOUNDATION ELEVATION = 391.5'±

**FISHER, COLLINS & CARTER, INC.**  
CIVIL ENGINEERING CONSULTANTS & LAND SURVEYORS  
CENTENNIAL SQUARE OFFICE PARK - 10272 BALTIMORE NATIONAL PIKE  
ELLCOTT CITY, MARYLAND 21042  
(410) 461 - 2855

STATE OF MARYLAND  
MARK L. ROBEL  
PROPERTY LINE SURVEYOR  
No. 339  
REG. #339  
Mark L. Robel  
5/02/18  
DATE

**HOUSE LOCATION DRAWING**

FOUNDATION LOCATION: 4/26/18  
FINAL LOCATION: \_\_\_\_\_  
BOUNDARY SURVEY: \_\_\_\_\_

SCALE: 1"=50'  
DATE: 5/2/18  
DRAWN BY: MD  
CHECKED BY: MLR  
PROJECT No.: 04001-3007