

1/11/01
To Follow
Lot 22
1/12/01
10:00

PERMIT *RPS# 363892*

SEWAGE DISPOSAL SYSTEM HOWARD COUNTY HEALTH DEPARTMENT BUREAU OF ENVIRONMENTAL HEALTH

P 514710-F
A 59914-S

410-313-2640
INDEXED

ISSUE DATE 12/13/2000
APPROVAL DATE 1/12/01

Fogle's (Kenny Mayne) - Subcontractor

IS PERMITTED TO INSTALL ALTER

ADDRESS _____ PHONE 410-795-5670

SUBDIVISION Monticello LOT NUMBER 43 ADDRESS 14305 Fox Creek Court

PROPERTY OWNER JAMES SMITH PROPERTY OWNER'S ADDRESS 1370 Piccard Dr. Ste 230

PROPERTY OWNER D-R Horton Custom Homes Rockville, MD 20850

SEPTIC TANK CAPACITY 1250 GALLONS

PUMP CHAMBER CAPACITY N/A GALLONS

NUMBER OF BEDROOMS 4 **** WATERTIGHT SEPTIC TANK REQUIRED ****

SQUARE FEET PER BEDROOM 180

LINEAR FEET OF TRENCH REQUIRED 180

TRENCHES: Trenches to be 2 feet wide. Inlet 2 feet below original grade. Bottom maximum depth 6 feet below original grade. 4 feet of stone below distribution box.

LOCATION: Place the distribution box 175 feet down the left lot line and 95 - 100 feet off this same lot line. Run trenches on contour to left side of lot.
PREFERRED LAYOUT: 2 trenches 90 feet each

PLANS APPROVED Mark Rifkin OK SRK 10/5/00 DATE 9/26/2000

PERMIT VOID AFTER 2 YEARS

NOTE: CONTRACTOR RESPONSIBLE FOR SCHEDULING A PRE-CONSTRUCTION INSPECTION FOR ALL INSTALLATIONS

NOTE: TOP OF SEPTIC TANKS ARE TO BE NO DEEPER THAN 3.0 FEET BELOW FINISH GRADE

NOTE: WATERTIGHT SEPTIC TANKS REQUIRED

NOTE: CLEANOUT REQUIRED EVERY 70 FEET OF SEWER LINE AND/OR AT 90° SWEEPS IN LINES FROM HOUSE TO DRAIN FIELDS, 90° ELBOWS ARE NOT ACCEPTABLE

NOTE: ALL PARTS OF SEPTIC SYSTEMS (I.E. TANK, DISTRIBUTION BOX, DRAINFIELDS) TO BE 100 FEET FROM ANY WATER WELL UNLESS OTHERWISE SPECIFICALLY AUTHORIZED

NOTE: NO ABSORPTION TRENCH TO EXCEED 100 FEET IN LENGTH UNLESS SPECIFICALLY AUTHORIZED

NOTE: ALL PIPE FROM HOUSE TO SEPTIC TANK MUST BE CAST IRON OR SCHEDULE 35/40 PVC OR ABS

NOTE: MANHOLE RISERS REQUIRED ON ALL SEPTIC TANKS AND PUMP CHAMBERS

NOTE: DISTRIBUTION BOXES MUST HAVE BAFFLES

NOTE: IF PUMPED SEPTIC SYSTEM REQUIRED, (1) SEPTIC PUMP DETAIL TO BE PROVIDED BY INSTALLER PRIOR TO ISSUANCE OF SEPTIC PERMIT (2) PUMP PERFORMANCE TEST IS NECESSARY PRIOR TO HEALTH DEPARTMENT APPROVAL OF SEPTIC PERMIT


**BUILDING PERMIT SIGNED
AND RETURNED 4/18/02
DECK + GAZEBO**

**BUILDING PERMIT SIGNED
AND RETURNED 7-3-02
600137311 - FINISH REELEN**

P 514710-F

NEITHER THE HOWARD COUNTY COUNCIL NOR THE HEALTH DEPARTMENT IS RESPONSIBLE FOR THE SUCCESSFUL OPERATION OF ANY SYSTEM
PERMITTEE RESPONSIBLE FOR OBTAINING FINAL APPROVAL ON THIS PERMIT
CALL 410-313-2640 FOR INSPECTION OF SEPTIC SYSTEM

NOT TO SCALE

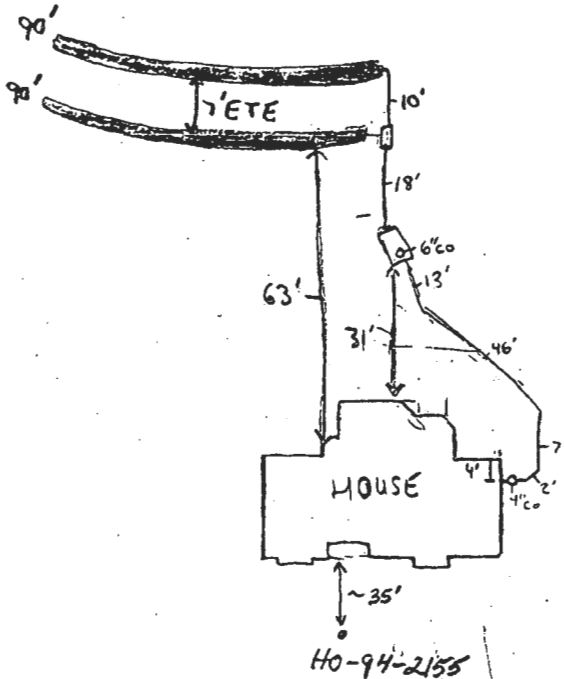

TRENCH DATA

TRENCH WIDTH 3'
 TRENCH INLET DEPTH 2'
 TRENCH BOTTOM DEPTH 6'
 DEPTH OF STONE 4'
 NUMBER OF TRENCHES 2
 TOTAL TRENCH LENGTH 180'
 ABSORBENT AREA 180 ft²
 DISTRIBUTION BOX LEVEL
 BAFFLE IN DISTRIBUTION BOX

SEPTIC TANK DATA

SEPTIC TANK 1250 TS GALLONS
 BAFFLES IN NA
 MANHOLE RISER NA
 6 INCH INSPECTION PORT

PUMP CHAMBER DATA

PUMP CHAMBER NA
 GALLONS NA
 MANHOLE RISER NA
 ALARM NA
 PUMP PERFORMANCE TEST NA

Fox Creek Court
 PRE-CONSTRUCTION INSPECTION: 1/11/01 Went over layout. (BB)
 BUILDING PERMIT SIGNED AND RETURNED

INSPECTION COMMENTS: 1/11/01 Tank O.K. (BB) 1/12/01 - OK TO COVER ALL WORK (SRK)

BUILDING PERMIT SIGNED
 AND RETURNED

INSPECTOR Steven R. Krieg DATE SYSTEM APPROVED 1/12/01