

Retest

APPLICATION

SEWAGE DISPOSAL TESTING

STATE OF MARYLAND - DEPARTMENT OF HEALTH AND MENTAL HYGIENE

HOWARD COUNTY HEALTH DEPARTMENT
ENVIRONMENTAL HEALTH SERVICES
P O BOX 473 ELLICOTT CITY, MARYLAND 21043
TELEPHONE 992-2330

A 31513

P 5th

DISTRICT 5th

DATE 7/22/71

TO THE COUNTY HEALTH OFFICER
ELLICOTT CITY, MARYLAND

I HEREBY APPLY FOR THE NECESSARY TEST IN ORDER TO CONSTRUCT (OR RECONSTRUCT) A SEWAGE DISPOSAL SYSTEM

PROPERTY OWNER Mr & Mrs Wm. Steckman, Jr.

ADDRESS 13520 ARGO DR. - DAYTON, Md 21036 PHONE 988-9967

PROPERTY LOCATION:

SUBDIVISION LINCOLN CHAPEL HILL LOT NO 13

ROAD AND DESCRIPTION same

SIZE OF LOT 115 x 349 x 458 x 49 x 180 TYPE BLDG 4
(NUMBER OF BEDROOMS)

THE SYSTEM INSTALLED UNDER THIS APPLICATION IS ACCEPTABLE ONLY UNTIL PUBLIC FACILITIES BECOME AVAILABLE. I FULLY UNDERSTAND THE

FEE CONNECTED WITH THE FILING OF THIS PERC TEST APPLICATION IS NON-REFUNDABLE UNDER ANY CIRCUMSTANCES. I ALSO AGREE TO COMPLY

WITH ALL M.O.S.H.A. REQUIREMENTS IN TESTING THIS LOT. [Signature]
(SIGNATURE OF APPLICANT)

APPROVED BY _____ FOR _____ DATE _____


REJECTED BY _____ FOR _____ DATE _____

HOLD PENDING FURTHER TESTS _____ DATE _____

REASONS FOR REJECTION OR HOLDING 7/27/71 Retest to allow for swimming pool on S.S.

THIS IS NOT A PERMIT

Rock out CRGPA
N/13 / Rock out map plus

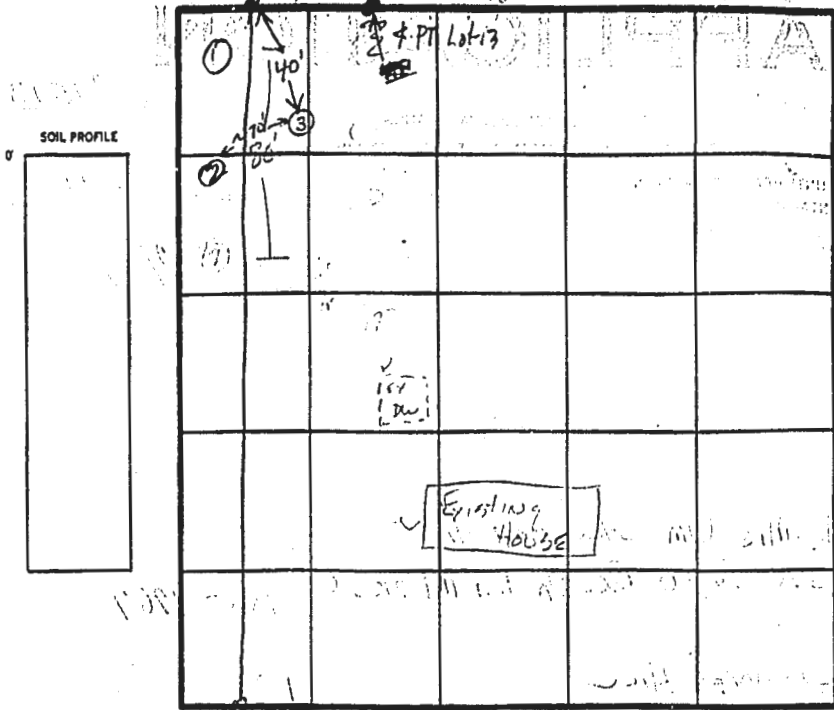

INDICATE NORTH - NAME ADJOINING ROADWAY AS BASE LINE

| DATE | TEST NO. | DEPTH | PRE-WET | | TEST - 1" DROP | | TIME |
|---------|----------|-----------------------------------|---------|-------|----------------|------|------|
| | | | START | STOP | START | STOP | |
| 7/27/81 | 1 S D | ROCK | n + 7 | | | | |
| | 2 S D | 3' Solid Rock at 8' | 10: | 11:00 | 11:00 | | |
| 7/27/81 | 3 | 11' Clay to 2-3' sandy loam below | | | | | |
| | | | | | | | |
| | | | | | | | |
Three
Holes
wet gr
Lap
9-11'
OK. J.S.


EH-12-1079

REMARKS _____

TYPE OF SOIL _____

TESTED BY SK 7/27/81

ALSO PRESENT Mont Speed
Maryland Pools

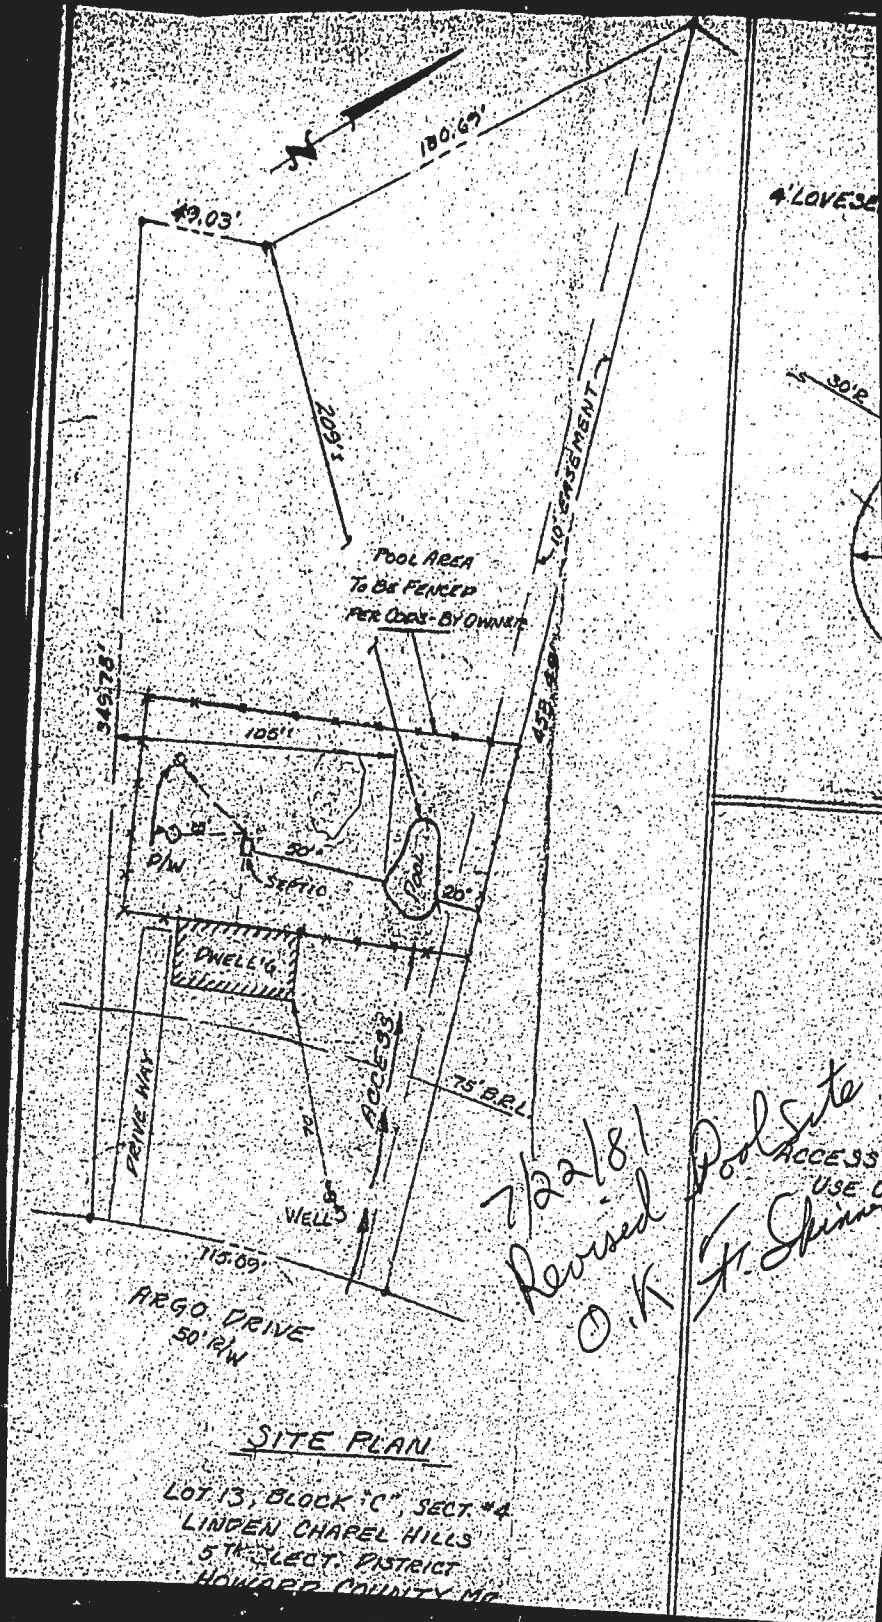

SITE PLAN

LOT 13, BLOCK "C", SECT. #4
 LINDEN CHAPEL HILLS
 5TH ELECT. DISTRICT
 HOWARD COUNTY, MD.

2/22/81
 Revised
 O.K.
 Pool Site
 ACCESS
 USE G.
 F. Skinner